

FOUNDATION NOTES

1. Design Information and Loads

- A. Foundation design in accordance with 2018 International Building Code using the reactions provided by the metal building manufacturer for the following design criteria.
- B. Ground Snow Load 80 psf
Roof Snow Load 60 psf
- C. Wind Speed 115 mph
Exposure C
- D. Sps 0.409
- E. SDC C
- F. Frost Depth 4'-0"

2. Earthwork

- A. The foundation has been designed and the site soils should be prepared for the foundation, in accordance with the recommendations in the geotechnical investigation report by: Erika K. Hill, P.E. of NWCC, Inc.
2580 Copper Ridge Drive, Steamboat Springs, CO 80487
Phone: (970) 879-7888 Job Number: 22-12817
- B. Foundation Design Values
- i. Allowable Soil Bearing Pressure - 3500 psf
ii. Minimum Soil Bearing Pressure - 1500 psf
iii. Coefficient of Friction - 0.25 (Assumed)
iii. Passive Earth Pressure - 250 psf/ft of depth (Assumed)
- C. The site soils shall be prepared for the foundation in accordance with the geotechnical report referenced above. The contractor shall verify that soil under footings is suitable to support footings.
- D. It is the responsibility of the contractor to ensure that the depth of the bottom of the foundation is far enough below the adjacent grade to ensure adequate frost protection.

3. Concrete and Reinforcement

- A. Material Standards
- i. Concrete
- a. Footings: Exposure Classes F0, S0, W0, C0
f'c = 3000 p.s.i., max. w/cm ratio = 0.55
- b. Exterior Walls: Exposure Classes F1, S0, W0, C1
f'c = 3500 p.s.i., max. w/cm ratio = 0.55
- c. Interior Walls: Exposure Classes F0, S0, W0, C0
f'c = 3000 p.s.i., max. w/cm ratio = N.A.
- d. Interior Slabs: Exposure Classes F0, S0, W0, C0
f'c = 3500 p.s.i., max. w/cm ratio = 0.55
- e. Air content for Exposures F1-F3 must meet the requirements of Table 19.3.3.1 of ACI 318-14. Air-entraining admixtures shall conform to ASTM C260.
- f. Use Type II cement for Exposure Class S0. For Exposure Classes S1, S2 and S3 use Type II or Type V as required in Table 19.3.2.1 of ACI 318-14. Cement shall conform to ASTM C150
- g. Calcium Chloride admixture shall not be used in Exposures S2 and S3
- h. Normal weight aggregates - ASTM C33
- ii. Reinforcing
- a. Rebar - ASTM A615 Grade 60 (Fy = 60 ksi)
- b. Welded wire - ASTM A1064
- c. Epoxy/Adhesive - Simpson SET-XP (ICC-ES ESR-2508), Hilti RE-500V3 (ICC-ES ELC-3814), or Dewart Pure110+ (ICC-ES ESR-3298) unless noted otherwise in the drawings.
- iii. Anchor Rods/Bolts
- a. All anchor rods shall be cast-in-place headed anchor rods. Use of post-installed (epoxy, adhesive, expansion, screw, etc.) anchors is not allowed without written permission from MVE or unless specifically noted in the drawings.
- b. Steel column anchor rods/bolts - ASTM F1554 Grade 36 with ASTM A563 heavy hex nuts and hardened washers (unless noted otherwise)
- c. Wood framing anchors - ASTM A307 with A36 plate washers
- d. Headed stud anchors (HSA) - ASTM A108
- e. Deformed bar anchors (DBA) - ASTM A496
- f. Screw Anchors for jamps as indicated in the typical anchor rod schedule - Simpson Titen HD (ICC-ES ESR-2713), Hilti Kwik HUS-TZ (ICC-ES ESR-3027), or Dewart Screwbolt+ (ICC-ES ESR-2526)
- g. Use of hooked anchor rods/bolts is limited under the ACI and the IBC. Headed anchor rods/bolts must be used where indicated in the details.
- h. The symbols \varnothing A.R./ \varnothing A.B. as shown in the drawings indicate the center line of the anchor rod/bolt pattern, not the center line of any individual anchor rod/bolt.
- B. Detail reinforcing to comply with ACI 315 "Manual of Standard Practice for Detailing Reinforcing Concrete Structures" and the Concrete Reinforcing Steel Institute (CRSI) recommendations.
- i. Minimum clear concrete cover for reinforcement shall be as follows unless noted otherwise:
- a. Concrete cast directly against and permanently exposed to earth - 3"
- b. Concrete exposed to weather or earth:
1. #5 bars or smaller - 1 1/2"
2. #6 bars or larger - 2"
- c. Concrete not exposed to weather or in contact with the ground - 3/4"
- d. Slabs on grade - as shown in details, 3/4" min. from top of slabs not exposed to weather
- ii. Lap Splice Lengths with 1 1/2" minimum clear cover
- a. f'c = 2500-3500 p.s.i.


1. #6 and smaller - 49 bar diameters
2. #7 and larger - 76 bar diameters
- b. f'c = 4000 p.s.i. or greater
1. #6 and smaller - 38 bar diameters
2. #7 and larger - 60 bar diameters
- c. Increase lap splice lengths by 50% where epoxy coated bars are used.
- iii. Stagger splices in walls so that no two adjacent bars are spliced in the same location, unless shown otherwise.
- iv. Make all bars continuous around corners or provide corner bars of equal size and spacing.
- v. Where 12 inches or less of fresh concrete is placed below horizontal reinforcing lap splice length may be reduced by 30%.
- vi. Vertical bars in walls, grade beams, and piers to terminate in footings with ACI standard hooks (12 bar diameters) to within 4" of the bottom of the footing unless noted otherwise.
- vii. Horizontal wall reinforcing shall terminate at the ends of walls with a 90 degree hook plus a 6 bar diameter extension, unless shown otherwise.
- viii. Horizontal wall reinforcing shall be continuous through construction and control joints.
- ix. Splices in horizontal reinforcement shall be staggered. Splices in two curtains (where used) shall not occur in the same location.
- x. Use chairs or other support devices as required for proper clearance.
- xi. Rebar hairpins shall be centered in slabs and shall be wire tied to the slab reinforcing (if any). Rebar hairpins shall be continuous through walls and piers; lap splices in hairpins may only occur in the floor slab unless noted otherwise.
- C. Control joints in slabs on grade are recommended to control cracking. See plans for control joint spacing and details.
- D. Slabs and grade beams shall not have joints in a horizontal plane. All reinforcement shall be continuous through all construction joints.
- E. Floor slab thickness and reinforcing shown in these drawings are adequate to support typical uniform loads only. Mountain View Engineering has not designed the slab for any specific concentrated forces such as those from vehicles, storage racks, or heavy equipment (unless noted otherwise).
- F. Welding of rebar is not allowed unless specifically indicated in the drawings. All embedments, reinforcing, and dowels shall be securely tied to framework or to adjacent reinforcing prior to placement of the concrete. Tack welding of rebar joints in grade beams, walls, or cages is not allowed. Where welding of rebar is shown in the drawings, all rebar to be welded shall be ASTM A706 Grade 60.

4. Special Inspections


- A. Concrete
- i. Spot Footings - Not required (IBC 1705.3 Exception 1)
- ii. Continuous Ftgs. - Not required (IBC 1705.3 Exception 2.3)
- iii. Slabs - Not required (IBC 1705.3 Exception 3)
- iv. Grade Beams - Not required (IBC 1705.3 Exception 4)
- v. Walls - Not required (IBC 1705.3 Exception 4)
- vi. Anchor rods/bolts - Required (IBC Table 1705.3) Special inspection may be waived subject to the approval of the building official.
- B. Steel Reinforcement
- i. Placement - Third party special inspection of reinforcing placement need only be performed where specifically required by the building official.
- ii. Welding - Special inspection of rebar welding is required (if any is used).

5. Miscellaneous

- A. The contractor shall notify engineer of any variations in dimensions.
- B. The engineer is not responsible for any deviations from these plans unless such changes are authorized in writing by the engineer.

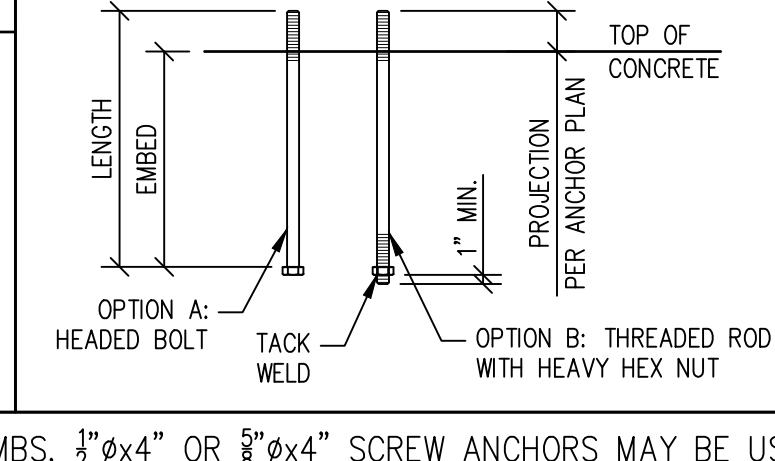TYPICAL ANCHOR ROD DIMENSIONS			
DIA.	EMBED		
3/8"	10"		TOP OF CONCRETE
1/2"	12"		
5/8"	14"		
3/4"	18"		
1"	22"		
1 1/8"	24"		
1 1/4"	24"		

*AT OPENING JAMBS, 1/2"x4" OR 5/8"x4" SCREW ANCHORS MAY BE USED IN LIEU OF CAST-IN-PLACE ANCHORS. OPENING JAMB ANCHORS ARE NOT SHOWN ON THIS DRAWING, SEE METAL BUILDING ANCHOR PLAN.

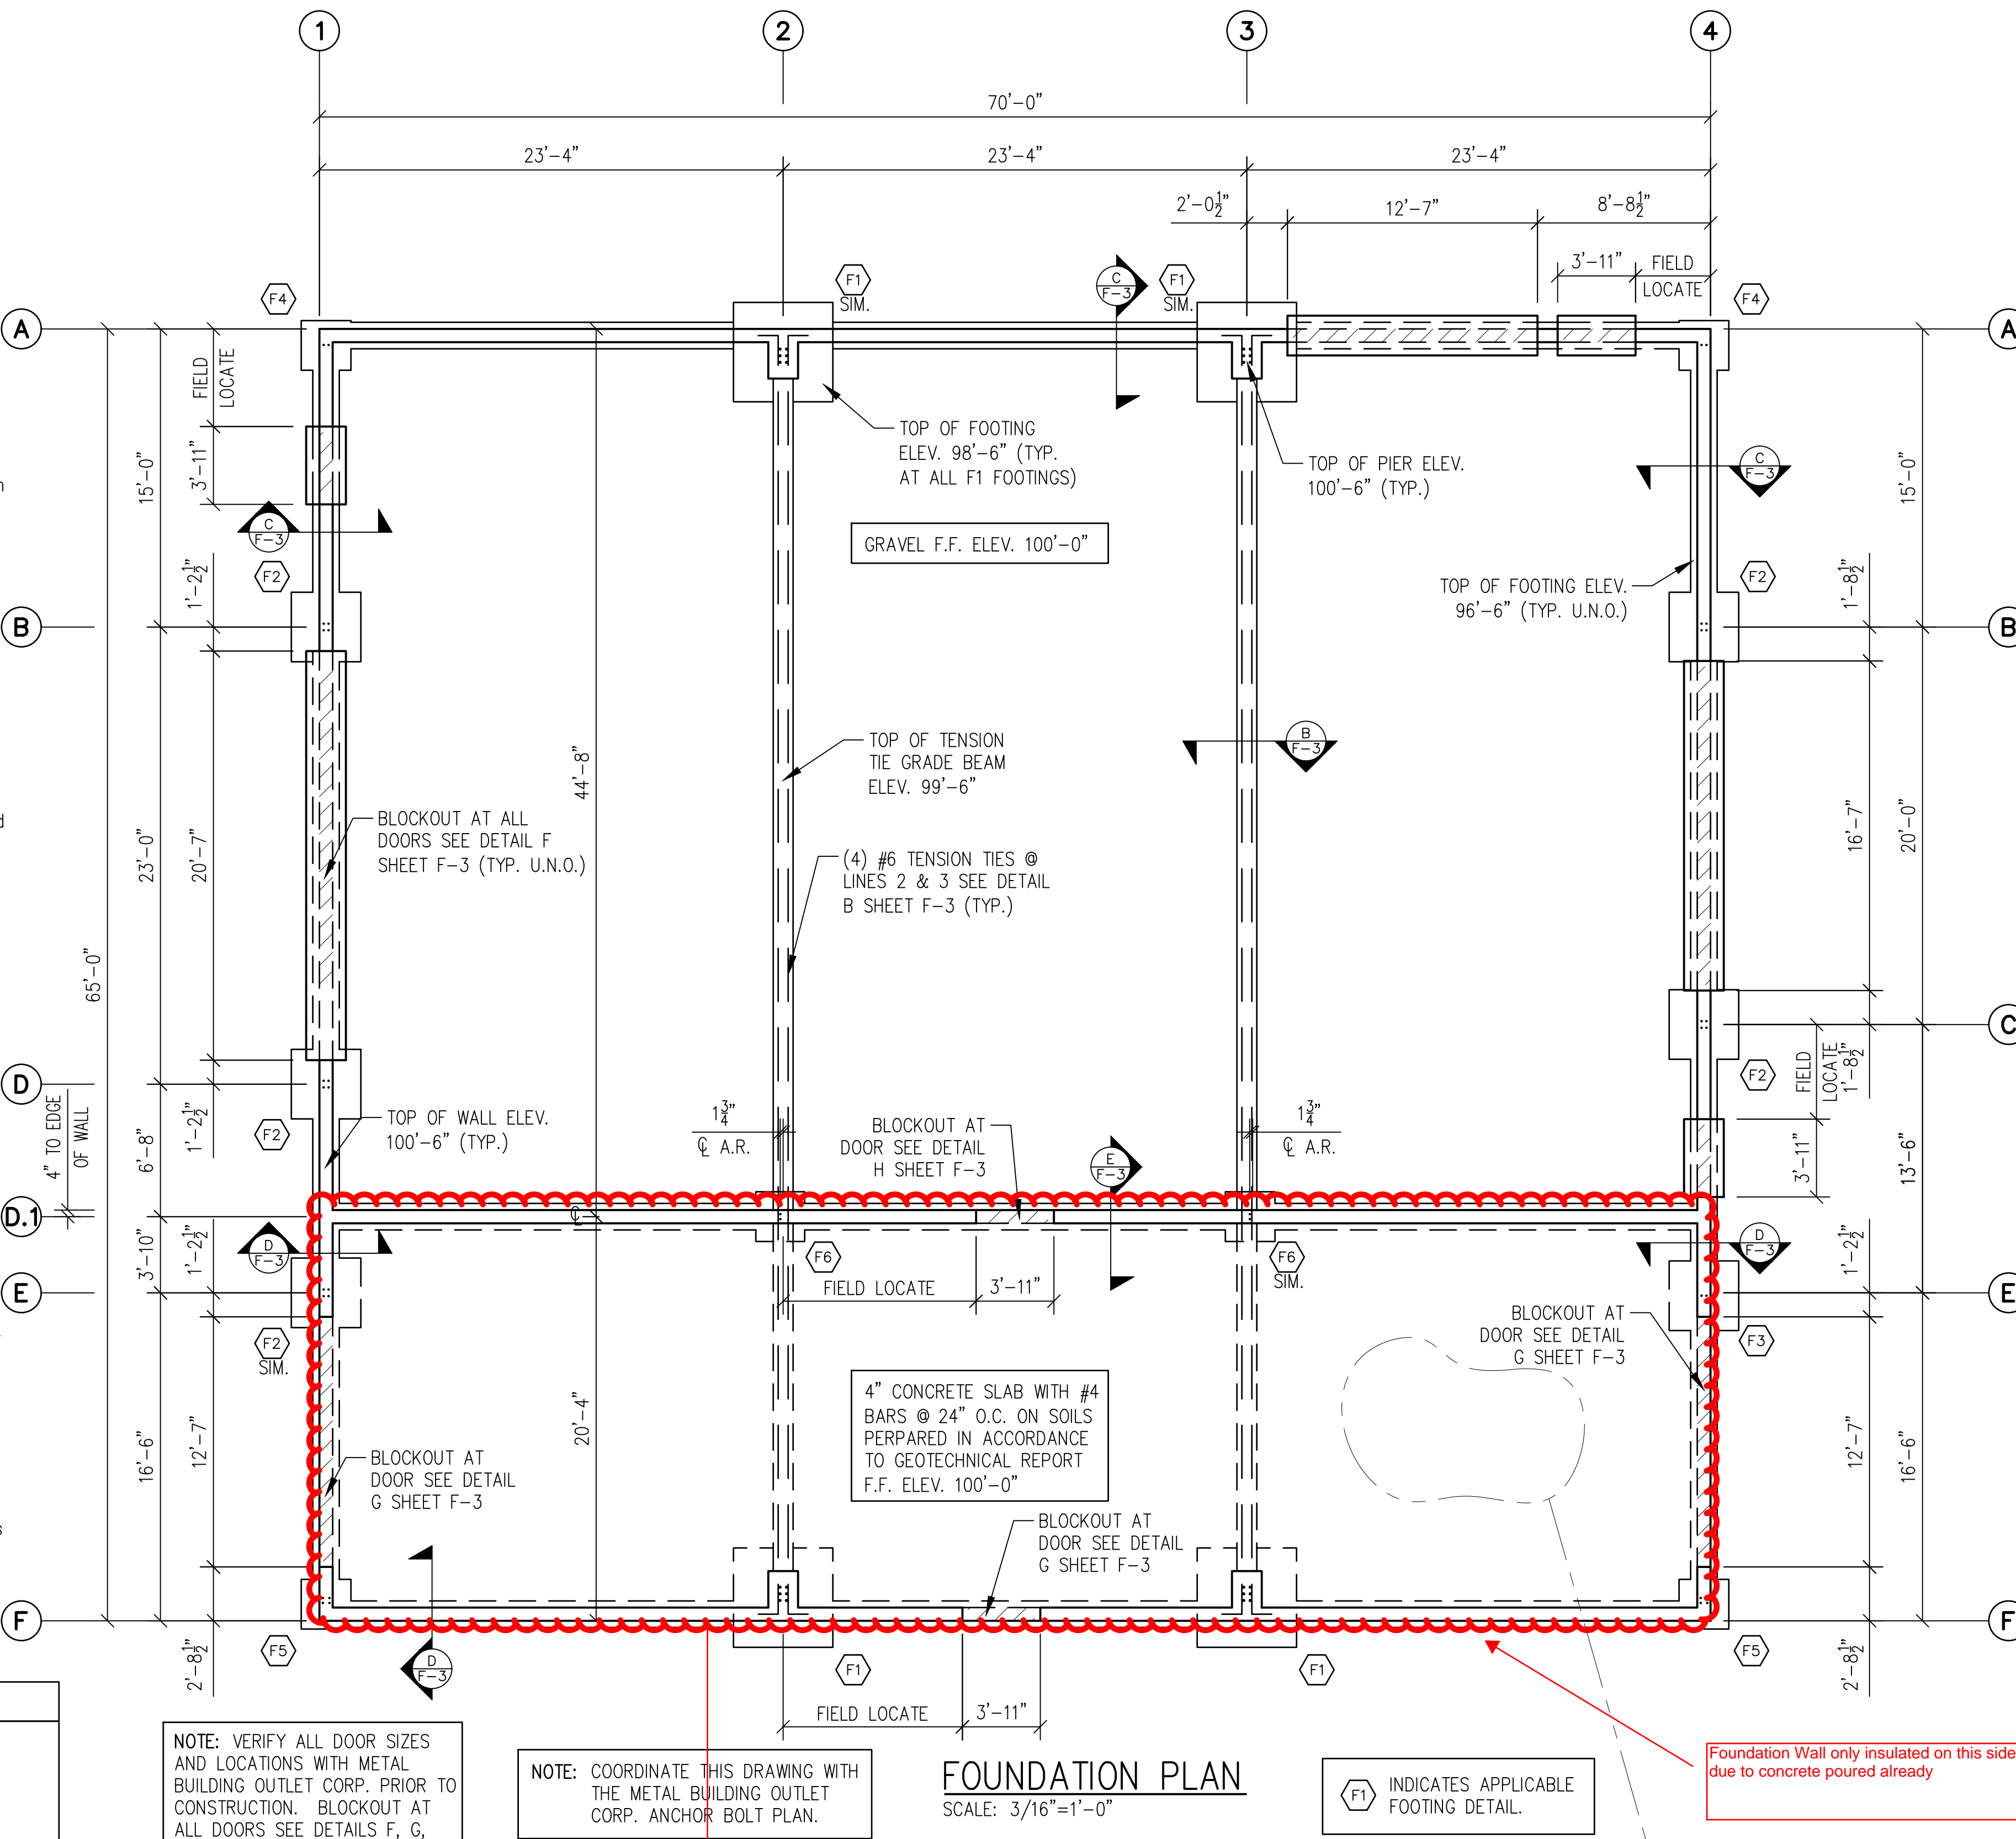

RCRBD Notes: The owner decided to heat this 1/3 portion of the building clouded in red ink above.

Foundation Wall R-15 installed for 24" below grade

Exterior Walls: Wall Options: R13 + R-13CI Or R-13 + R-7.5CI

Attic: R-49

Reviewed for Code Compliance

12/04/2023

REVIEWED FOR CODE COMPLIANCE

09/18/2023

MOUNTAIN VIEW ENGINEERING, INC.

Structural Engineering Consulting

345 North Main Street Ste. A, Brigham City, Utah 84302 (435) 734-9700 Fax (435) 734-9519

FOUNDATION PLAN

SHEET TITLE: CLAY HOCKEL C & B HOLDINGS

JOB NAME: HAYDEN, COLORADO

LOCATION: CONTRACTOR: -

PLAN ISSUE DATES

DATE	BY	DESCRIPTION
7-31-23	J.D.	FOR PERMIT

COLORADO LICENSED PROFESSIONAL ENGINEER

57594

JUL 31 2023

SHEET NUMBER:

F-1

DRAWN BY: J.D.

ENGINEER: B. COX

MVE JOB NUMBER: 23-0706