



CONSULTANTS

A
New
Residence
for
Black Dog
Holding, LLC

56010 Hannah's Way
CLARK
COLORADO
80428
PIN: 286800004


MARK	DATE	DESCRIPTION
SD	01/28/15	M-L HOA Sketch Plan Review
DD	03/19/15	Client Review
DD	04/06/15	Window/Door Pricing
CD	04/22/15	Prelim.Structural Review


PROJECT NO:
MODEL FILE:
DRAWN BY:
CHK'D BY:

SHEET TITLE

SITE PLAN


C-1.2

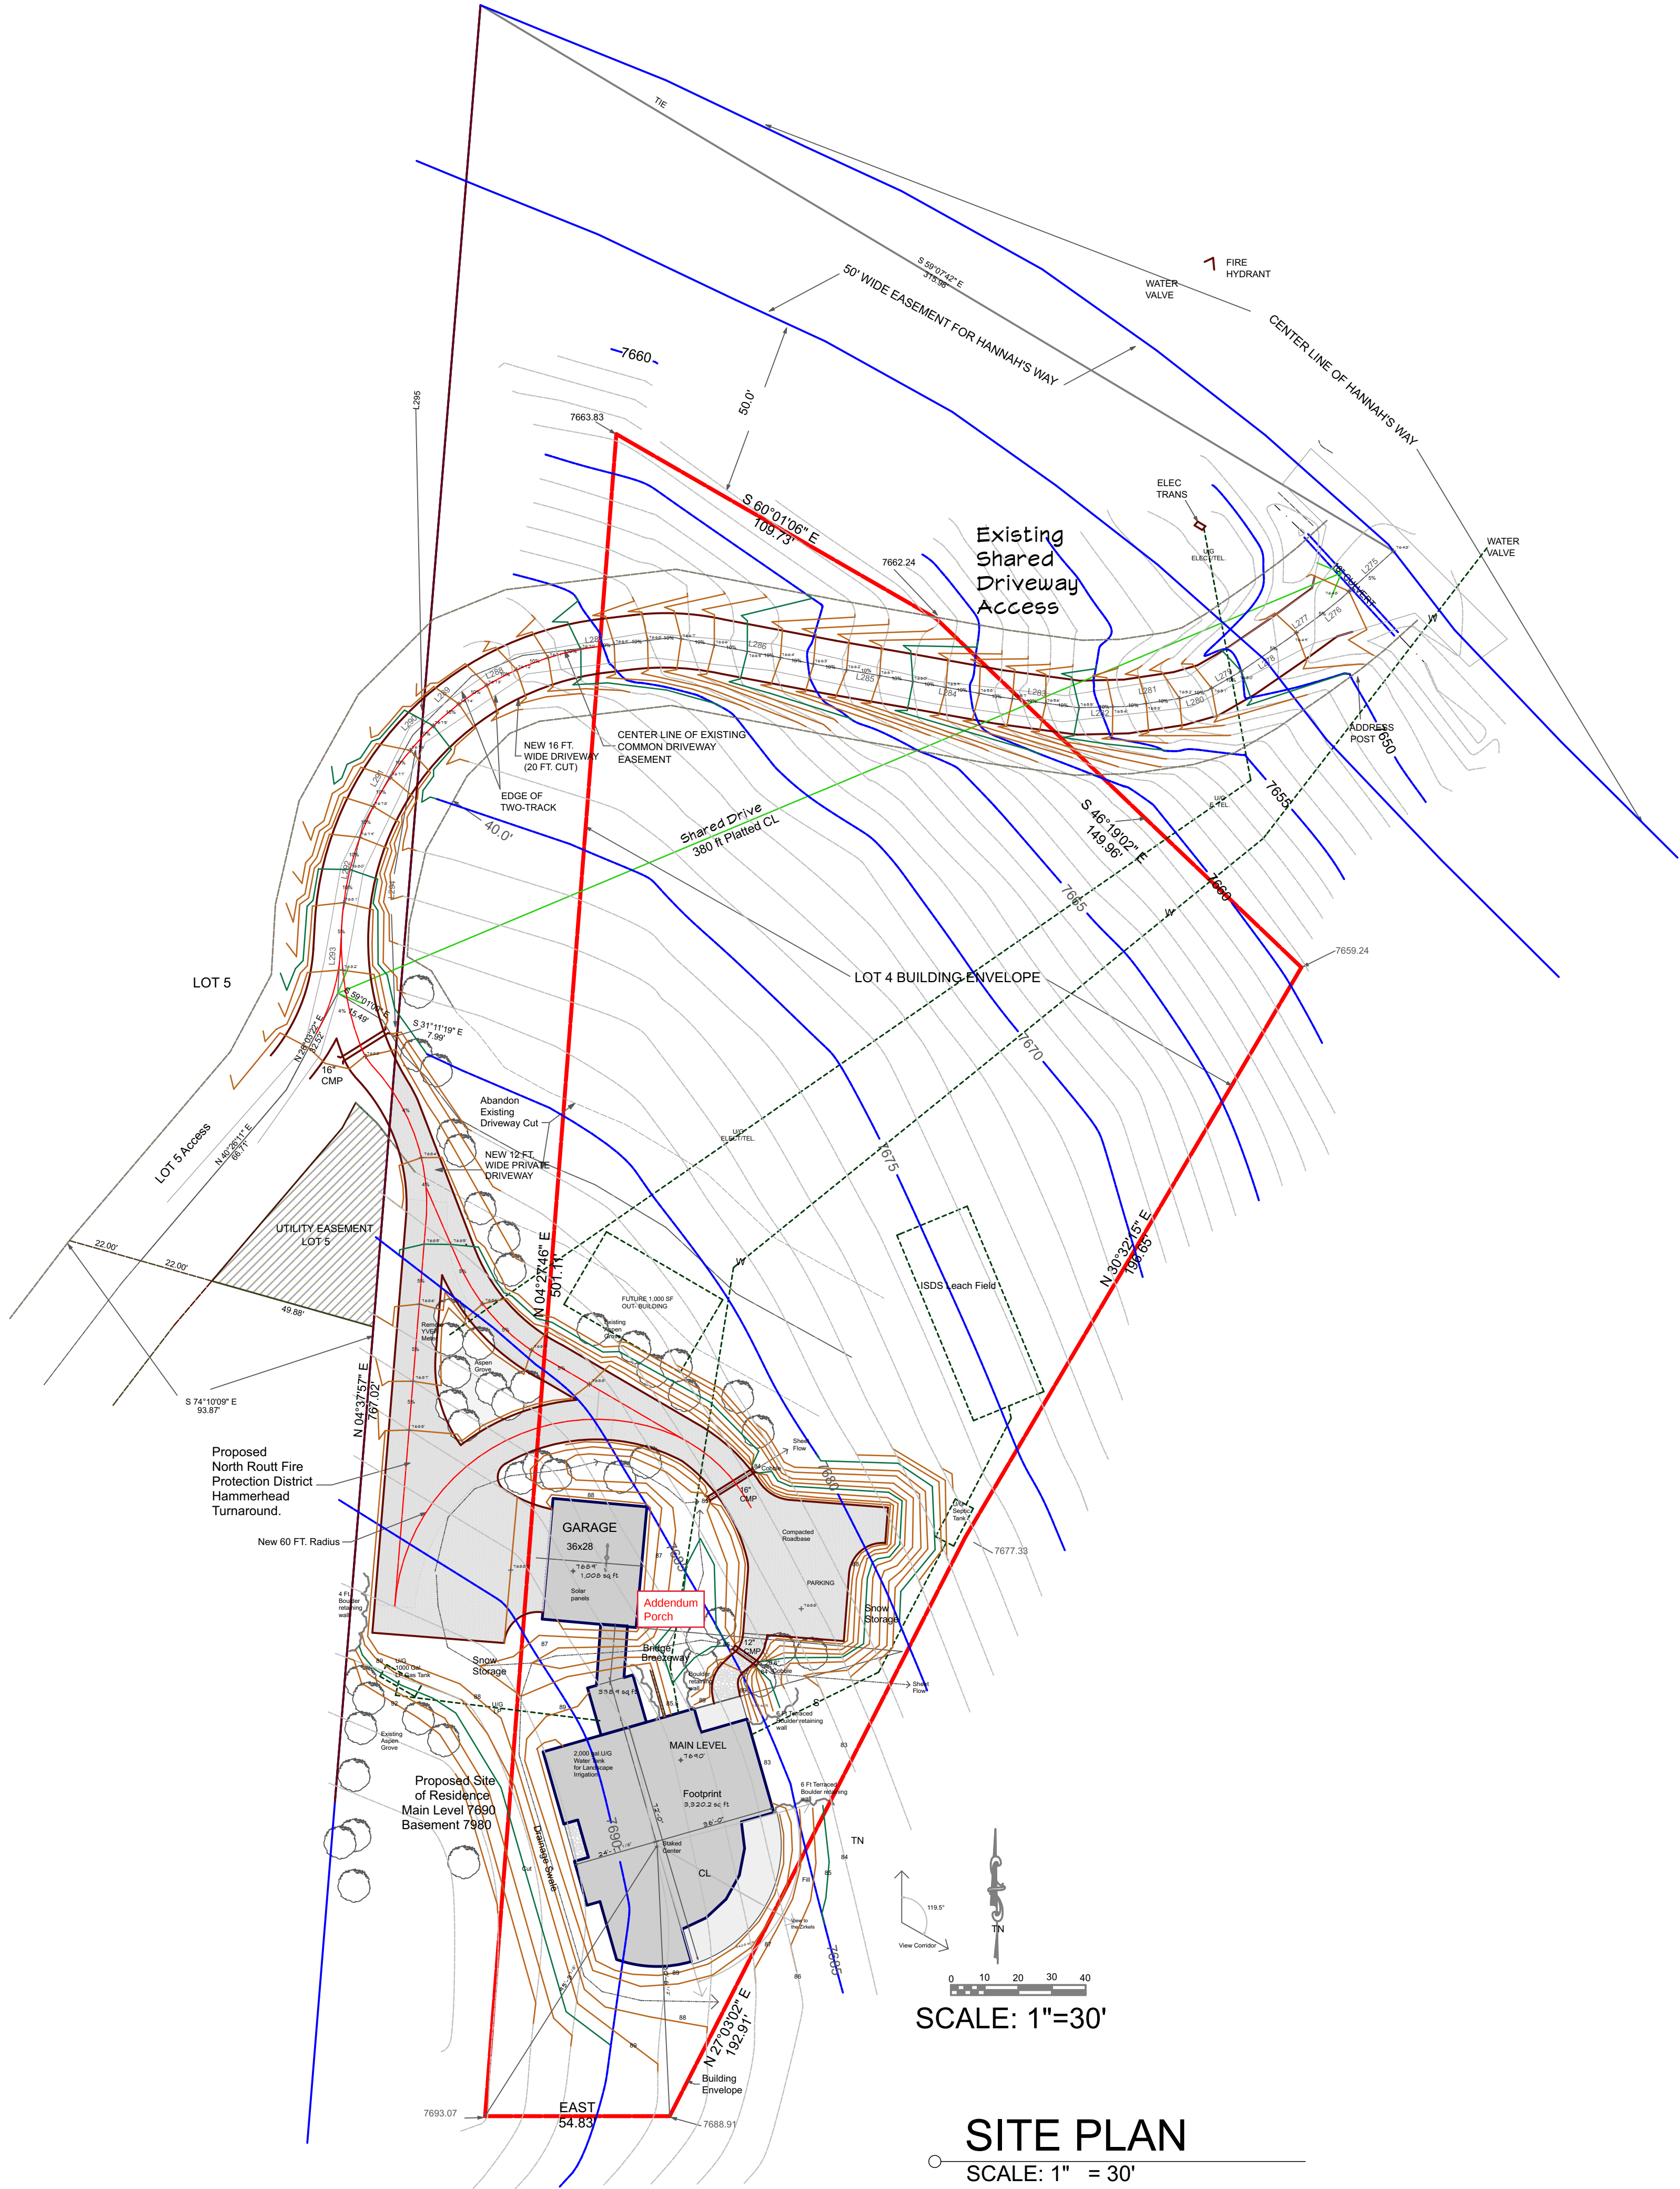

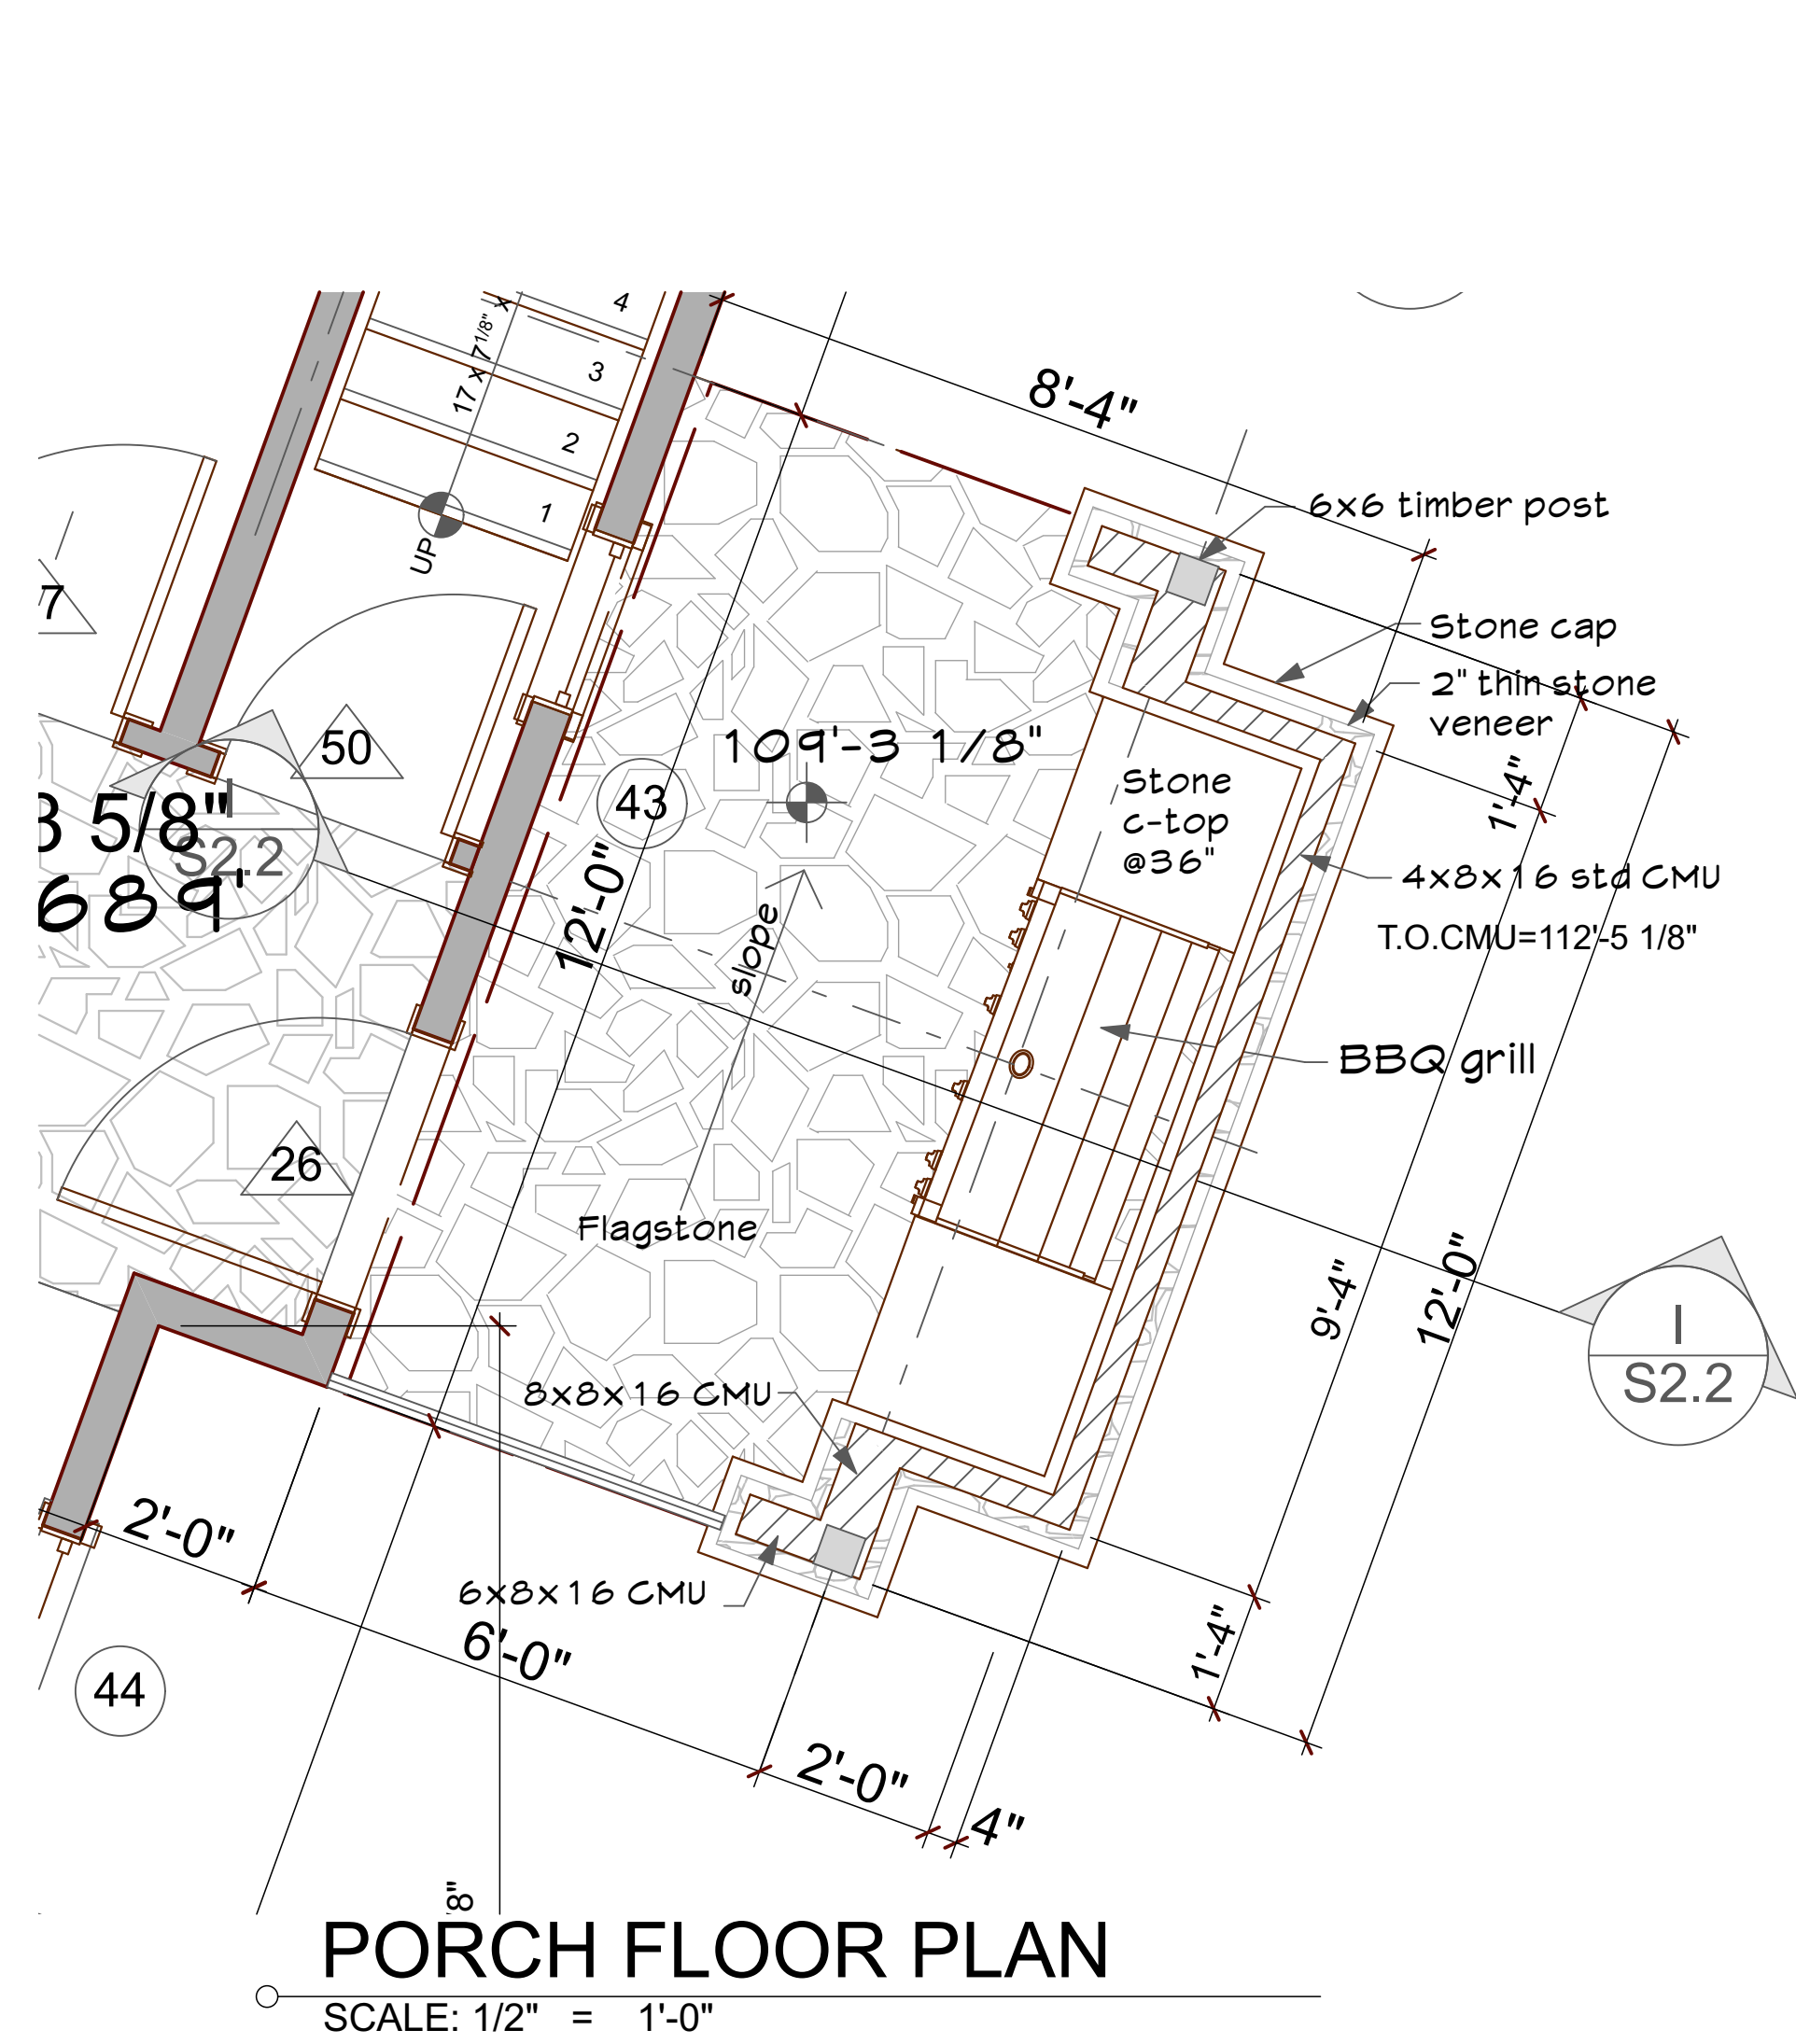


PORCH FLOOR PLAN

SCALE: 1/2" = 1'-0"

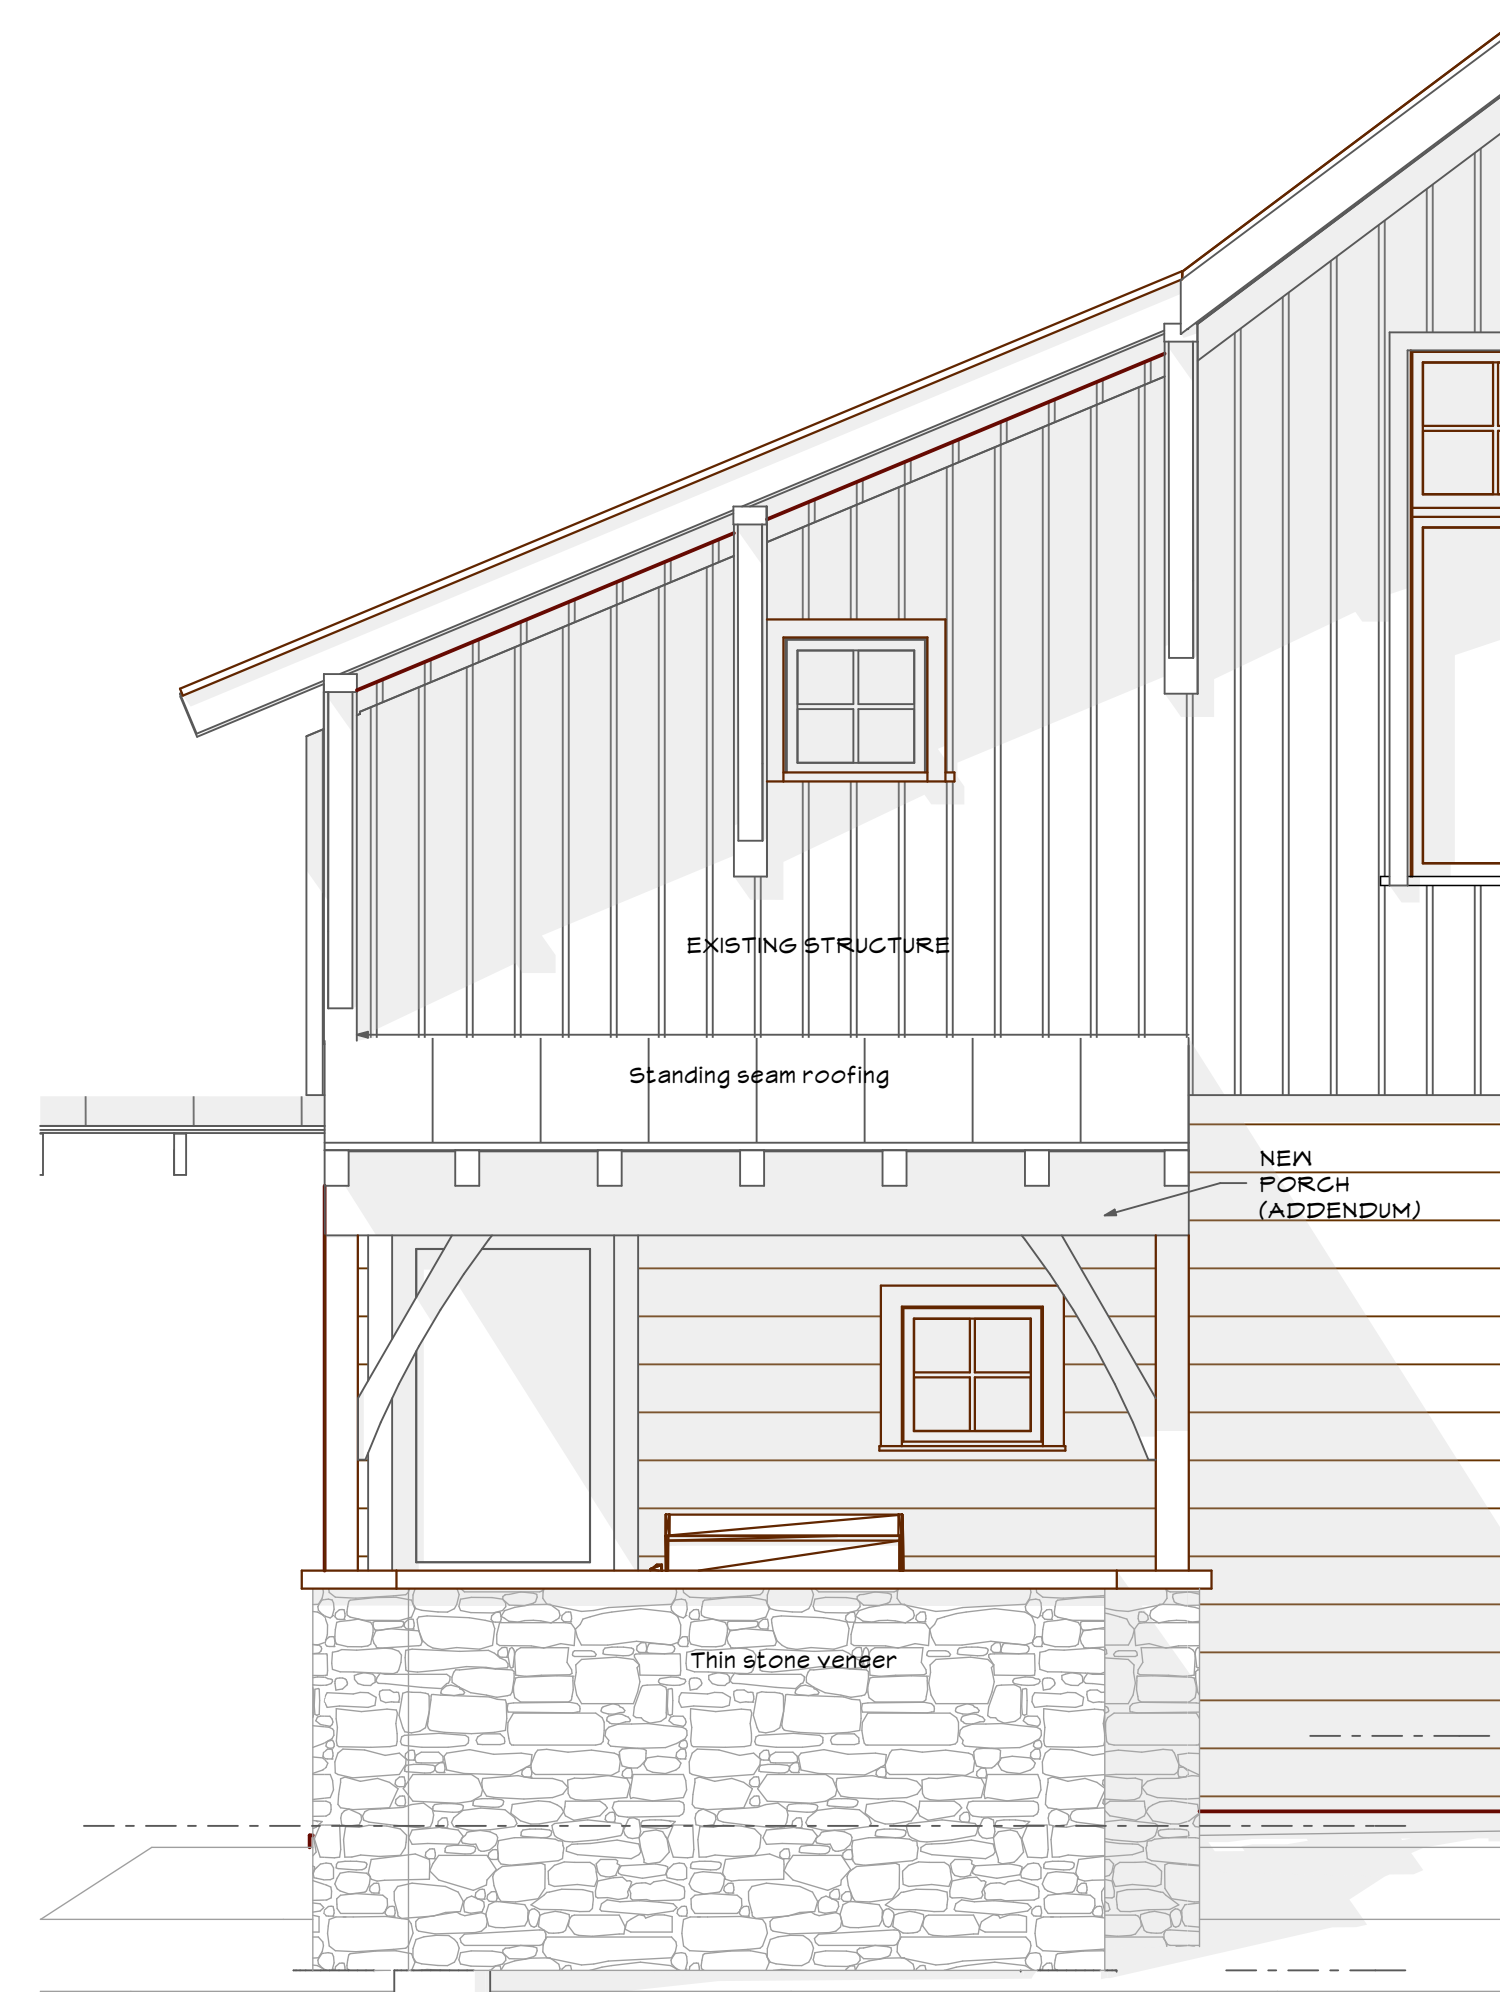


PORCH ELEVATION

SCALE: 3/8" = 1'-0"

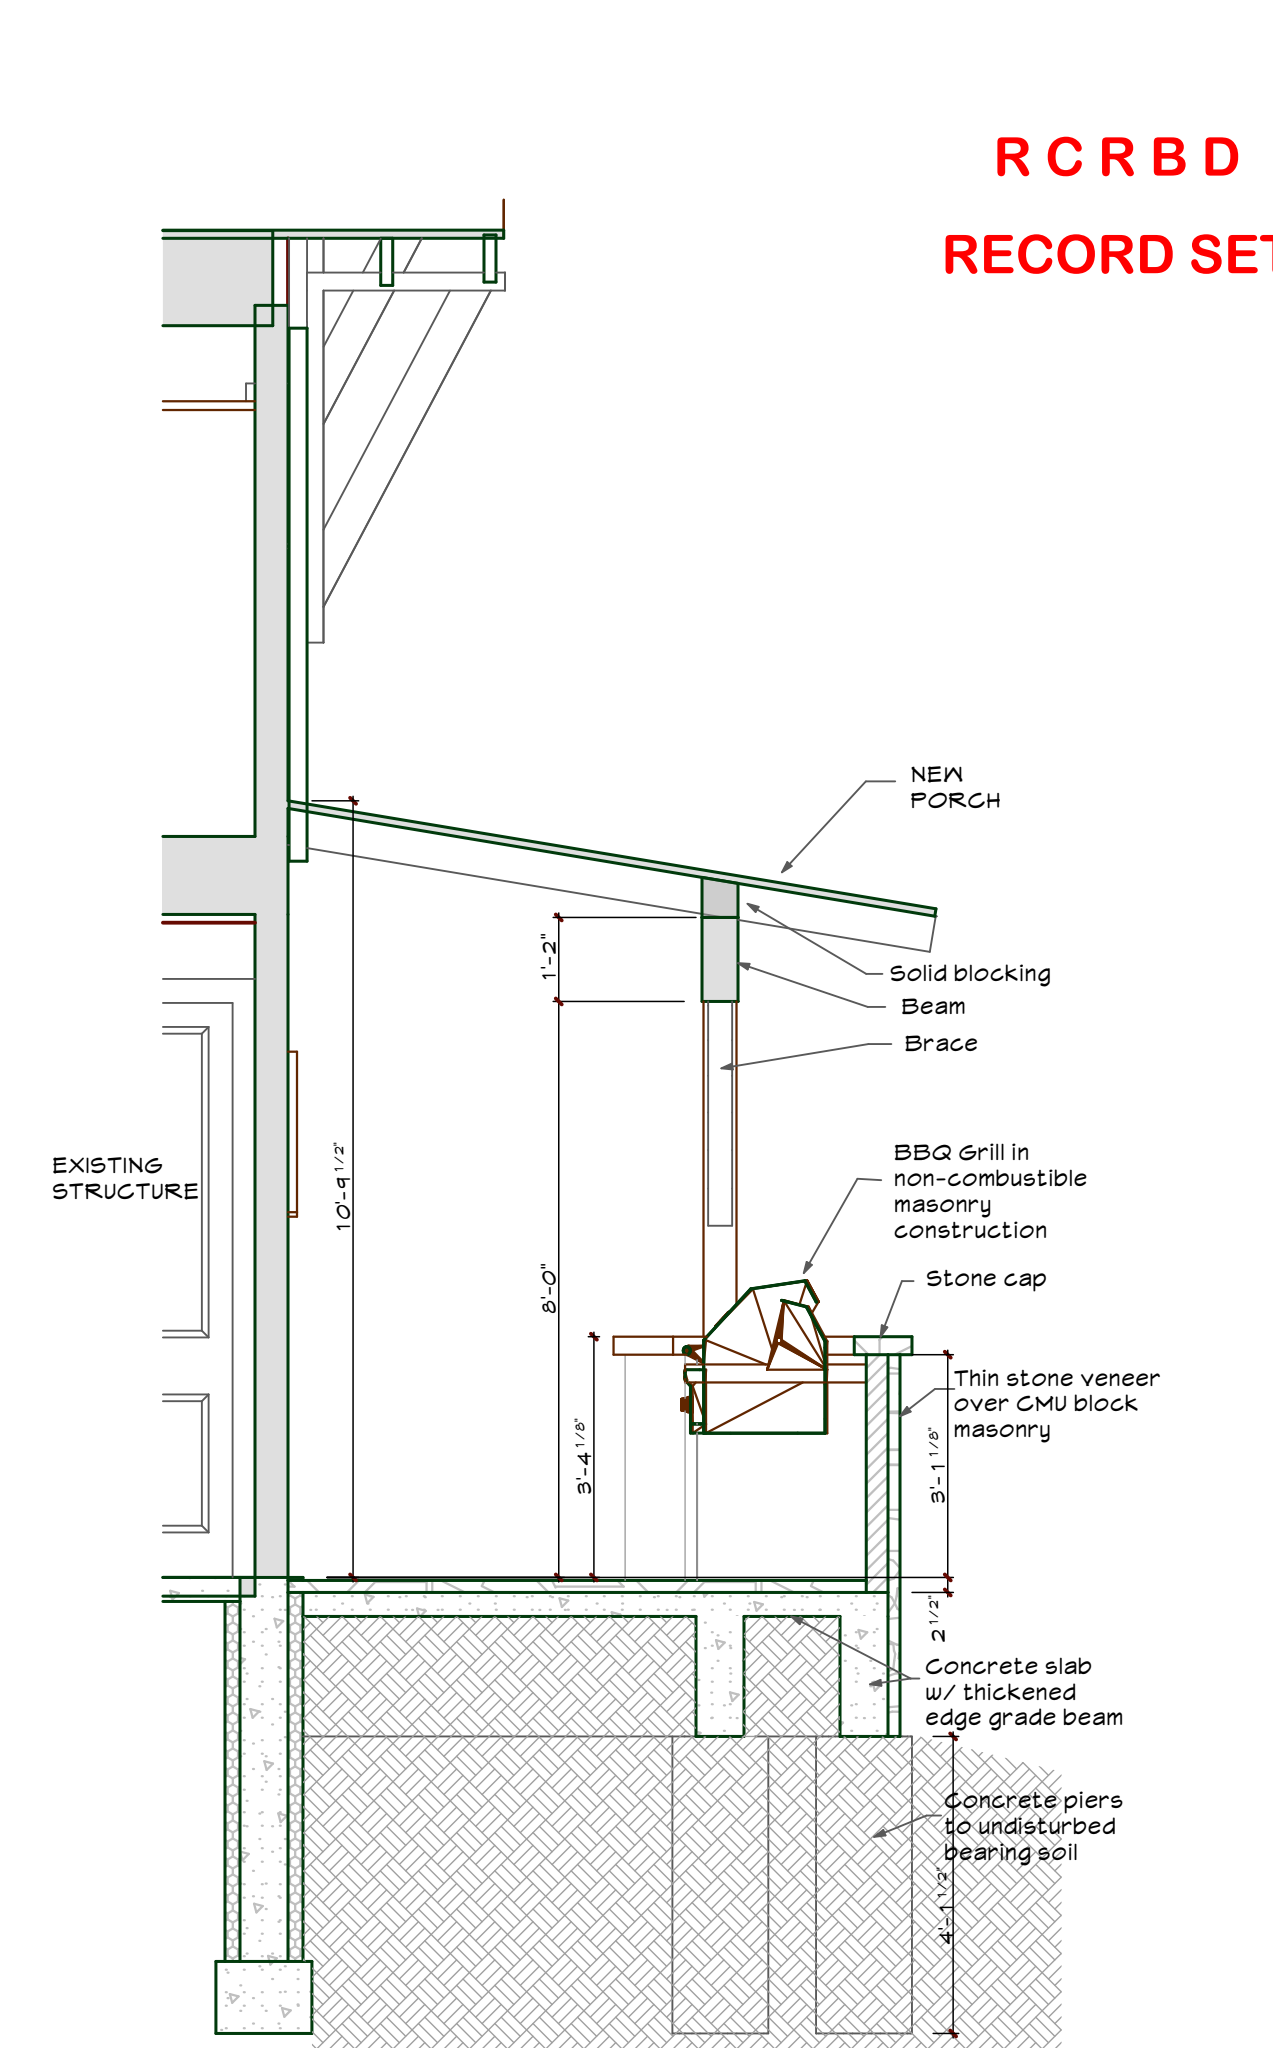


CROSS SECTION I-I

SCALE: 3/8" = 1'-0"

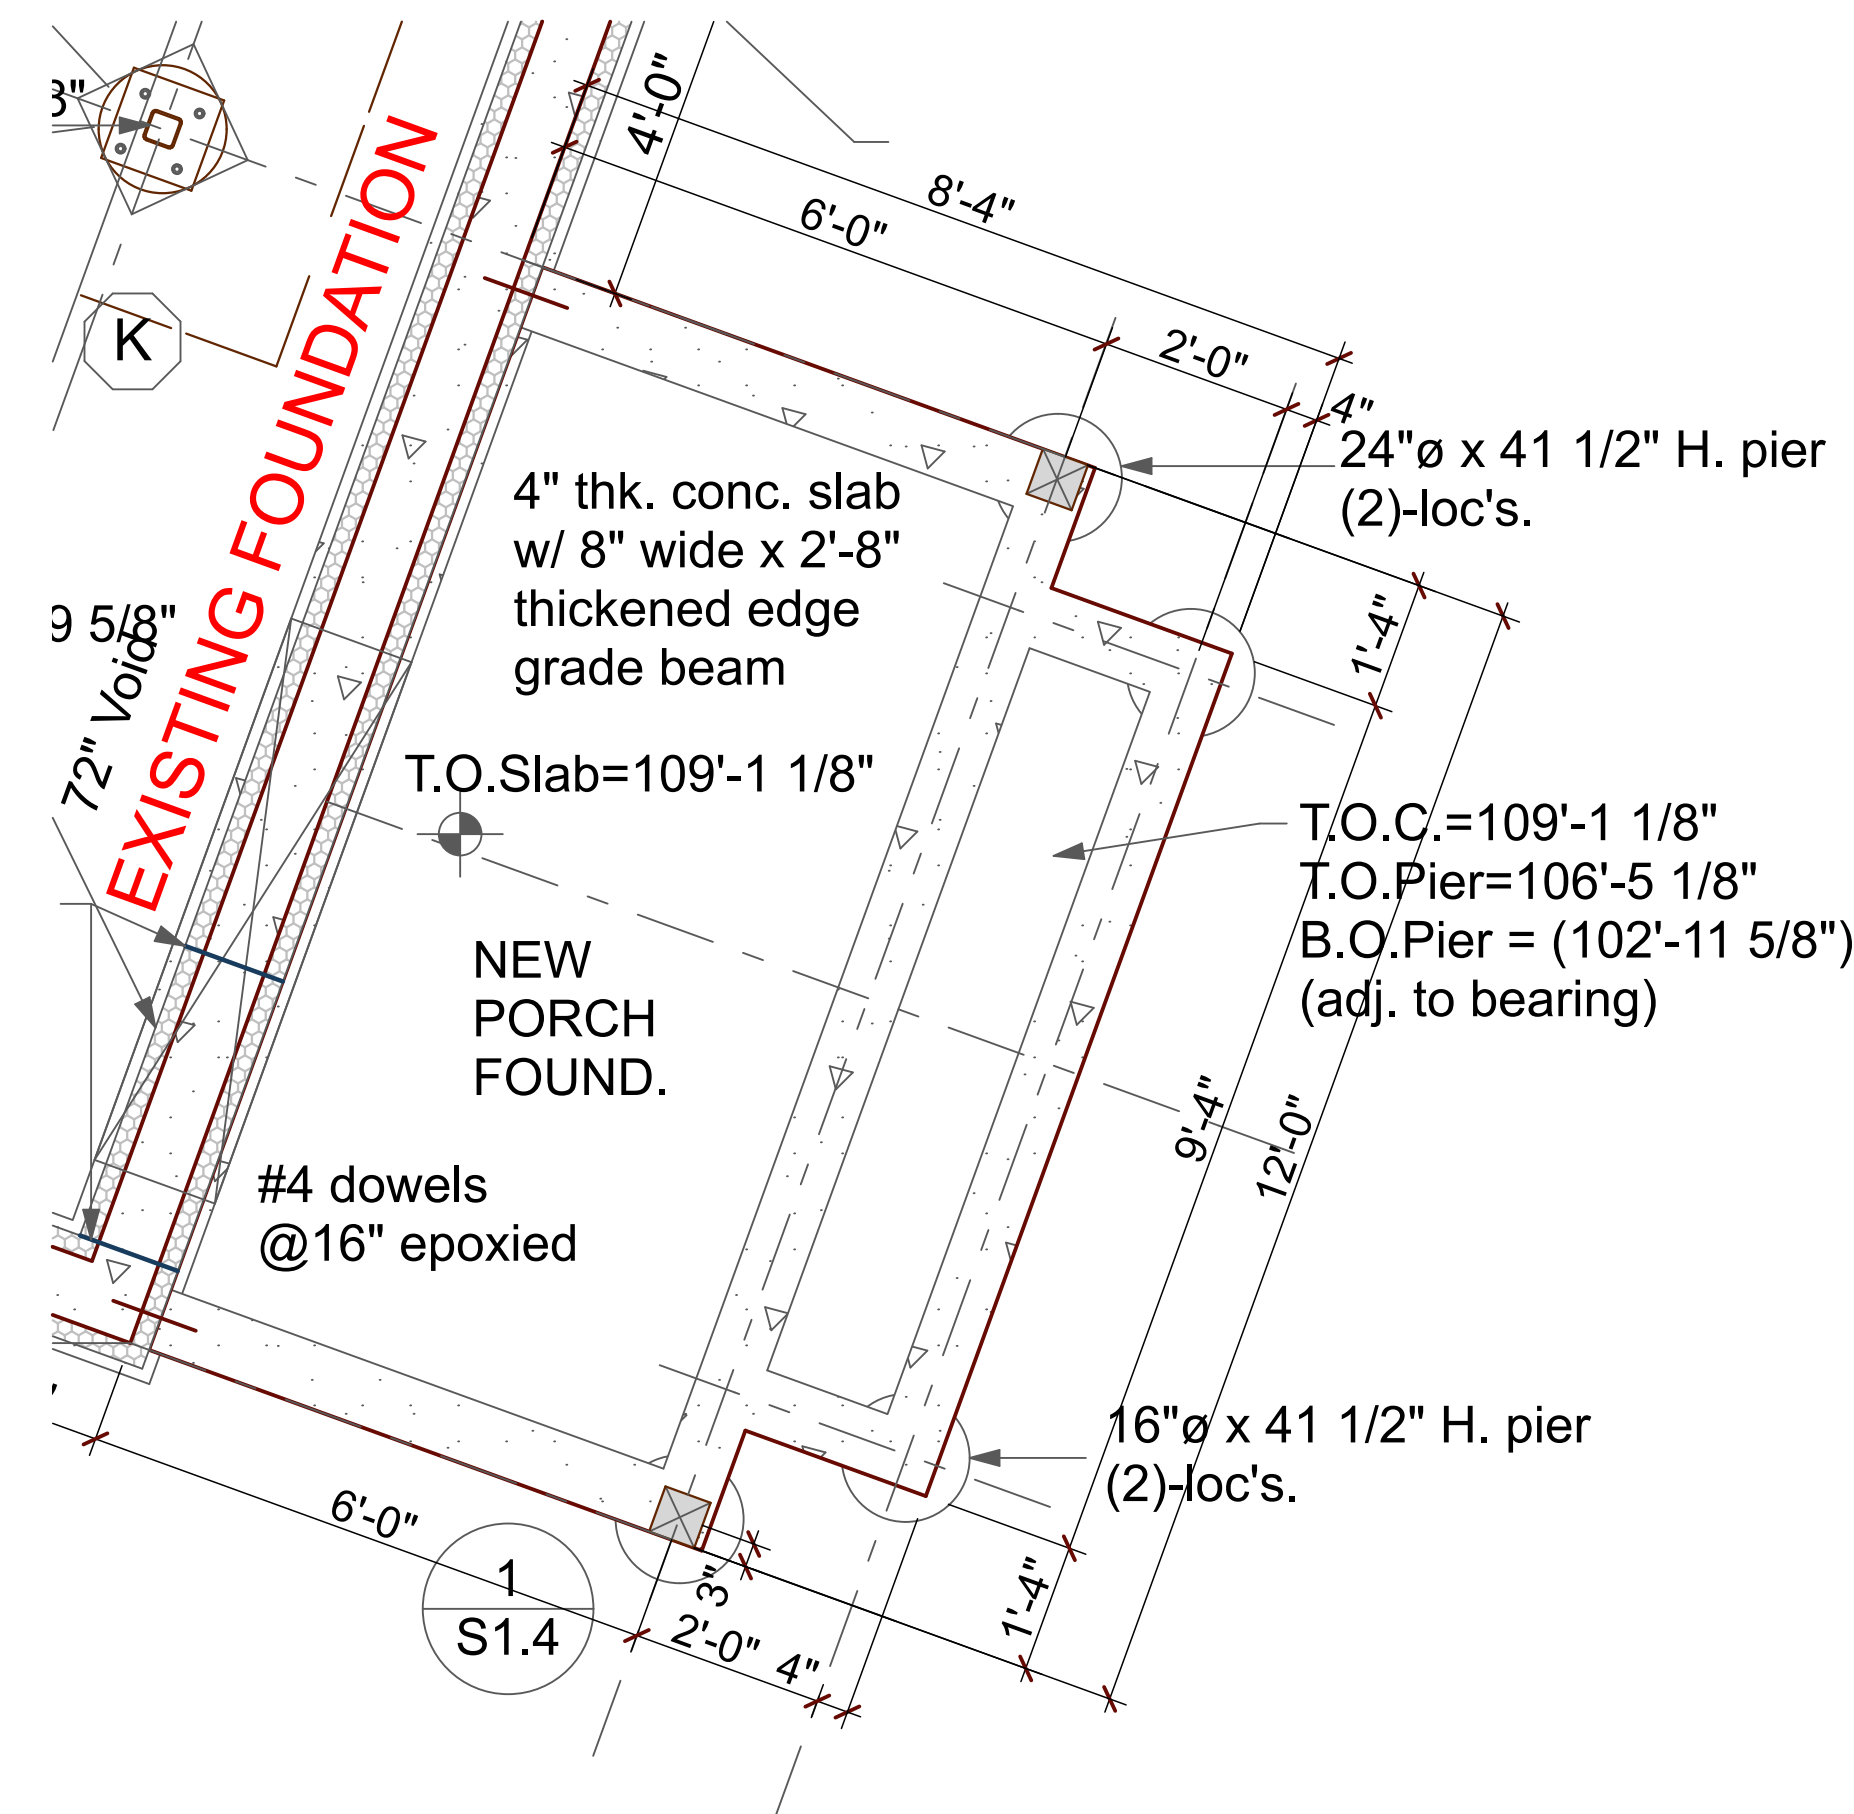


PORCH FOUNDATION PLAN

SCALE: 1/2" = 1'-0"

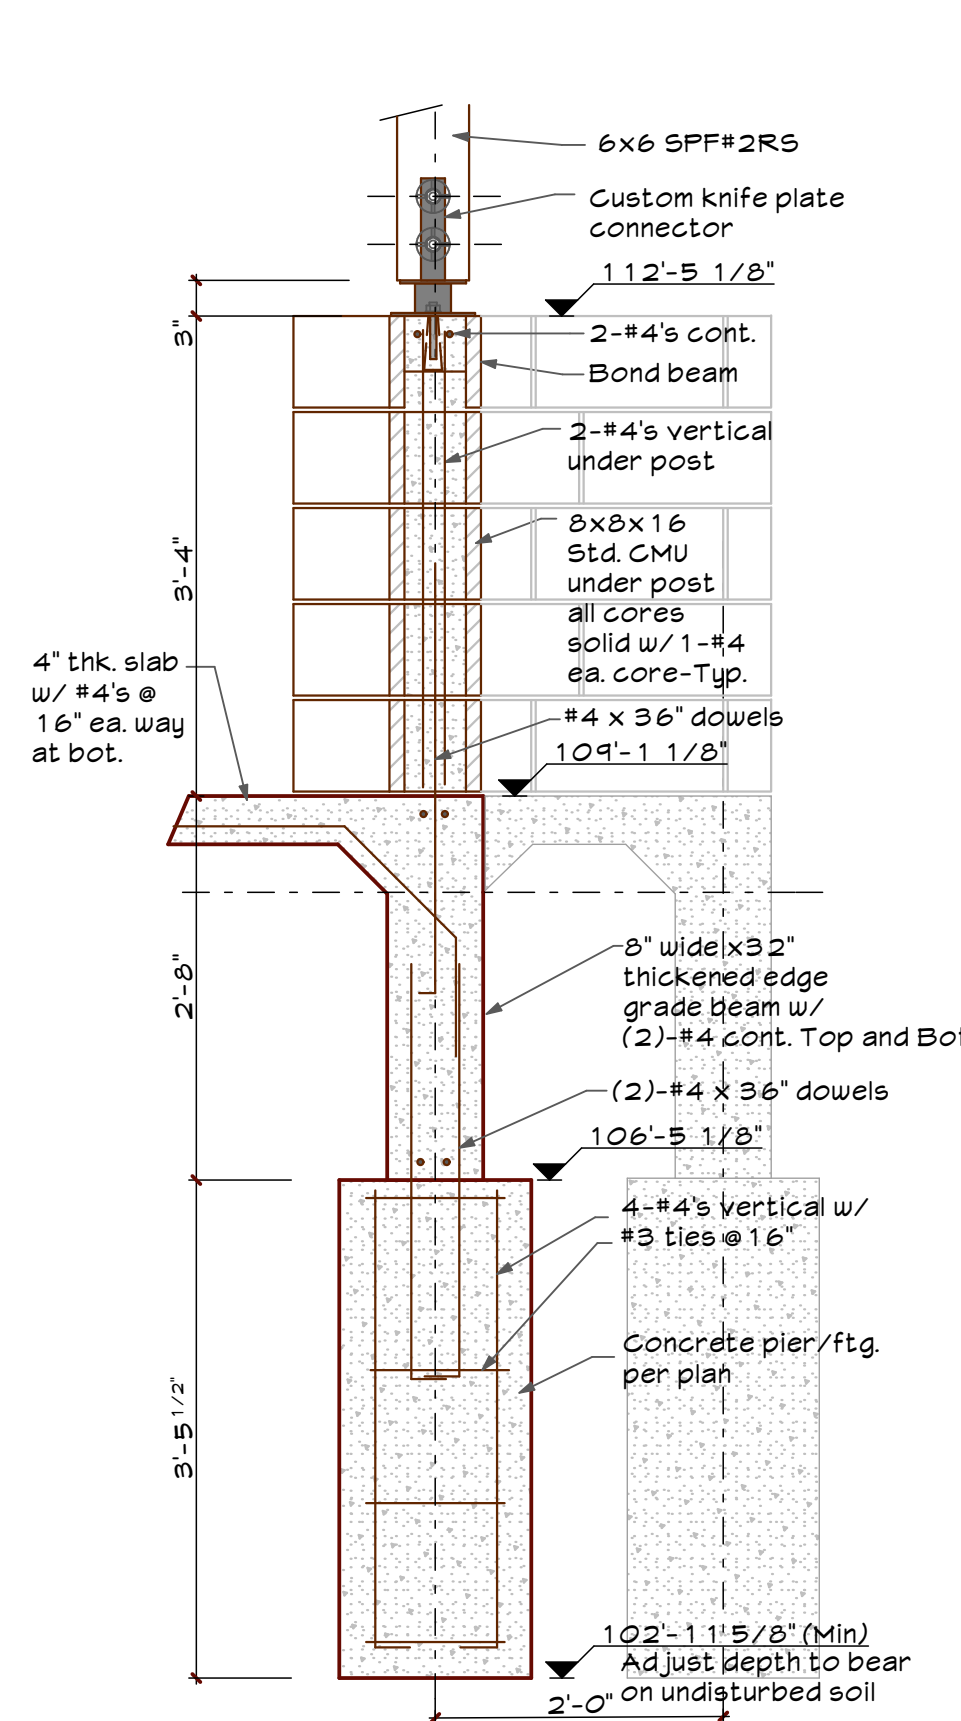


FOUNDATION DETAIL

SCALE: 3/4" = 1'-0"

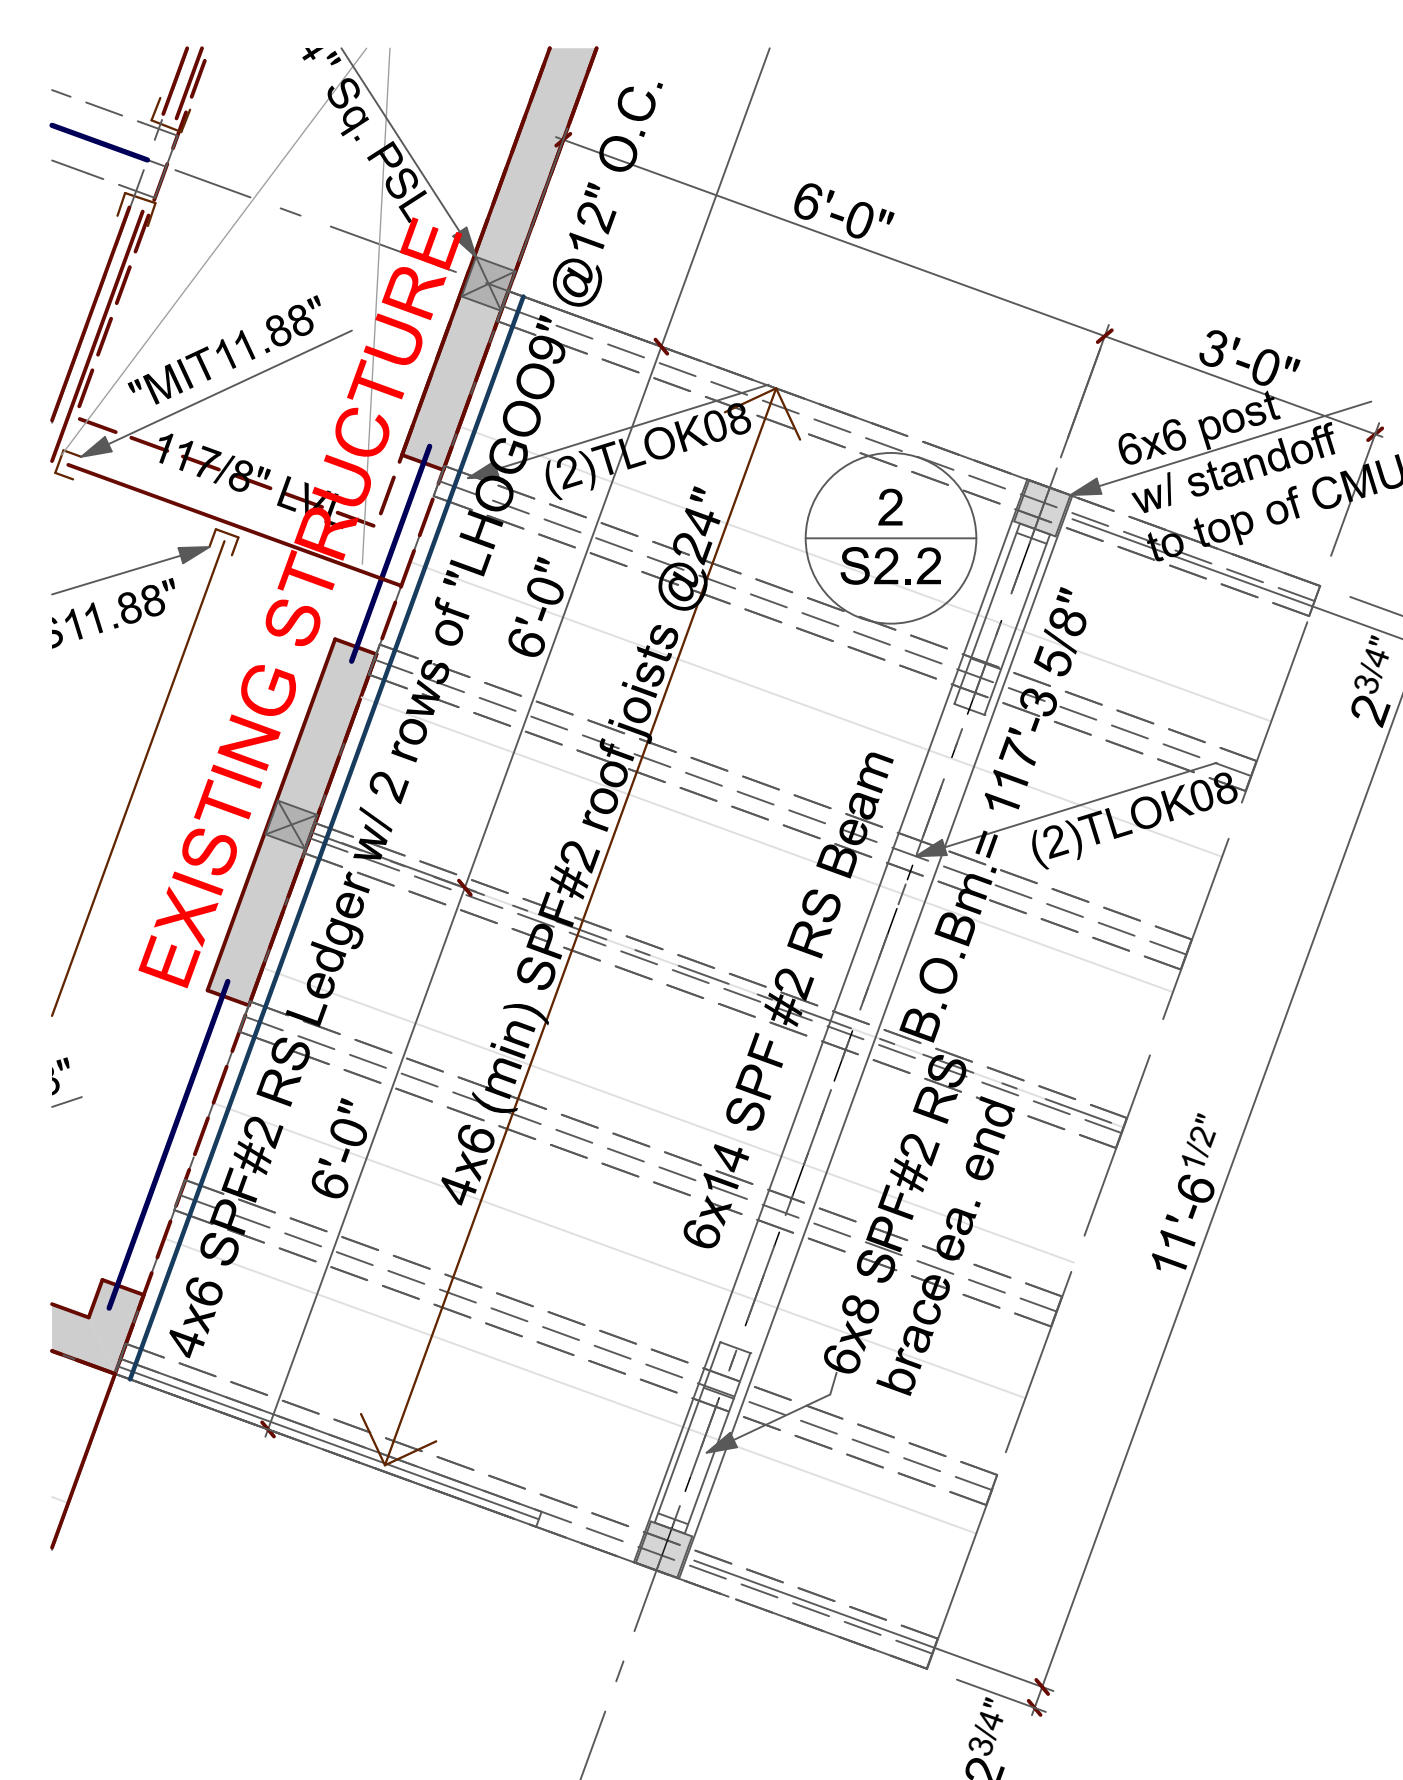

PORCH ROOF FRAMING PLAN

SCALE: 1/2" = 1'-0"

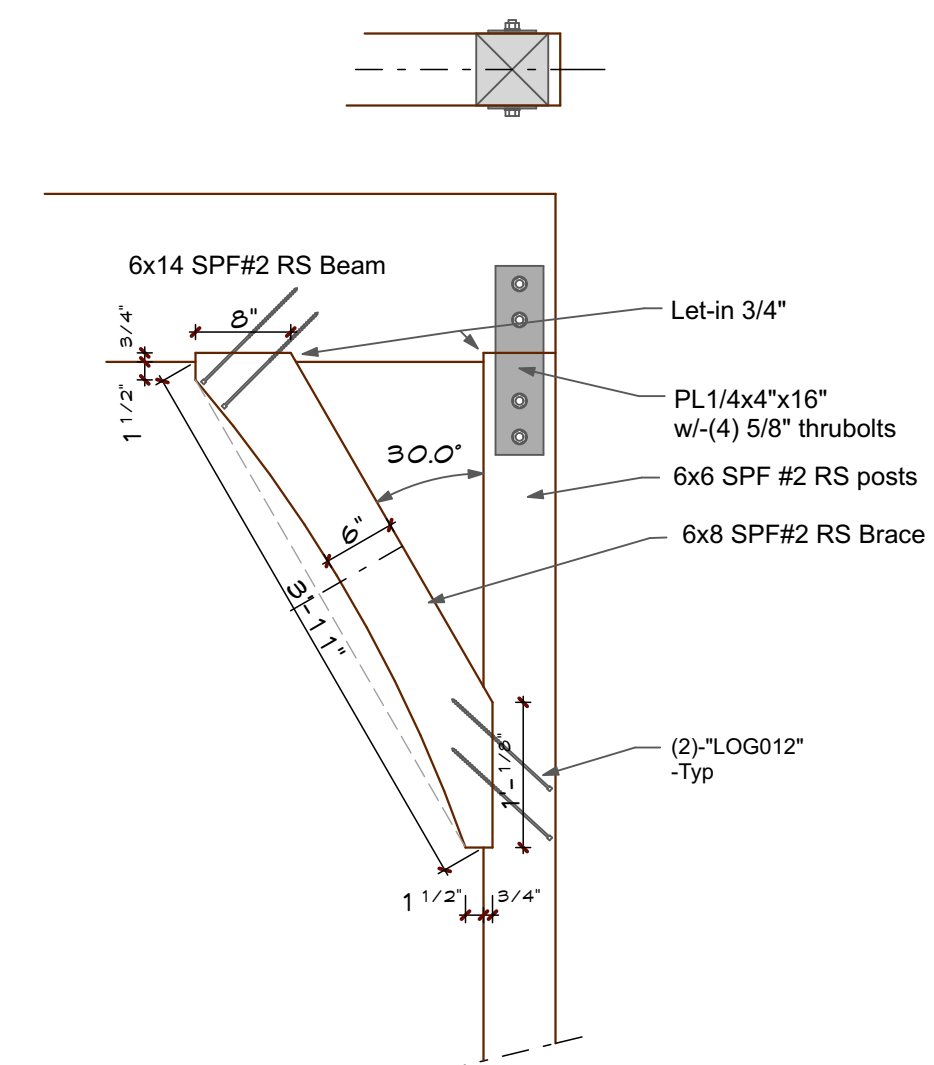

BEAM/POST CONN.

SCALE: 3/4" = 1'-0"

CONSULTANTS

A
New
Residence
for
Black Dog
Holding, LLC
56010 Hannah's Way
CLARK
COLORADO
80428
PIN: 286800004
CB-15-234

MARK	DATE	DESCRIPTION
SD	01/28/15	M-L HOA Sketch Plan Review
DD	03/19/15	Client Review
DD	04/06/15	Window/Door Pricing
CD	04/22/15	Prelim. Structural Review
CD	05/27/15	PERMIT SET-FO
CD	06/15/15	Rev. FOUND SET
CD	11/20/15	PERMIT SET-FULL

PROJECT NO:
MODEL FILE:
DRAWN BY:
CHK'D BY:

SHEET TITLE

BBQ PORCH

S-2.2

SHEET 30

OF 42