


Volumes/Public/Projects 18.0/Ostrogna/Ostrogna SD/Ostrogna.pln

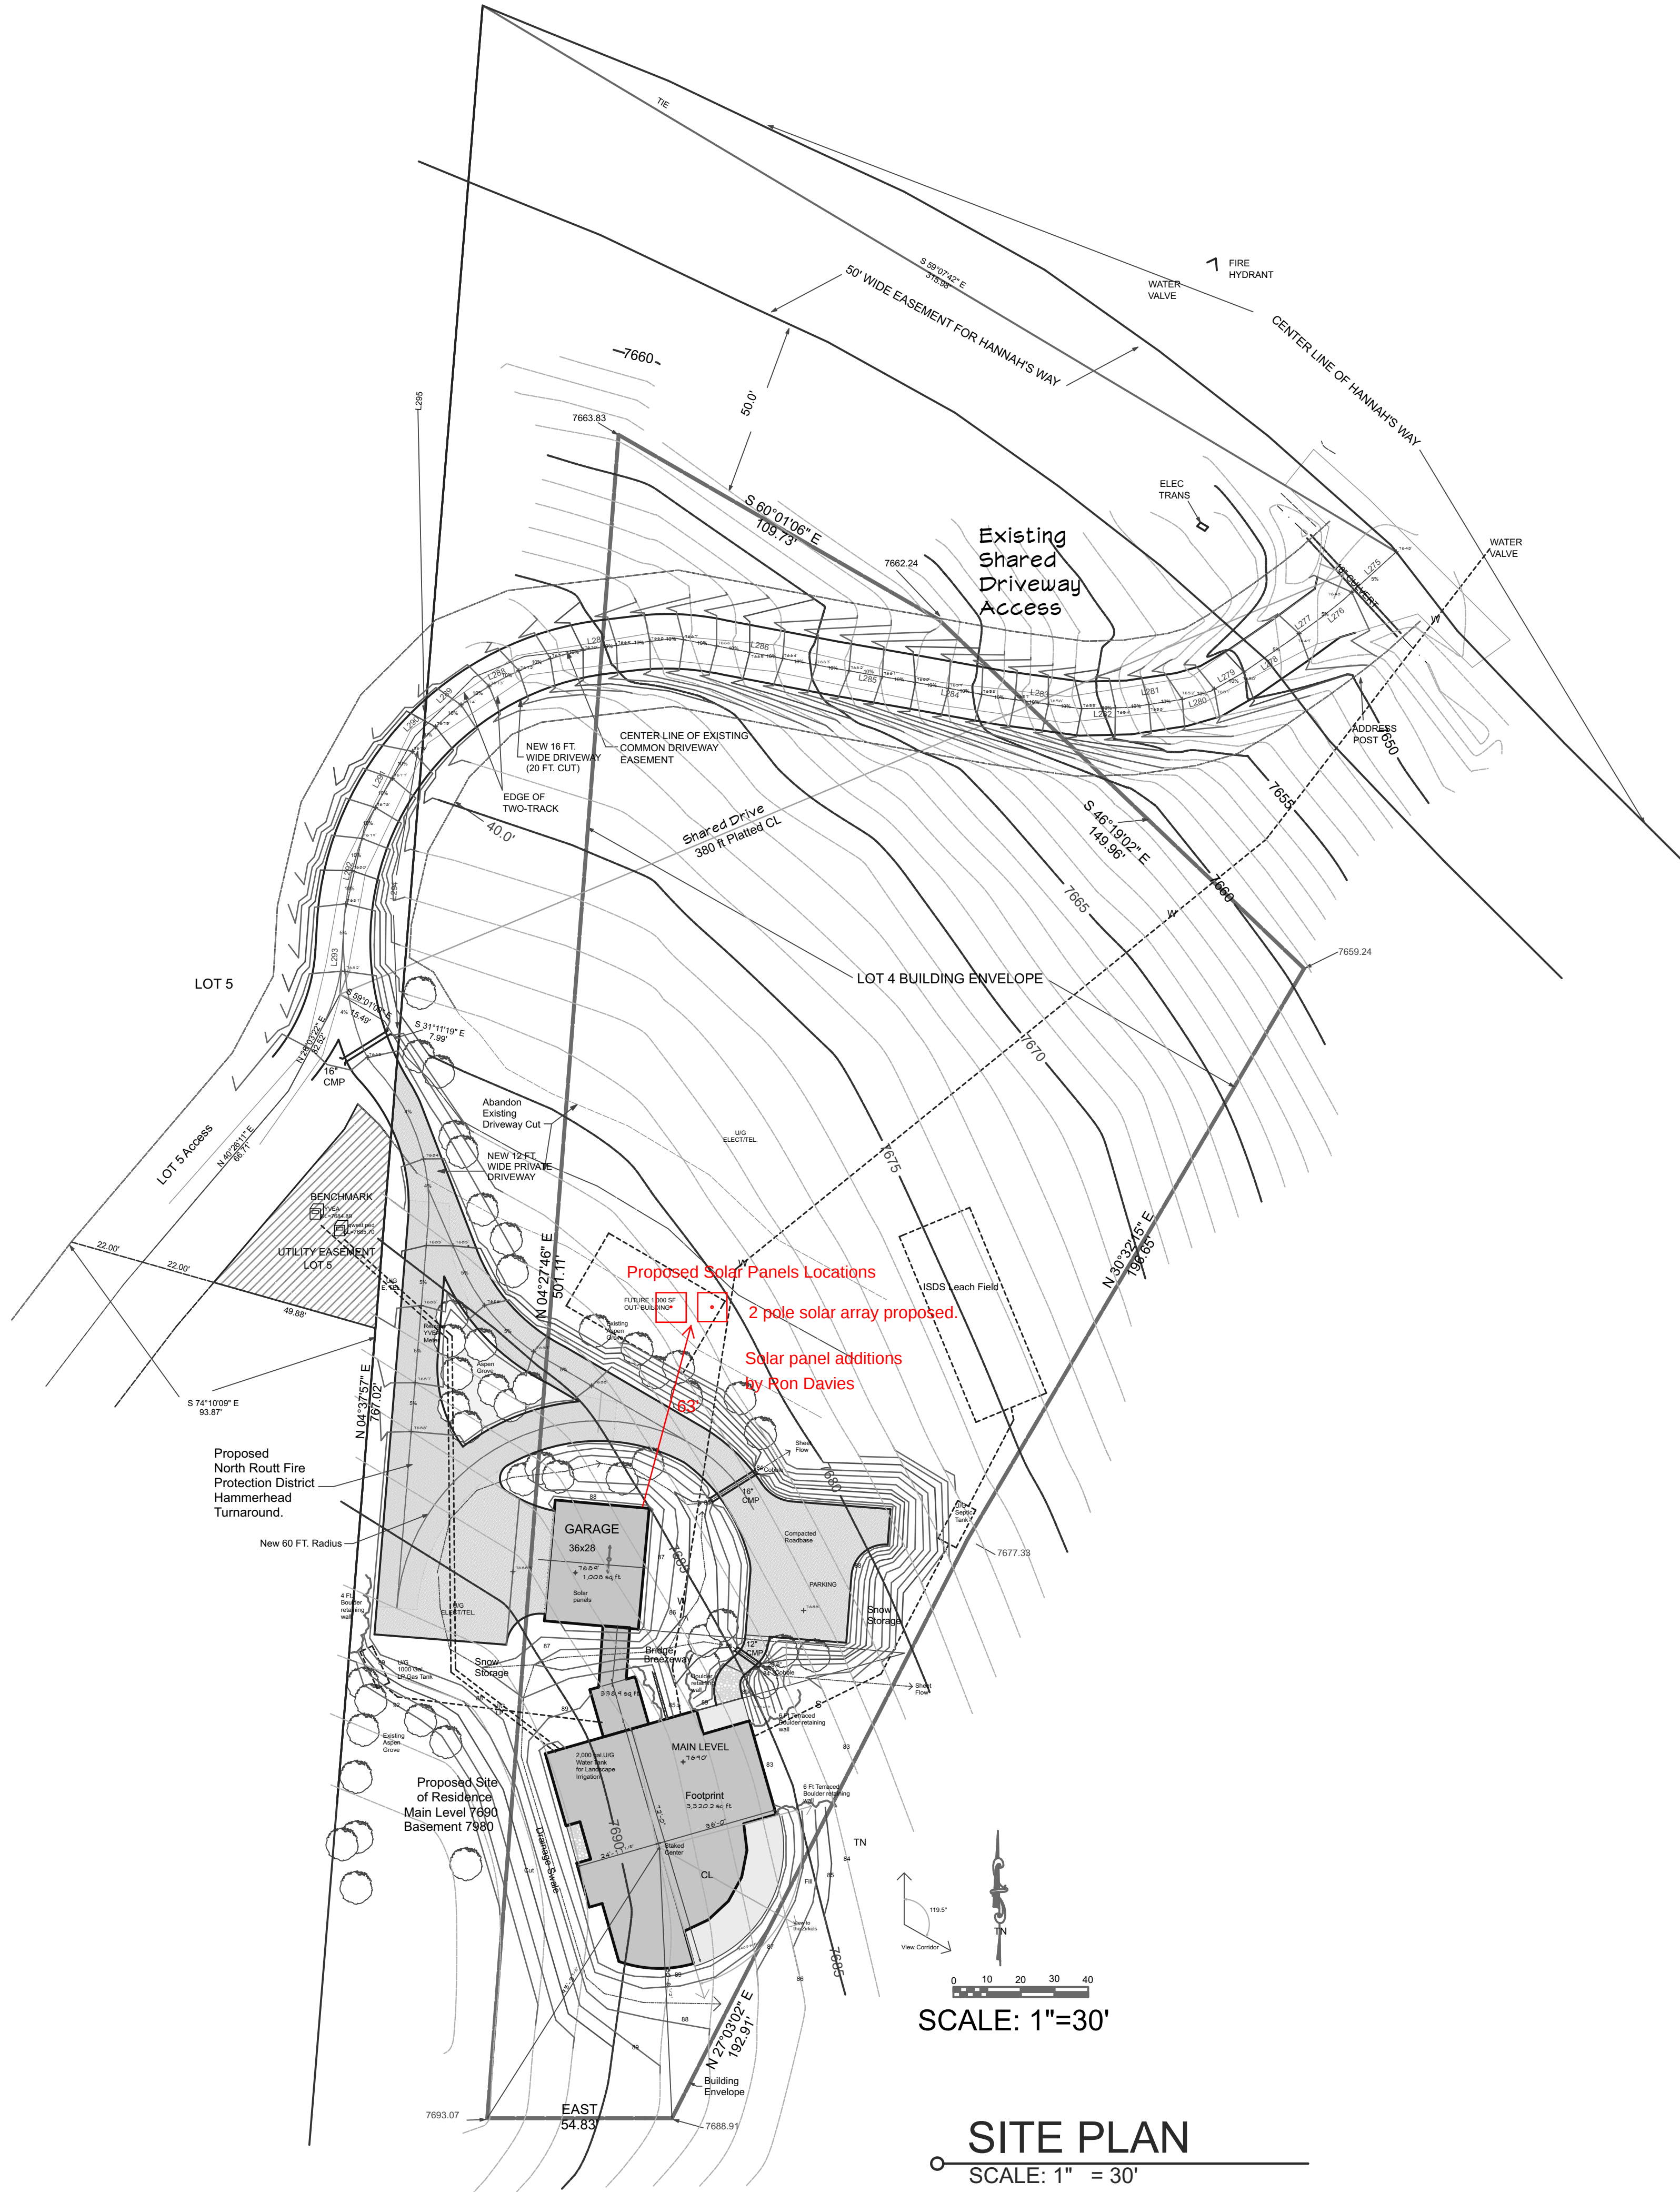

CONSULTANTS

A
New
Residence
for
Black Dog
Holding, LLC

56010 Hannah's Way
CLARK
COLORADO
80428
PIN: 2868000004

MARK	DATE	DESCRIPTION
SD	01/28/15	M-L HOA Sketch Plan Review
DD	03/19/15	Client Review
DD	04/06/15	Window/Door Pricing
CD	04/22/15	Prelim. Structural Review
CD	05/27/15	PERMIT SET

PROJECT NO:
MODEL FILE:
DRAWN BY:
CHK'D BY:

SHEET TITLE

SITE PLAN

C-1.2