



FRONT ELEVATION



RIGHT ELEVATION

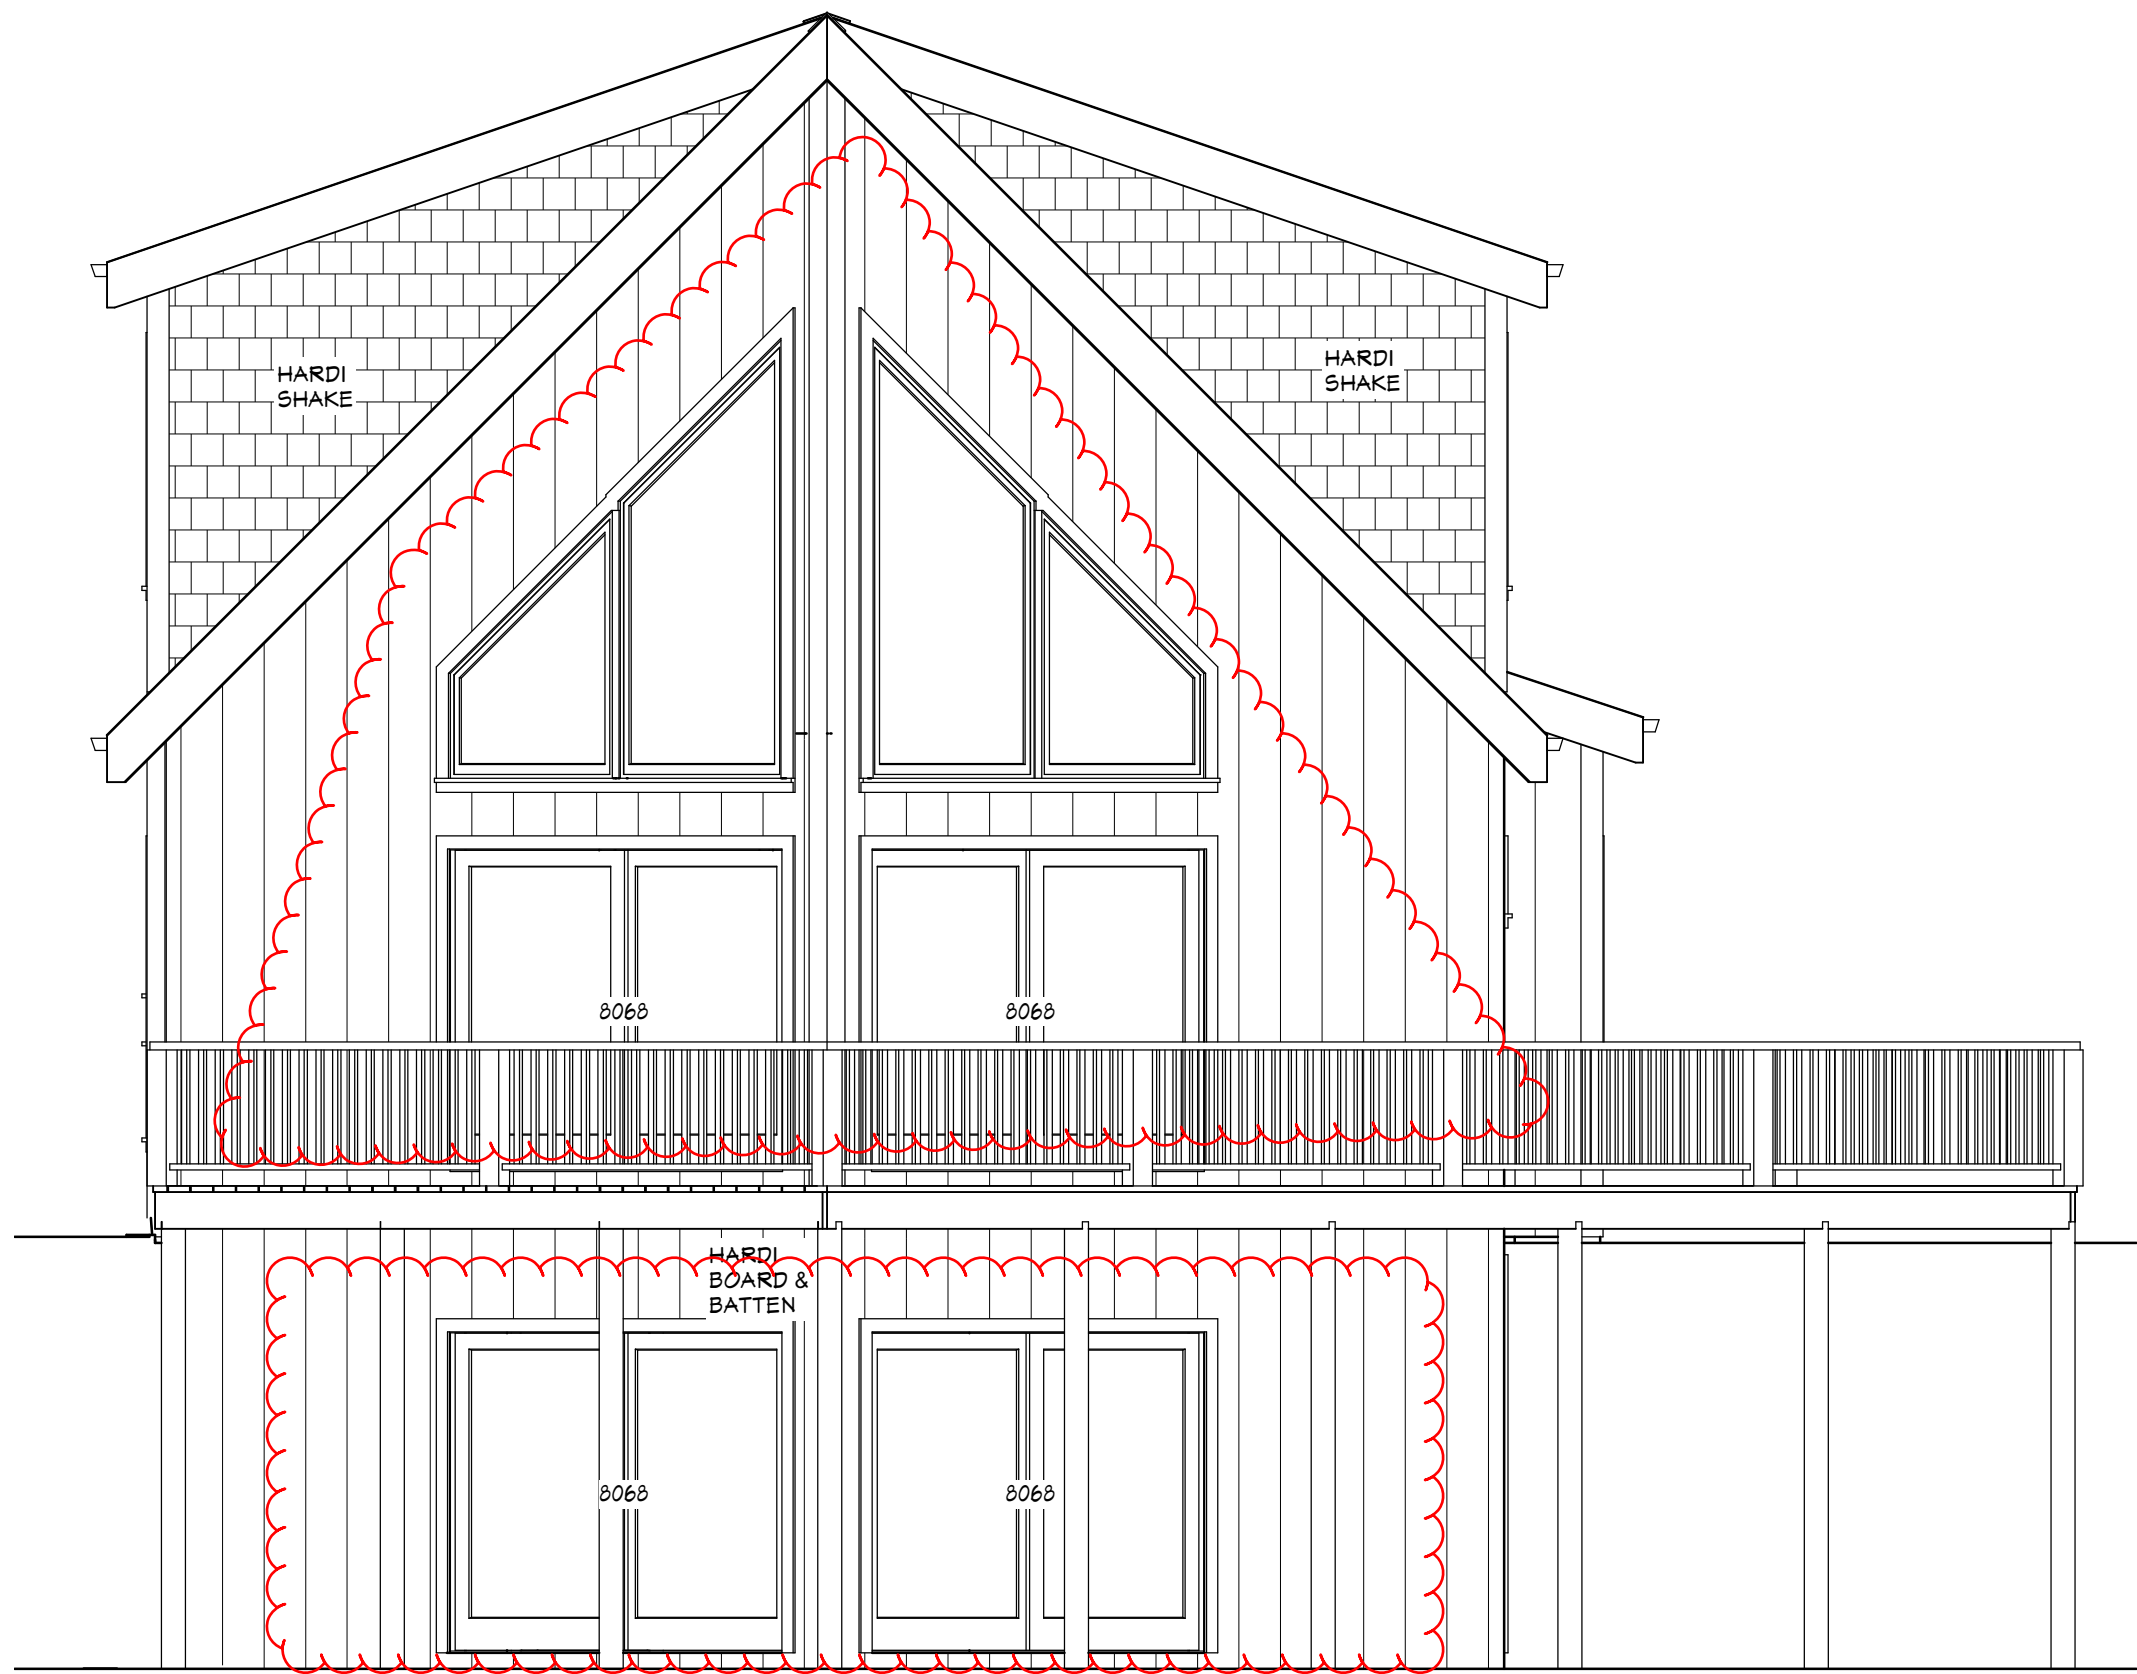

REAR ELEVATION

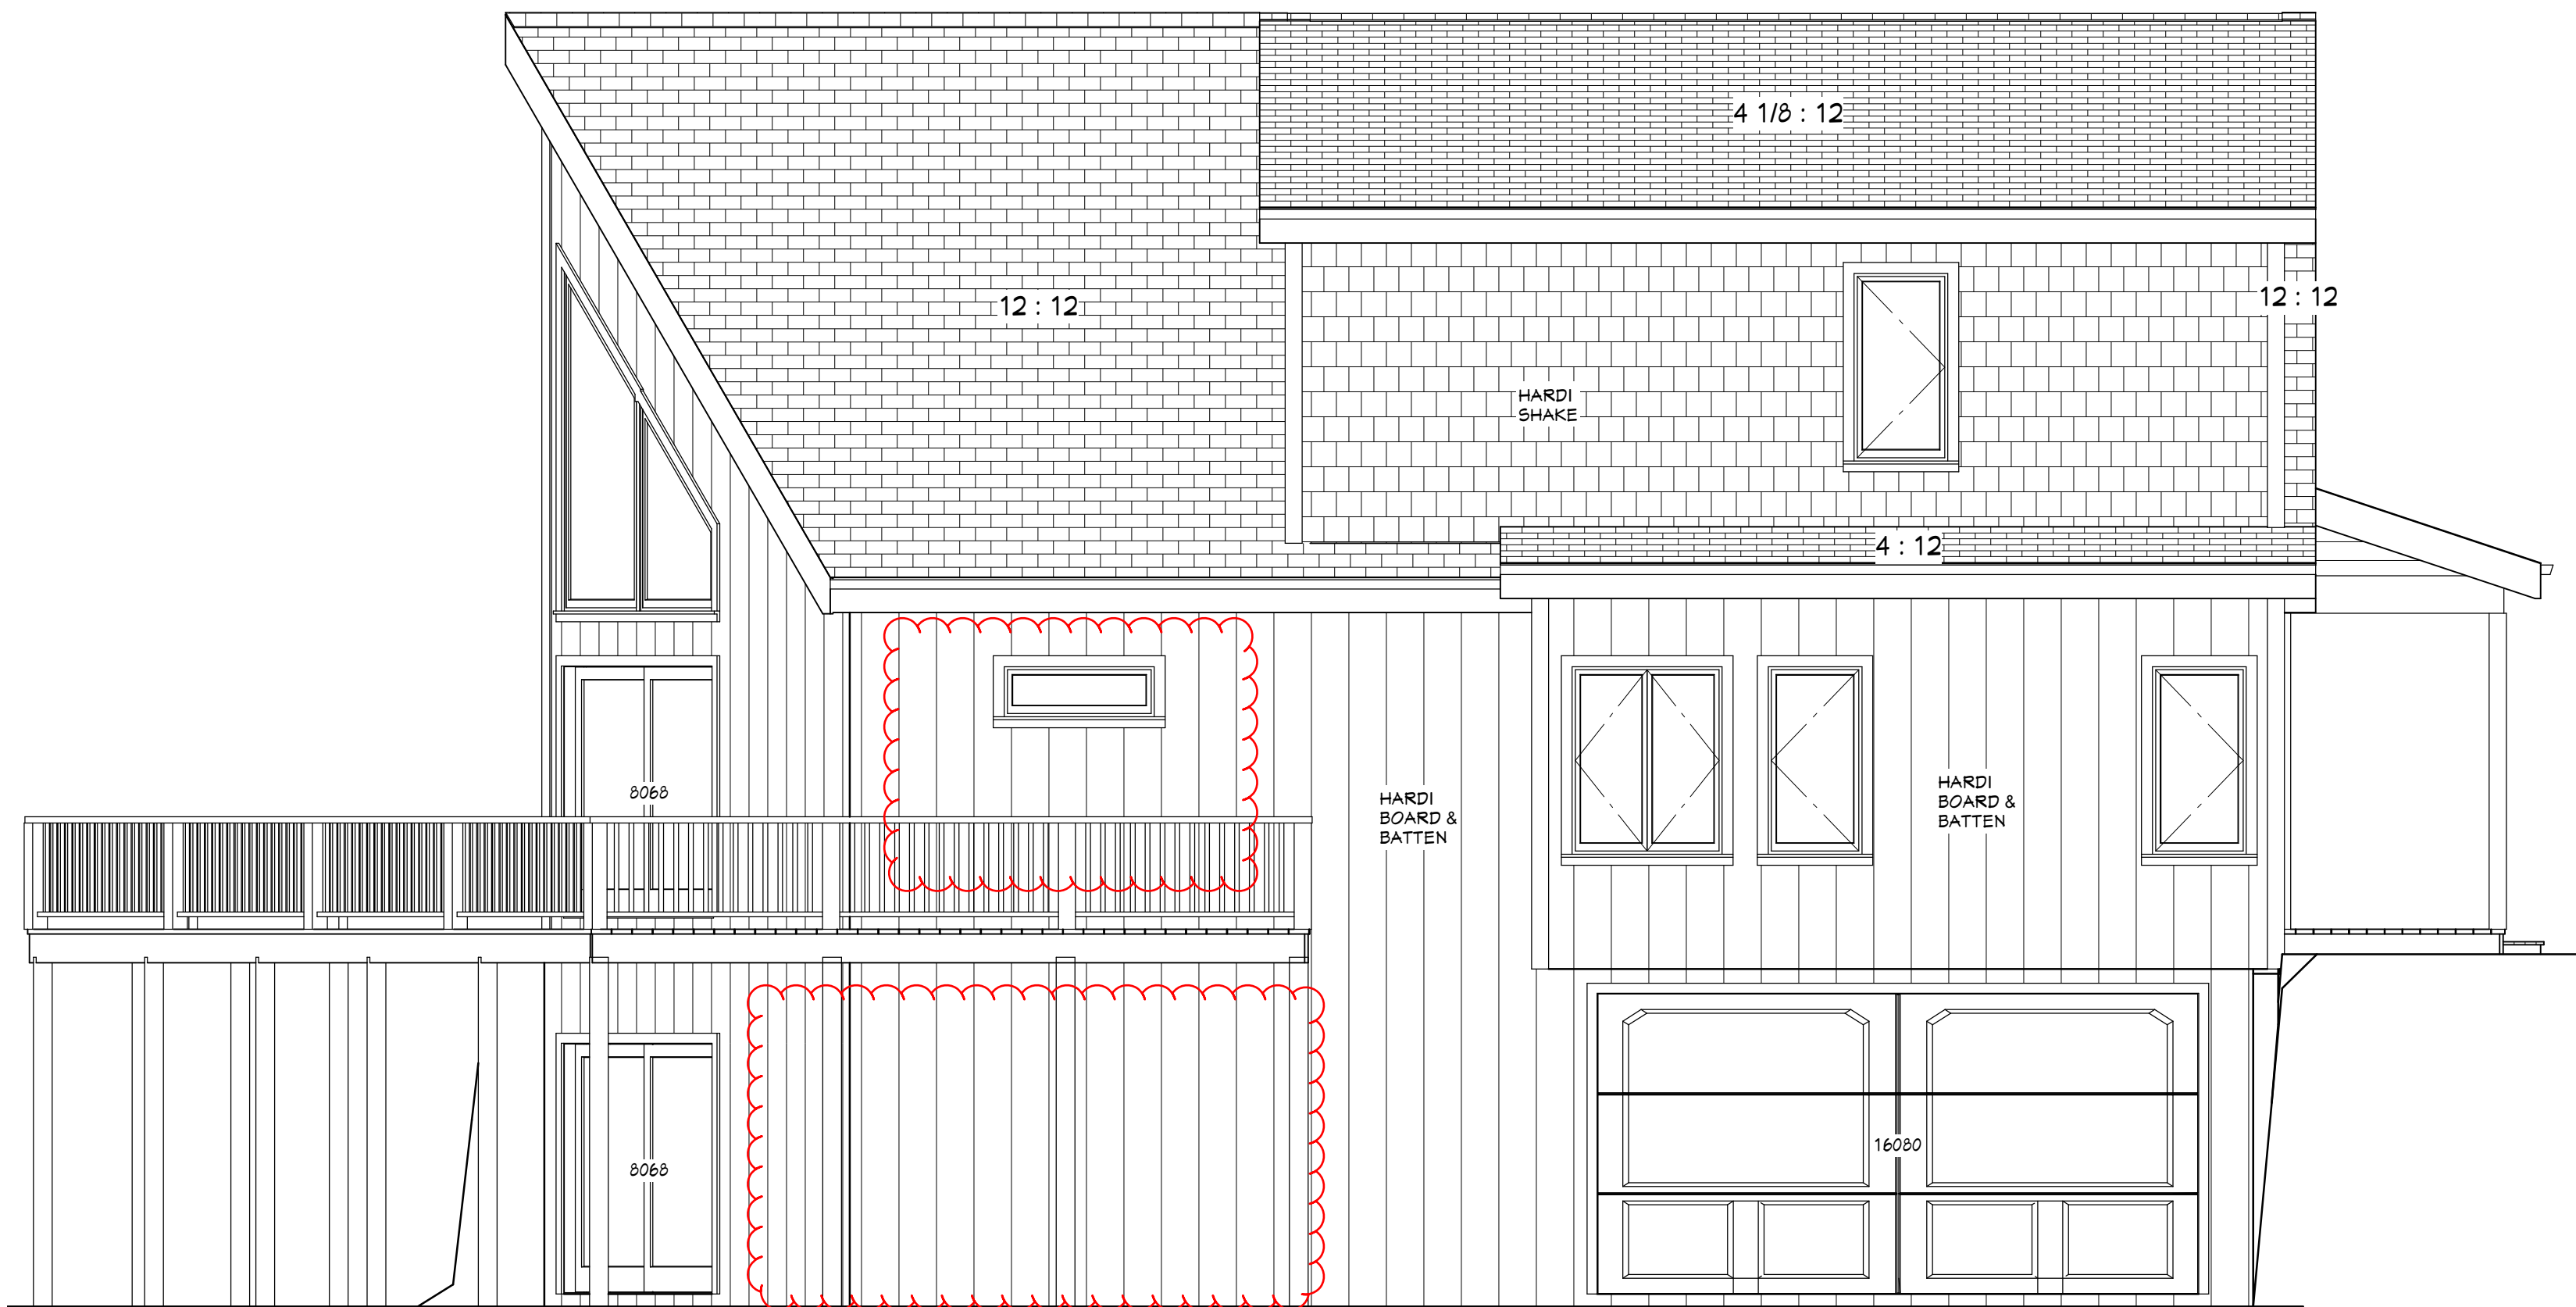

LEFT ELEVATION

GENERAL NOTES

ALL WORK SHALL BE PERFORMED IN ACCORDANCE WITH APPLICABLE BUILDING CODES. (CURRENTLY IRC 2012)

CONTRACTOR/BUILDER SHALL VERIFY ALL CONDITIONS AND DIMENSIONS AT SITE BEFORE BEGINNING CONSTRUCTION. ANY DISCREPANCIES SHALL BE REPORTED TO CAD HOME DESIGN, INC. FOR JUSTIFICATION OR CORRECTION BEFORE PROCEEDING WITH THE WORK. CONTRACTOR SHALL ASSUME RESPONSIBILITY FOR UNREPORTED ERRORS.

ALL DIMENSIONS ARE TO BE READ OR CALCULATED AND NEVER SCALED.

ALL PORTIONS OF FOOTINGS ARE TO BE BELOW LOCAL FROST LINES AND MUST REST ON UNDISTURBED SOIL WITH ADEQUATE BEARING CAPACITY TO SUPPORT THE STRUCTURE. A LOCAL ENGINEER MUST BE CONSULTED FOR PROPER FOOTING AND REINFORCEMENT SIZES.

CONTRACTOR TO ENSURE COMPATIBILITY OF THE STRUCTURE WITH ALL SITE REQUIREMENTS.

REINFORCE FOUNDATION WALLS PER LOCAL CODES.

ALL FOUNDATION AND STRUCTURAL MEMBERS SHOULD BE VERIFIED AND STAMPED BY AN ENGINEER.

THE CONTRACTOR IS RESPONSIBLE FOR THE ADJUSTMENT AND VERIFICATION OF ALL STRUCTURAL DETAILS AND CONDITIONS TO MEET ALL LOCAL CODES AND TO ENSURE A WELL CONSTRUCTED AND SAFE STRUCTURE.

ALL WOOD, CONCRETE, AND STEEL MEMBERS ARE TO MEET NATIONAL, STATE, AND LOCAL CODES.

ALL COLUMNS OR SOLID FRAMING SHALL BE DESIGNED TO CARRY AND TERMINATE LOADS THROUGH THE STRUCTURE TO FOUNDATION ELEMENTS THAT DISTRIBUTE THE LOADS TO FULL CAPACITY SOILS.


CAD HOME DESIGN ASSUMES NO LIABILITY FOR ANY HOME CONSTRUCTED FROM THIS PLAN WITHOUT THE ABOVE NOTES APPLIED.

CAD HOME DESIGN IS THE SOLE OWNER OF THIS OR ANY DERIVATIVE MODIFICATION OF THIS COPYRIGHT PROTECTED PLAN.

ALL ELECTRICAL, MECHANICAL, AND PLUMBING ARE TO BE VERIFIED AND PERFORMED BY A LICENSED ELECTRICAL, MECHANICAL, AND PLUMBING CONTRACTOR IN ACCORDANCE WITH BUILDING CODE.

CAD HOME DESIGN COPYRIGHT 2016


65 Stone Ridge Ct.
#20433
Jasper, Ga 30143
O: 770.883.4345
F: 770.234.4067

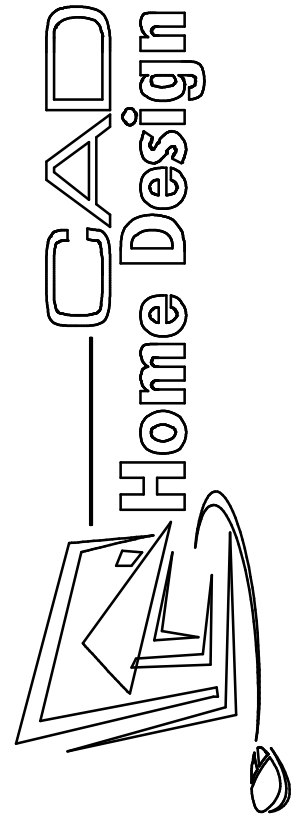

SQUARE
TOTAL 1218
2ND. FLOOR 670
TERRACE 658
BONUS 2546



TURCOTTE
RESIDENCE

CHK: CHK:
DATE 3/11/2017

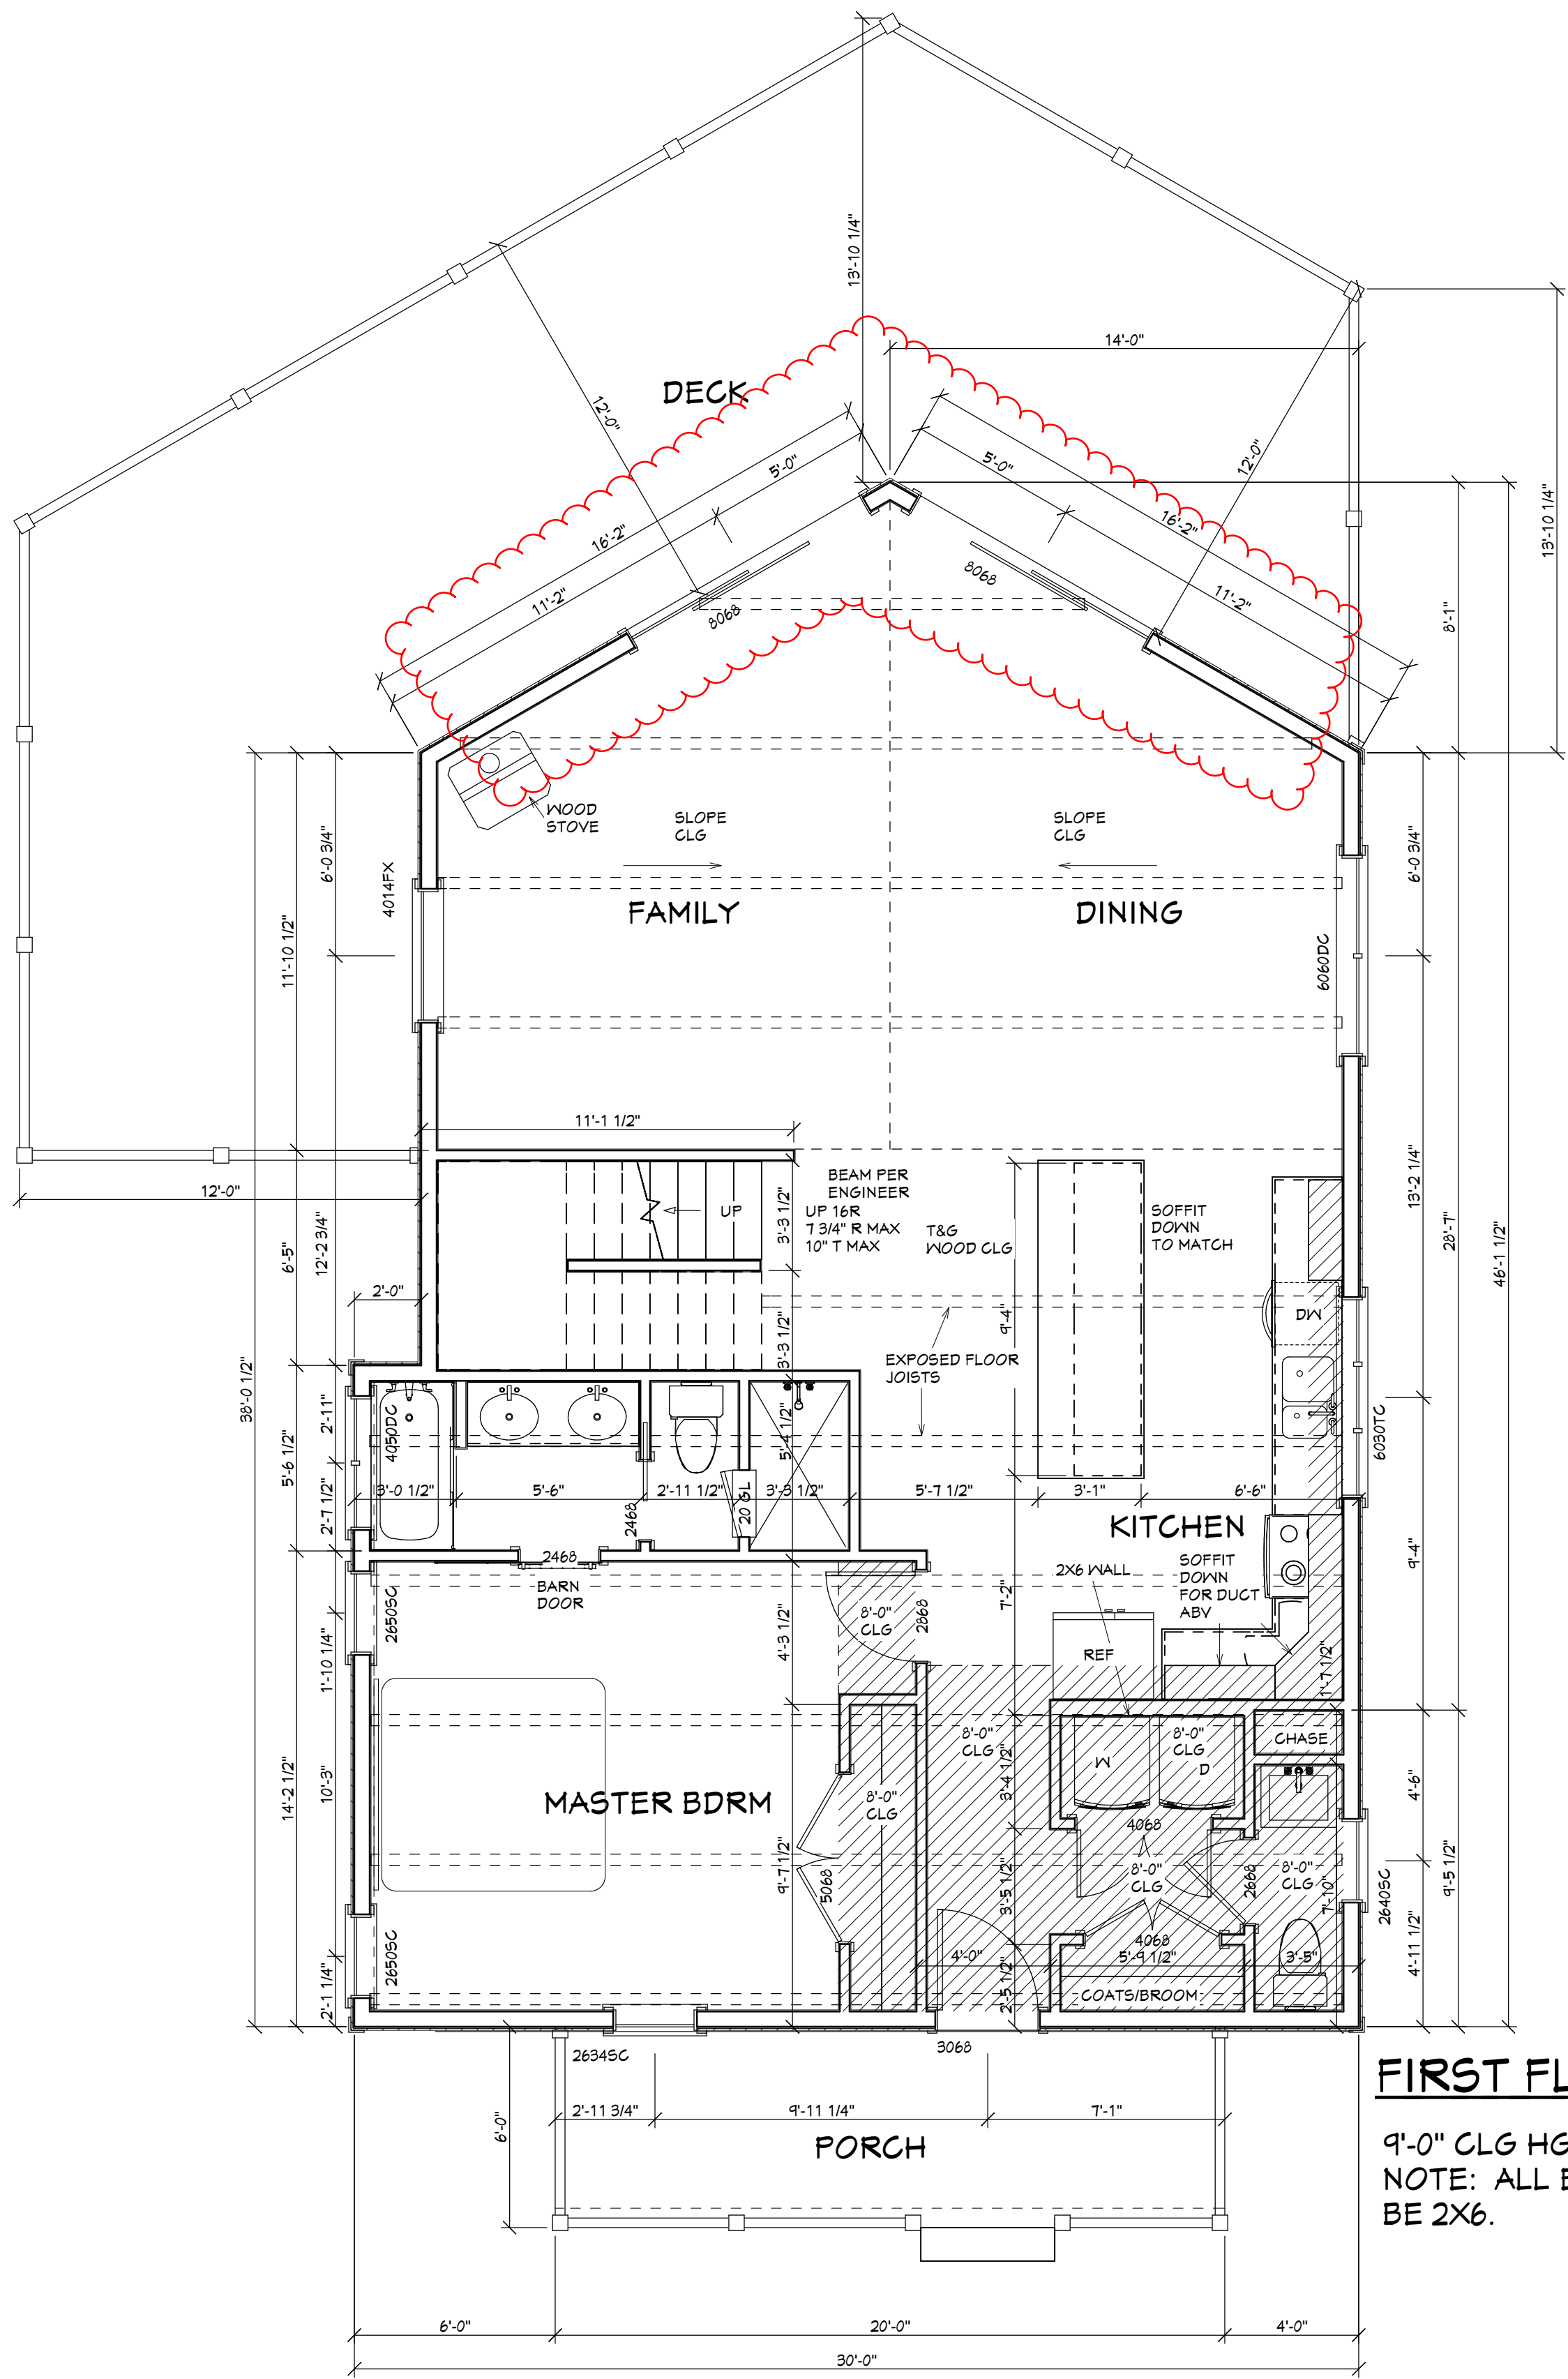

FIRST FLOOR

9'-0" CLG HGT
NOTE: ALL EXTERIOR WALL
BE 2X6.

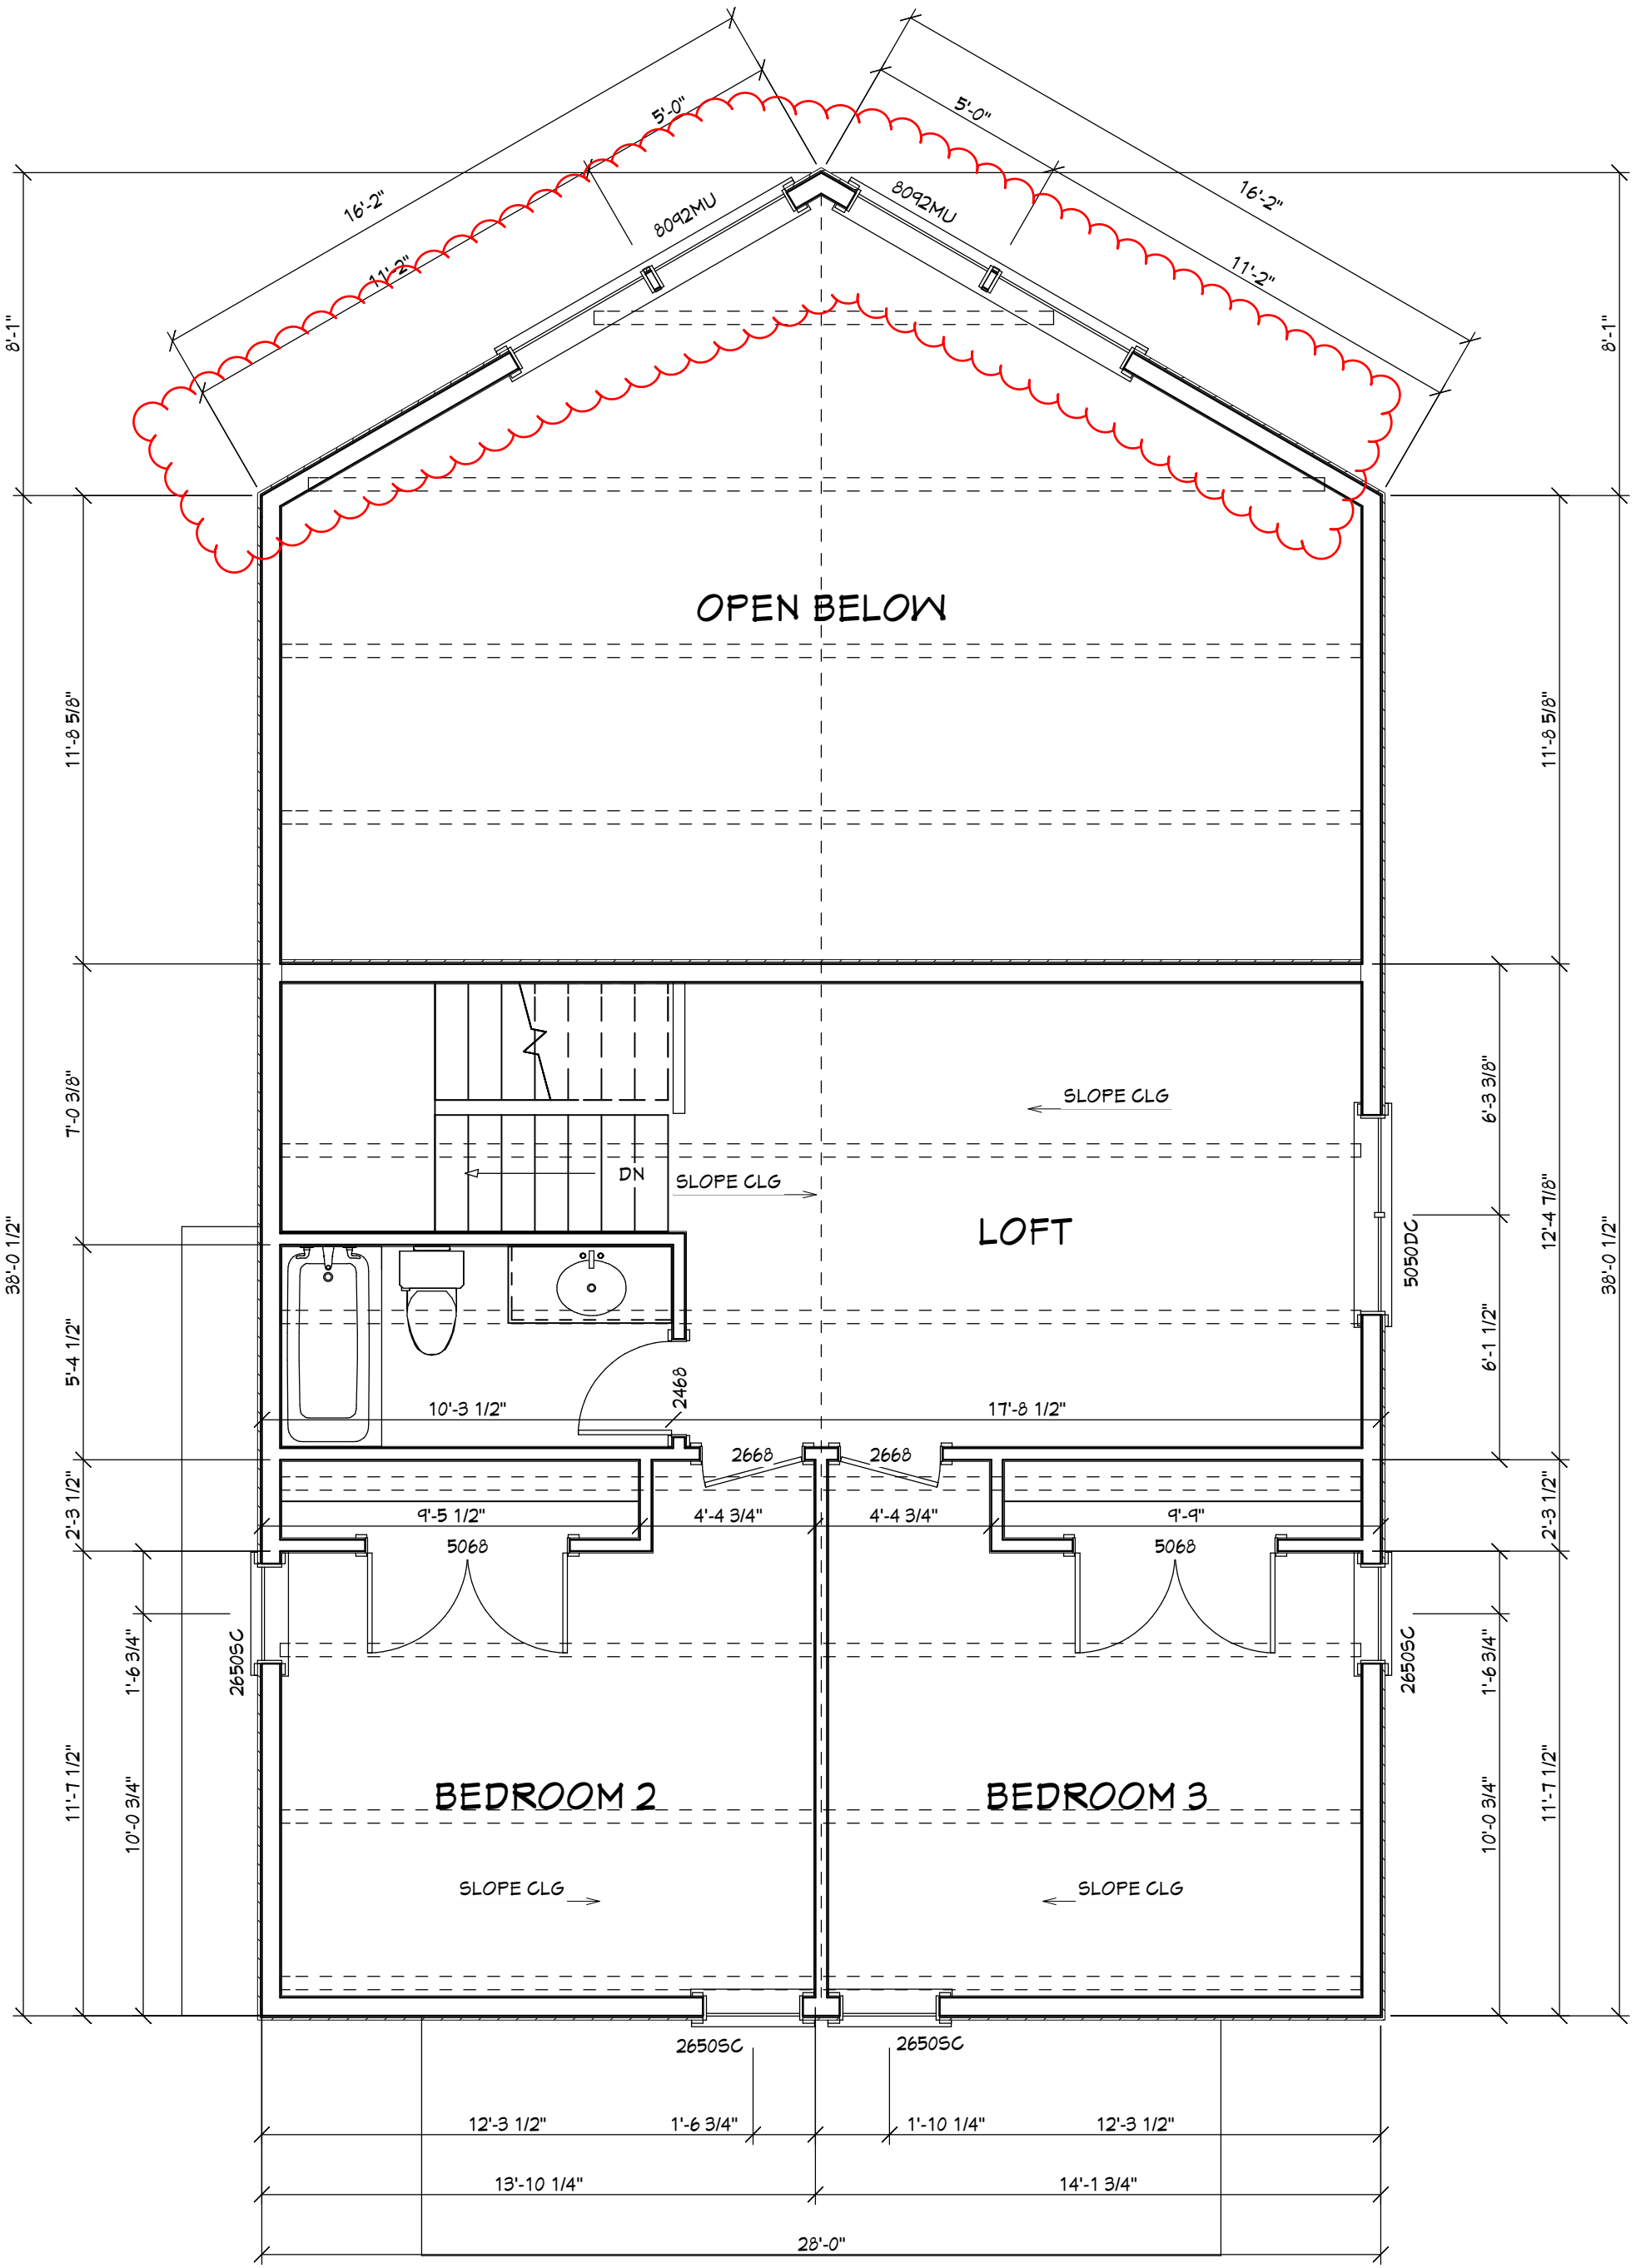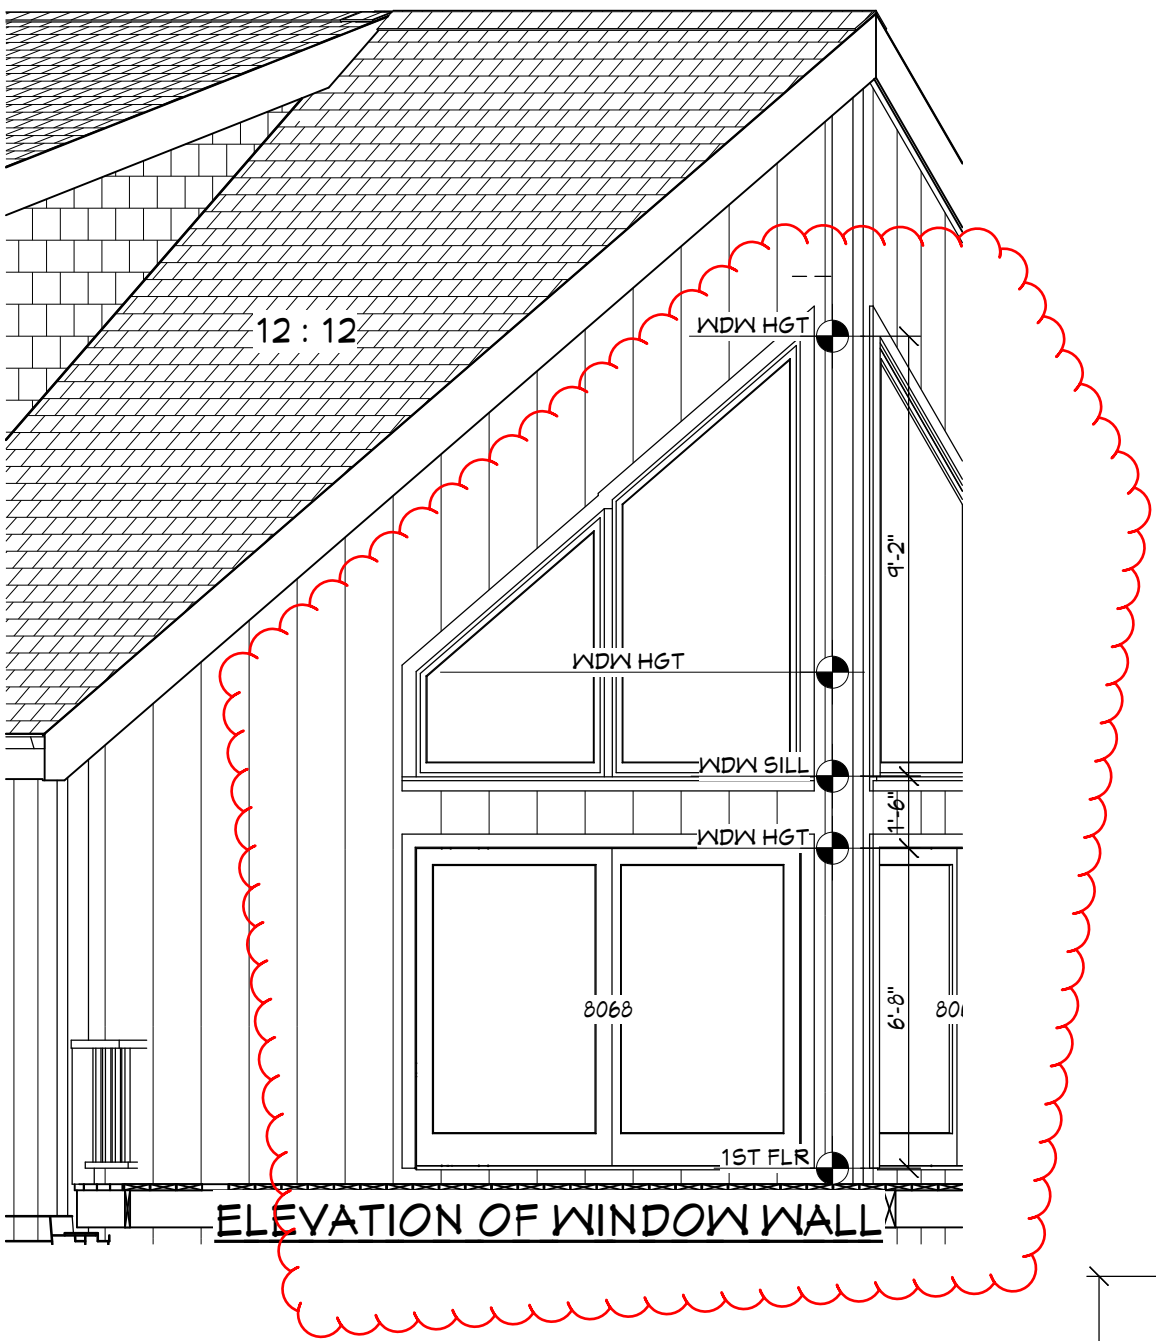

SECOND FLOOR

R C R B D
RECORD SET

GENERAL NOTES

ALL WORK SHALL BE PERFORMED IN ACCORDANCE WITH APPLICABLE BUILDING CODES. (CURRENTLY IRC 2012)

CONTRACTOR/BUILDER SHALL VERIFY ALL CONDITIONS AND DIMENSIONS AT SITE BEFORE BEGINNING CONSTRUCTION. ANY DISCREPANCIES SHALL BE REPORTED TO CAD HOME DESIGN, INC. FOR JUSTIFICATION OR CORRECTION BEFORE PROCEEDING WITH THE WORK. CONTRACTOR SHALL ASSUME RESPONSIBILITY FOR UNREPORTED ERRORS.

ALL DIMENSIONS ARE TO BE READ OR CALCULATED AND NEVER SCALED.

ALL PORTIONS OF FOOTINGS ARE TO BE BELOW LOCAL FROST LINES AND MUST REST ON UNDISTURBED SOIL WITH ADEQUATE BEARING CAPACITY TO SUPPORT THE STRUCTURE. A LOCAL ENGINEER MUST BE CONSULTED FOR PROPER FOOTING AND REINFORCEMENT SIZES.

CONTRACTOR TO ENSURE COMPATIBILITY OF THE STRUCTURE WITH ALL SITE REQUIREMENTS.

REINFORCE FOUNDATION WALLS PER LOCAL CODES.

ALL FOUNDATION AND STRUCTURAL MEMBERS SHOULD BE VERIFIED AND STAMPED BY AN ENGINEER.

THE CONTRACTOR IS RESPONSIBLE FOR THE ADJUSTMENT AND VERIFICATION OF ALL STRUCTURAL DETAILS AND CONDITIONS TO MEET ALL LOCAL CODES AND TO ENSURE A WELL CONSTRUCTED AND SAFE STRUCTURE.

ALL WOOD, CONCRETE, AND STEEL MEMBERS ARE TO MEET NATIONAL, STATE, AND LOCAL CODES.

ALL COLUMNS OR SOLID FRAMING SHALL BE DESIGNED TO CARRY AND TERMINATE LOADS THROUGH THE STRUCTURE TO FOUNDATION ELEMENTS THAT DISTRIBUTE THE LOADS TO FULL CAPACITY SOILS.


CAD HOME DESIGN ASSUMES NO LIABILITY FOR ANY HOME CONSTRUCTED FROM THIS PLAN WITHOUT THE ABOVE NOTES APPLIED.

CAD HOME DESIGN IS THE SOLE OWNER OF THIS OR ANY DERIVATIVE MODIFICATION OF THIS COPYRIGHT PROTECTED PLAN.

ALL ELECTRICAL, MECHANICAL, AND PLUMBING ARE TO BE VERIFIED AND PERFORMED BY A LICENSED ELECTRICAL, MECHANICAL, AND PLUMBING CONTRACTOR IN ACCORDANCE WITH BUILDING CODE.

CAD HOME DESIGN COPYRIGHT 2016

65 Stone Ridge Ct.
#20433
Jasper, Ga 30143
O 770.883.4345
F 770.234.4067

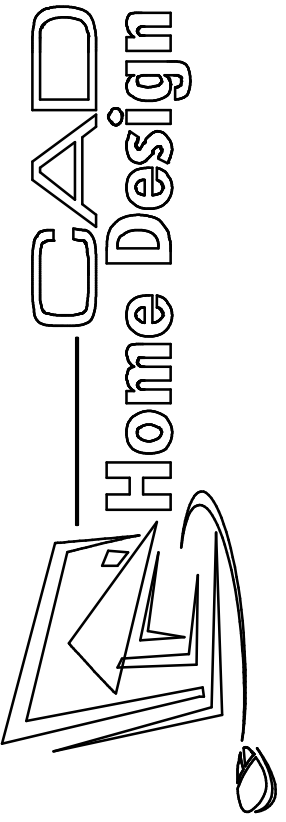

SQUARE
FOOTAGE 1218
2ND. FLOOR 670
TERRACE 658
BONUS 2546

TURCOTTE
RESIDENCE

CHK: CHK:
DATE 3/11/2017

R C R B D
RECORD SET



ALL WORK SHALL BE PERFORMED IN ACCORDANCE WITH APPLICABLE BUILDING CODES. (CURRENTLY IRC 2012)

CONTRACTOR/BUILDER SHALL VERIFY ALL CONDITIONS AND DIMENSIONS AT SITE BEFORE BEGINNING CONSTRUCTION. ANY DISCREPANCIES SHALL BE REPORTED TO CAD HOME DESIGN, INC. FOR JUSTIFICATION OR CORRECTION BEFORE PROCEEDING WITH THE WORK. CONTRACTOR SHALL ASSUME RESPONSIBILITY FOR UNREPORTED ERRORS.

ALL DIMENSIONS ARE TO BE READ OR
CALCULATED AND NEVER SCALED.

ALL PORTIONS OF FOOTINGS ARE TO BE BELOW LOCAL FROST LINES AND MUST REST ON UNDISTURBED SOIL WITH ADEQUATE BEARING CAPACITY TO SUPPORT THE STRUCTURE. A LOCAL ENGINEER MUST BE CONSULTED FOR PROPER FOOTING AND REINFORCEMENT SIZES.

CONTRACTOR TO ENSURE COMPATIBILITY OF THE STRUCTURE WITH ALL SITE REQUIREMENTS.

REINFORCE FOUNDATION WALLS PER LOCAL CODES.

ALL FOUNDATION AND STRUCTURAL MEMBERS
SHOULD BE VERIFIED AND STAMPED BY AN
ENGINEER.

THE CONTRACTOR IS RESPONSIBLE FOR THE ADJUSTMENT AND VERIFICATION OF ALL STRUCTURAL DETAILS AND CONDITIONS TO MEET ALL LOCAL CODES AND TO ENSURE A WELL CONSTRUCTED AND SAFE STRUCTURE.

ALL WOOD, CONCRETE, AND STEEL MEMBERS ARE TO MEET NATIONAL, STATE, AND LOCAL CODES.


ALL COLUMNS OR SOLID FRAMING SHALL BE DESIGNED TO CARRY AND TERMINATE LOADS THROUGH THE STRUCTURE TO FOUNDATION ELEMENTS THAT DISTRIBUTE THE LOADS TO FULL CAPACITY SOILS.

CAD HOME DESIGN ASSUMES NO LIABILITY
FOR ANY HOME CONSTRUCTED FROM THIS
PLAN WITHOUT THE ABOVE NOTES APPLIED.

CAD HOME DESIGN IS THE SOLE OWNER OF
THIS OR ANY DERIVATIVE MODIFICATION OF
THIS COPYRIGHT PROTECTED PLAN

ALL ELECTRICAL, MECHANICAL, AND PLUMBING ARE TO BE VERIFIED AND PERFORMED BY A LICENSED ELECTRICAL, MECHANICAL, AND PLUMBING CONTRACTOR IN ACCORDANCE WITH BUILDING CODE.

65 Stone Ridge Ct.
#20433
Jasper, Ga 30143
O.770.893.4545
F.770.234.4067

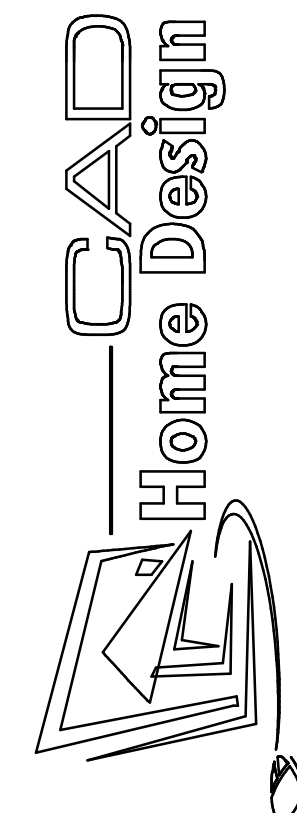

CAD HOME DESIGN COPYRIGHT 2016

SQUARE	
FOOTAGE	
1ST. FLOOR	1218
2ND. FLOOR	670
TERRACE	658
BONUS	2546

**TURCOTTE
RESIDENCE**

CHK:

DATE 3/11/2017