


PJ2484-1
Fire Prevention
In: 06/26/2017
Out: 06/28/2017

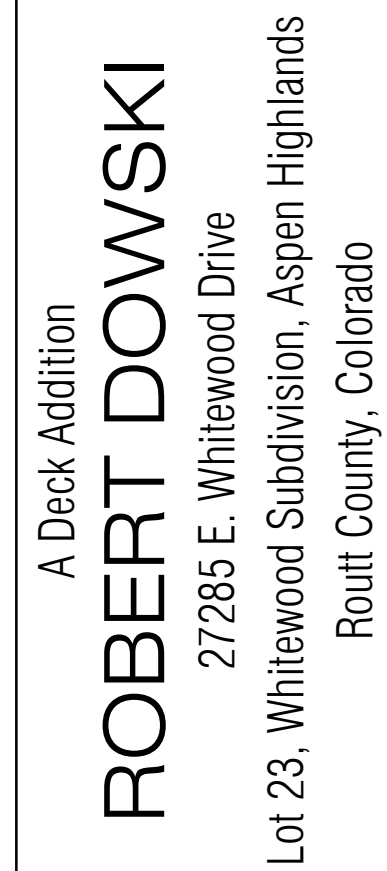

JOB NO. 1621
DRAWN clk
CHECKED jmk
DATE 11.10.16
REVISIONS:
NO. | DATE

DRAWING NUMBER
A0
OF 3 DRAWINGS

R C R B D
RECORD SET


- GENERAL
1. DESIGN LIVE LOADS: Snow=85psf, Floor=40psf, Wind 100mph (3 Second Gust) Exposure C, Seismic Zone B
 2. RESPONSIBILITY: The contractor is responsible for cross referencing all plans and inspecting work placement at the site to assure that no omissions or discrepancies exist that might adversely affect construction or the integrity of the finished product. Job site and construction safety are not addressed in these plans and are the responsibility of the contractor. These responsibilities are industry standard.
 3. These plans are intended to be in accordance with 2012 IRC and IRC codes. All construction to be in conformance with these codes.

- FOUNDATION
1. Foundation designed in accordance with NWCC site specific soils report which is hereby made a part of these drawings. Maximum allowable soil bearing pressure = 3000 psf. Minimum 700 psf
 2. We recommend the soils engineer verify during excavation (and before construction of any part of the foundation) that soils types and conditions match those described in the pit log(s) of the above mentioned soils report.
 3. Remove topsoils, organic material, and any questionable material below pads and footers. All pads and footings exposed to frost must maintain the required 4' frost depth. Minimum pad thickness = 12". The footing elevations of this design are indicated in economical relation to architectural elements. Proper soil bearing and/or the soil report may require lower footings.
 4. Drainage and grading details to divert surface drainage at least 10' away from the structure. Do not backfill against any foundation or retaining wall until all supporting floor and slab systems are in place and securely anchored, or other adequate wall support is provided.
 5. All construction and materials to conform with ACI 318.
 6. Reinforcing bar to be deformed 60 ksi steel (per ASTM A-615). Lap all rebar splices and corners 38 bar diameters minimum.
 7. Concrete supplier to provide mixes that replace 20% of portland cement with recycled fly ash from local coal burning power plants.
 8. Minimum concrete 28 day compressive strength = 3500psi for walls, footers, and pads, and 4000psi for slabs.
 9. Concrete cover: Concrete cast against and permanently exposed to earth: footing, pad = 3". Concrete exposed to earth or weather: walls, slabs = 1.5"
 10. Consolidate concrete per ACI 309. Cast in place concrete shall be poured continuously so as to prevent cold joints.


- WOOD FRAMING
1. Framing plans show structural requirements only. Additional members may be required for blocking, nailers and code requirements.
 2. Use Douglas Fir or Hem Fir "stud grade" (S4S) 2x6 for all wall studs(UNO). Use DF #2 (S4S) or better for all multi-stud posts, joists, rafters, headers, posts, beams and plates.
 3. Sill plates and any other lumber in direct contact with concrete-California Foundation Grade Redwood or Species Group B Pressure Treated Lumber. Use galvanized anchor bolts with pressure treated plates.
 4. Glulams (GL): 24F-V8 manufactured in accordance with AITC 117-84. Ib = 2400psi. OK to use 24F-V4 for simple span applications only. All Glulams used in exterior applications must be sealed and protected from moisture with an appropriate preservative.
 5. Timbers: Douglas Fir (DF) Grade specified on plan: #1 Fb > 1300psi, #2 Fb > 850psi.
 6. Exterior Wall Ply: 7/16" OSB APA rated 24/16 min with 8d @ 16" oc edge, 12" oc field. Manufactured in conformance with APA PS 1-83. Maintain 6" clearance between untreated wood or siding and soils at finish grade.
 7. Provide 2 studs under each end of all load bearing beams or headers > 38"(UNO). (1)king stud min.(UNO)
 8. Multiple stud posts anticipate 2min wall sections preventing buckling. Verify new adjacent openings with engineer.
 9. Studs removed for doors and windows shall be placed equally at the end of headers, up to (2)king (full height) studs each end.
 10. Posts to stack over equal below (UNO). Trusses spanning = 18" to stack over studs below (UNO). Provide end joist where studs above do not stack over studs below.
 11. Solid block all bearing walls and posts for continuity to foundation.
 12. Block all trusses, outlookers, rafters and joists at all bearing points.
 13. Where full height foundation wall parallel to joists, block 1st joist space @24" oc.
 14. Connect joists to blocking with a minimum of (2)10d nails and connect joists to plate or beam below with a minimum of (3)10d toenails. Connect rim to plate below with 10d toenails @ 8" oc.
 15. Nail exterior wall sole plate to joists below with (3)10d and to blocking, rim or end joist with 10d's @ 4" oc.
 16. Nailing, blocking, and all other construction details per 2006 IRC and IRC, such as Table R602.3(1), (UNO)
 17. All connector callouts to be Simpson Strong-Tie or equal by Simpson Strong-Tie Company, Inc. Install per manufacturer's instructions.

TYPICAL ABBREVIATIONS



- BOGB = bottom of grade beam
BRG = bearing
CL = center line
E.E. = each end
E.M. = each member
E.S. = each side
E.W. = each way
GL = Glulam
HDR = header
LVL = Laminated veneer lumber
oc = on center
OF = overframe
OH = overhang
OPP SIM = opposite similar
PL = plate
PT = pressure treated
PSL = parallam
PSL = parallam
RO. = Rough opening
SOB = slab on grade
STR = Structural
TOBL = top of brick ledge
TOF = top of footing
TOGB = top of grade beam
TOS = top of slab
TOSB = top of steel beam
TOW = top of wall
TYP = Typical
UNO = Unless noted otherwise
WS = steel web stiffeners

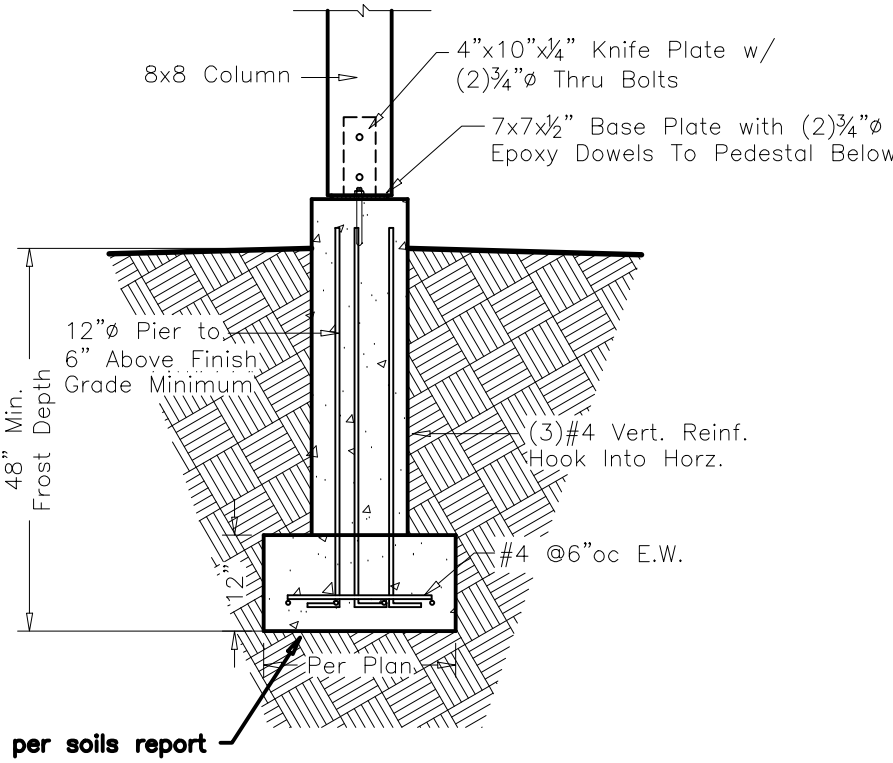


1 PAD / PIER DETAIL
S1 SCALE: 1/2" = 1'-0"

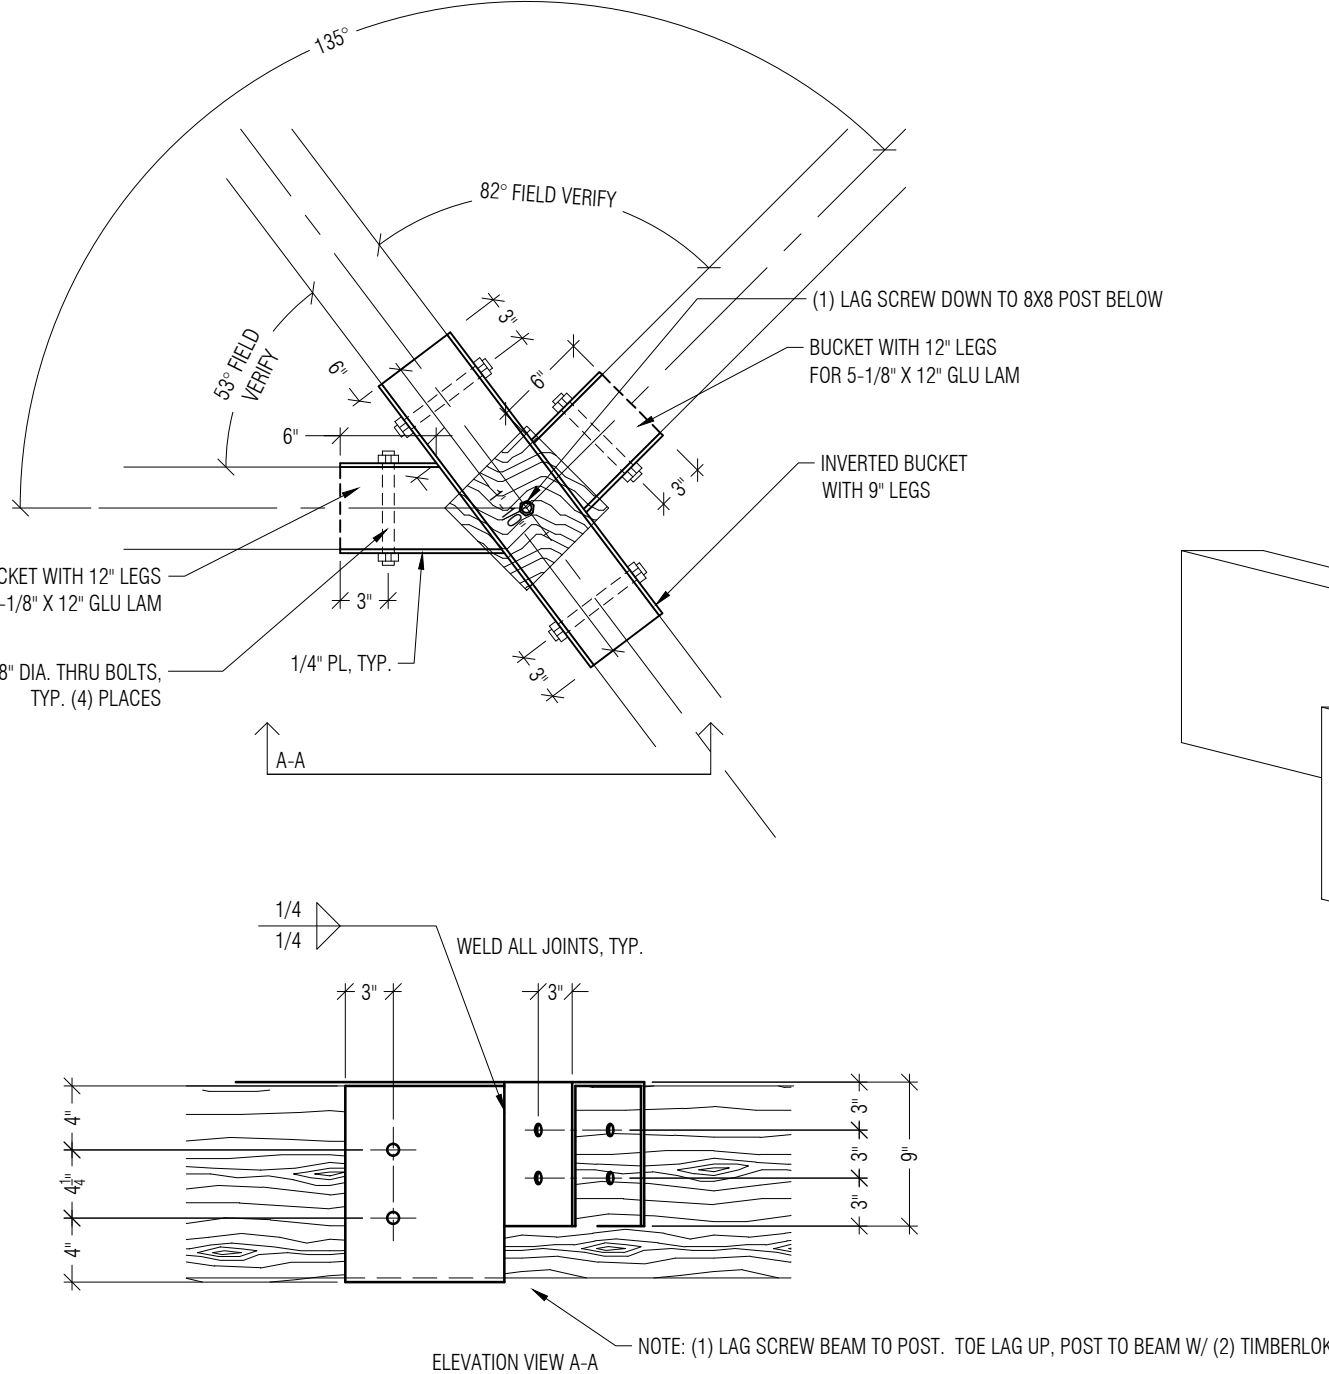


2 CUSTOM BUCKET CONNECTION
S1 SCALE: 1" = 1'-0"

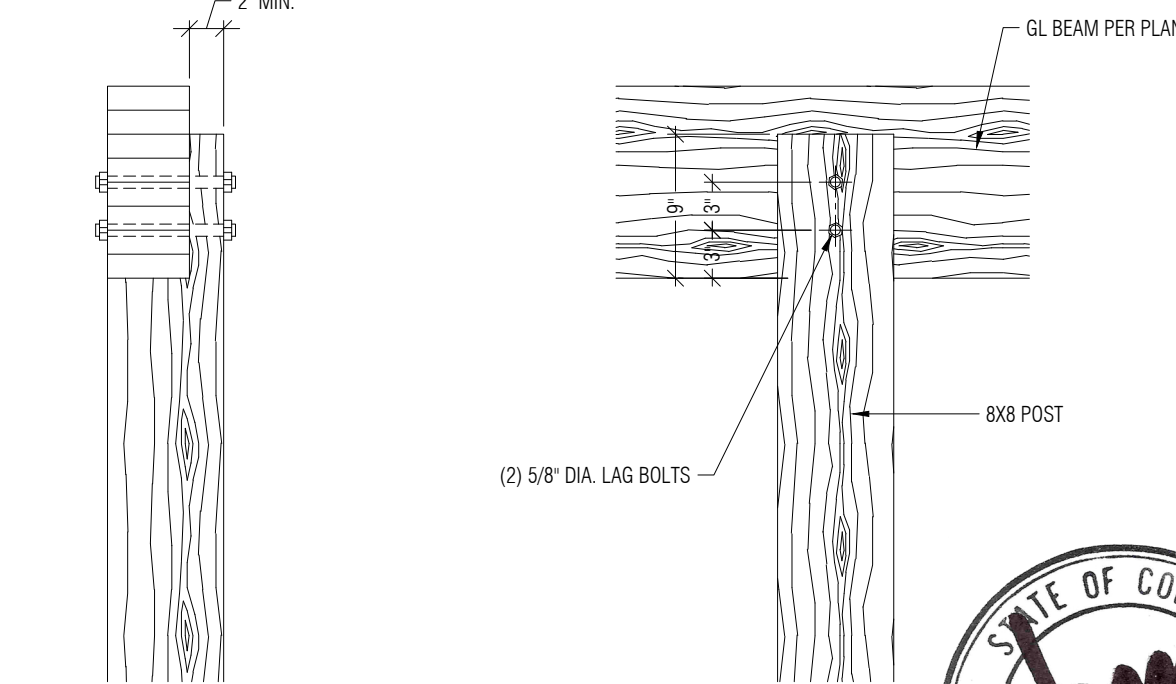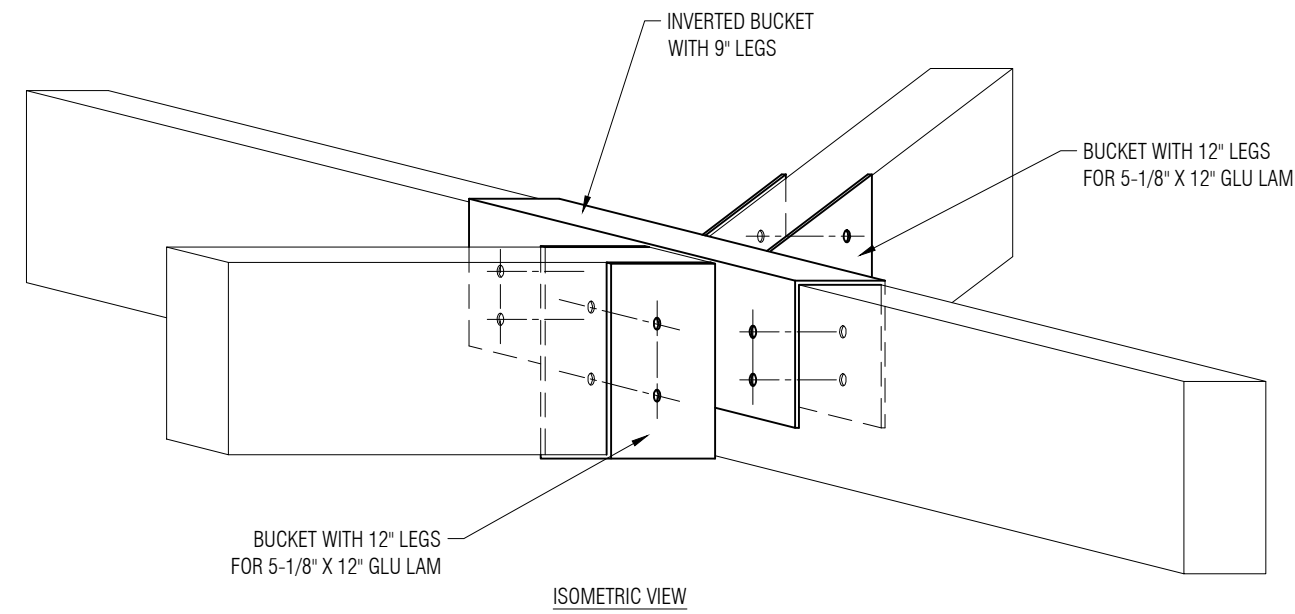


3 POST CONNECTION
S1 SCALE: 1" = 1'-0"

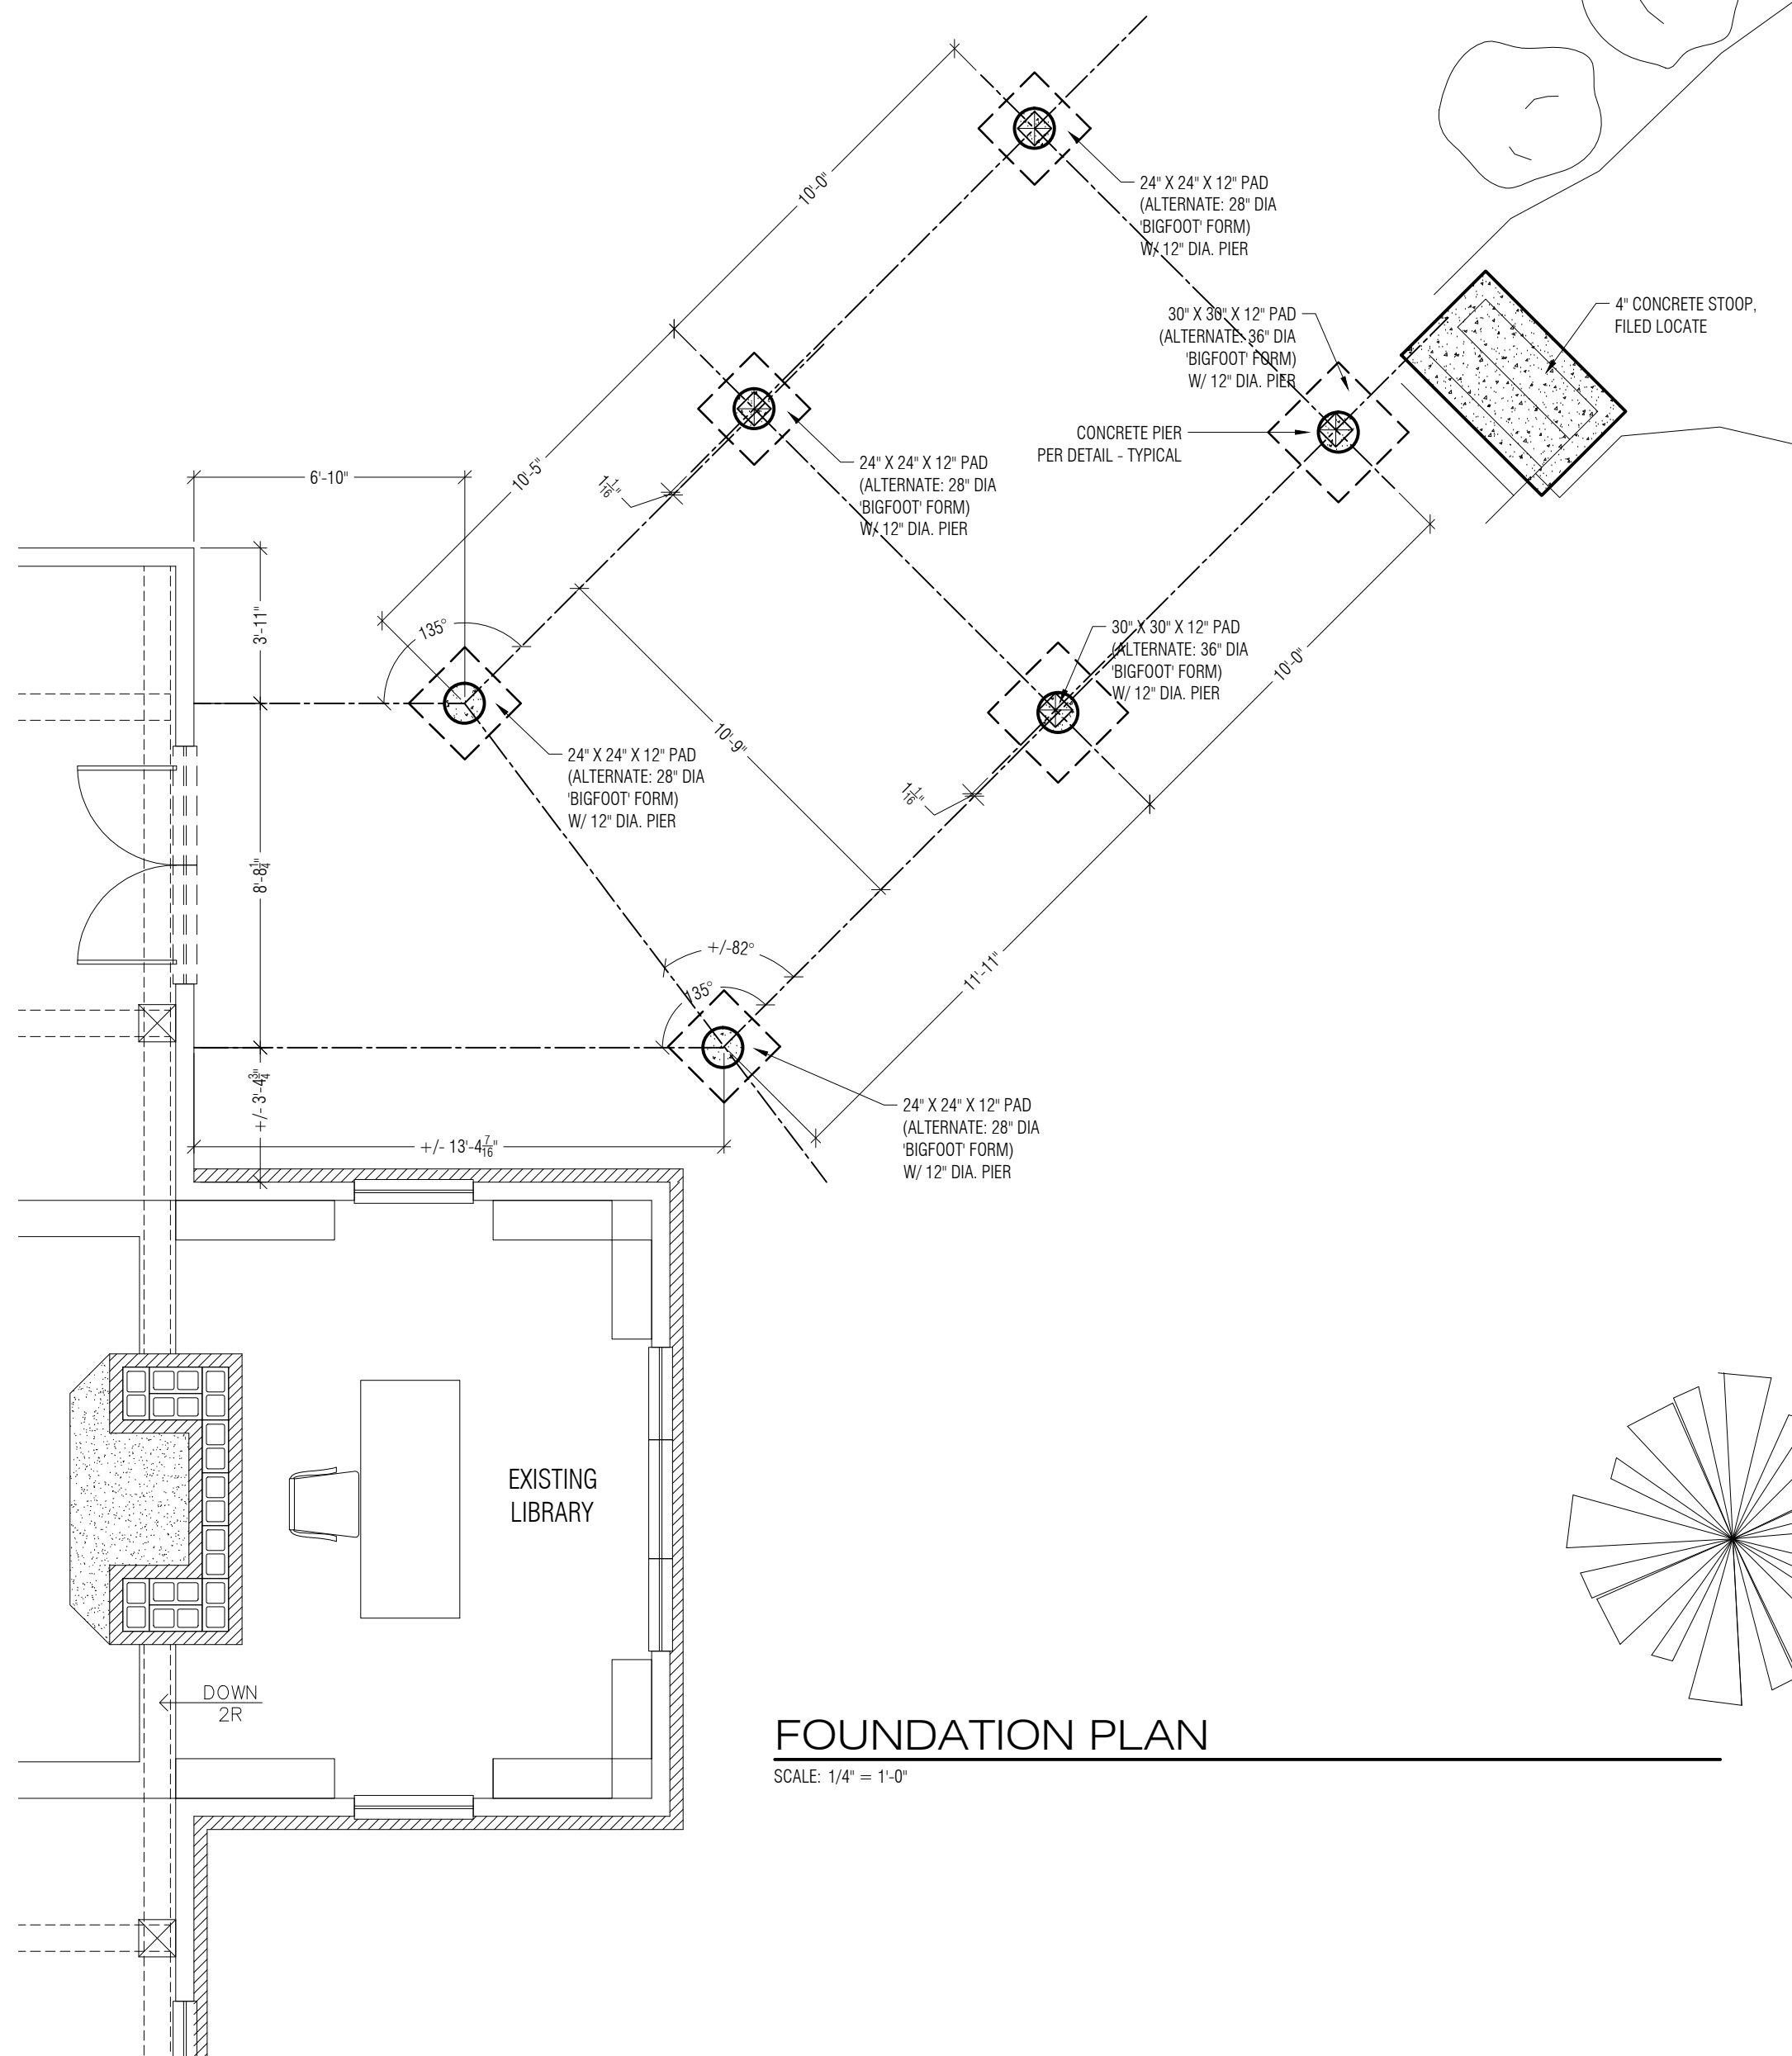

FOUNDATION PLAN
SCALE: 1/4" = 1'-0"

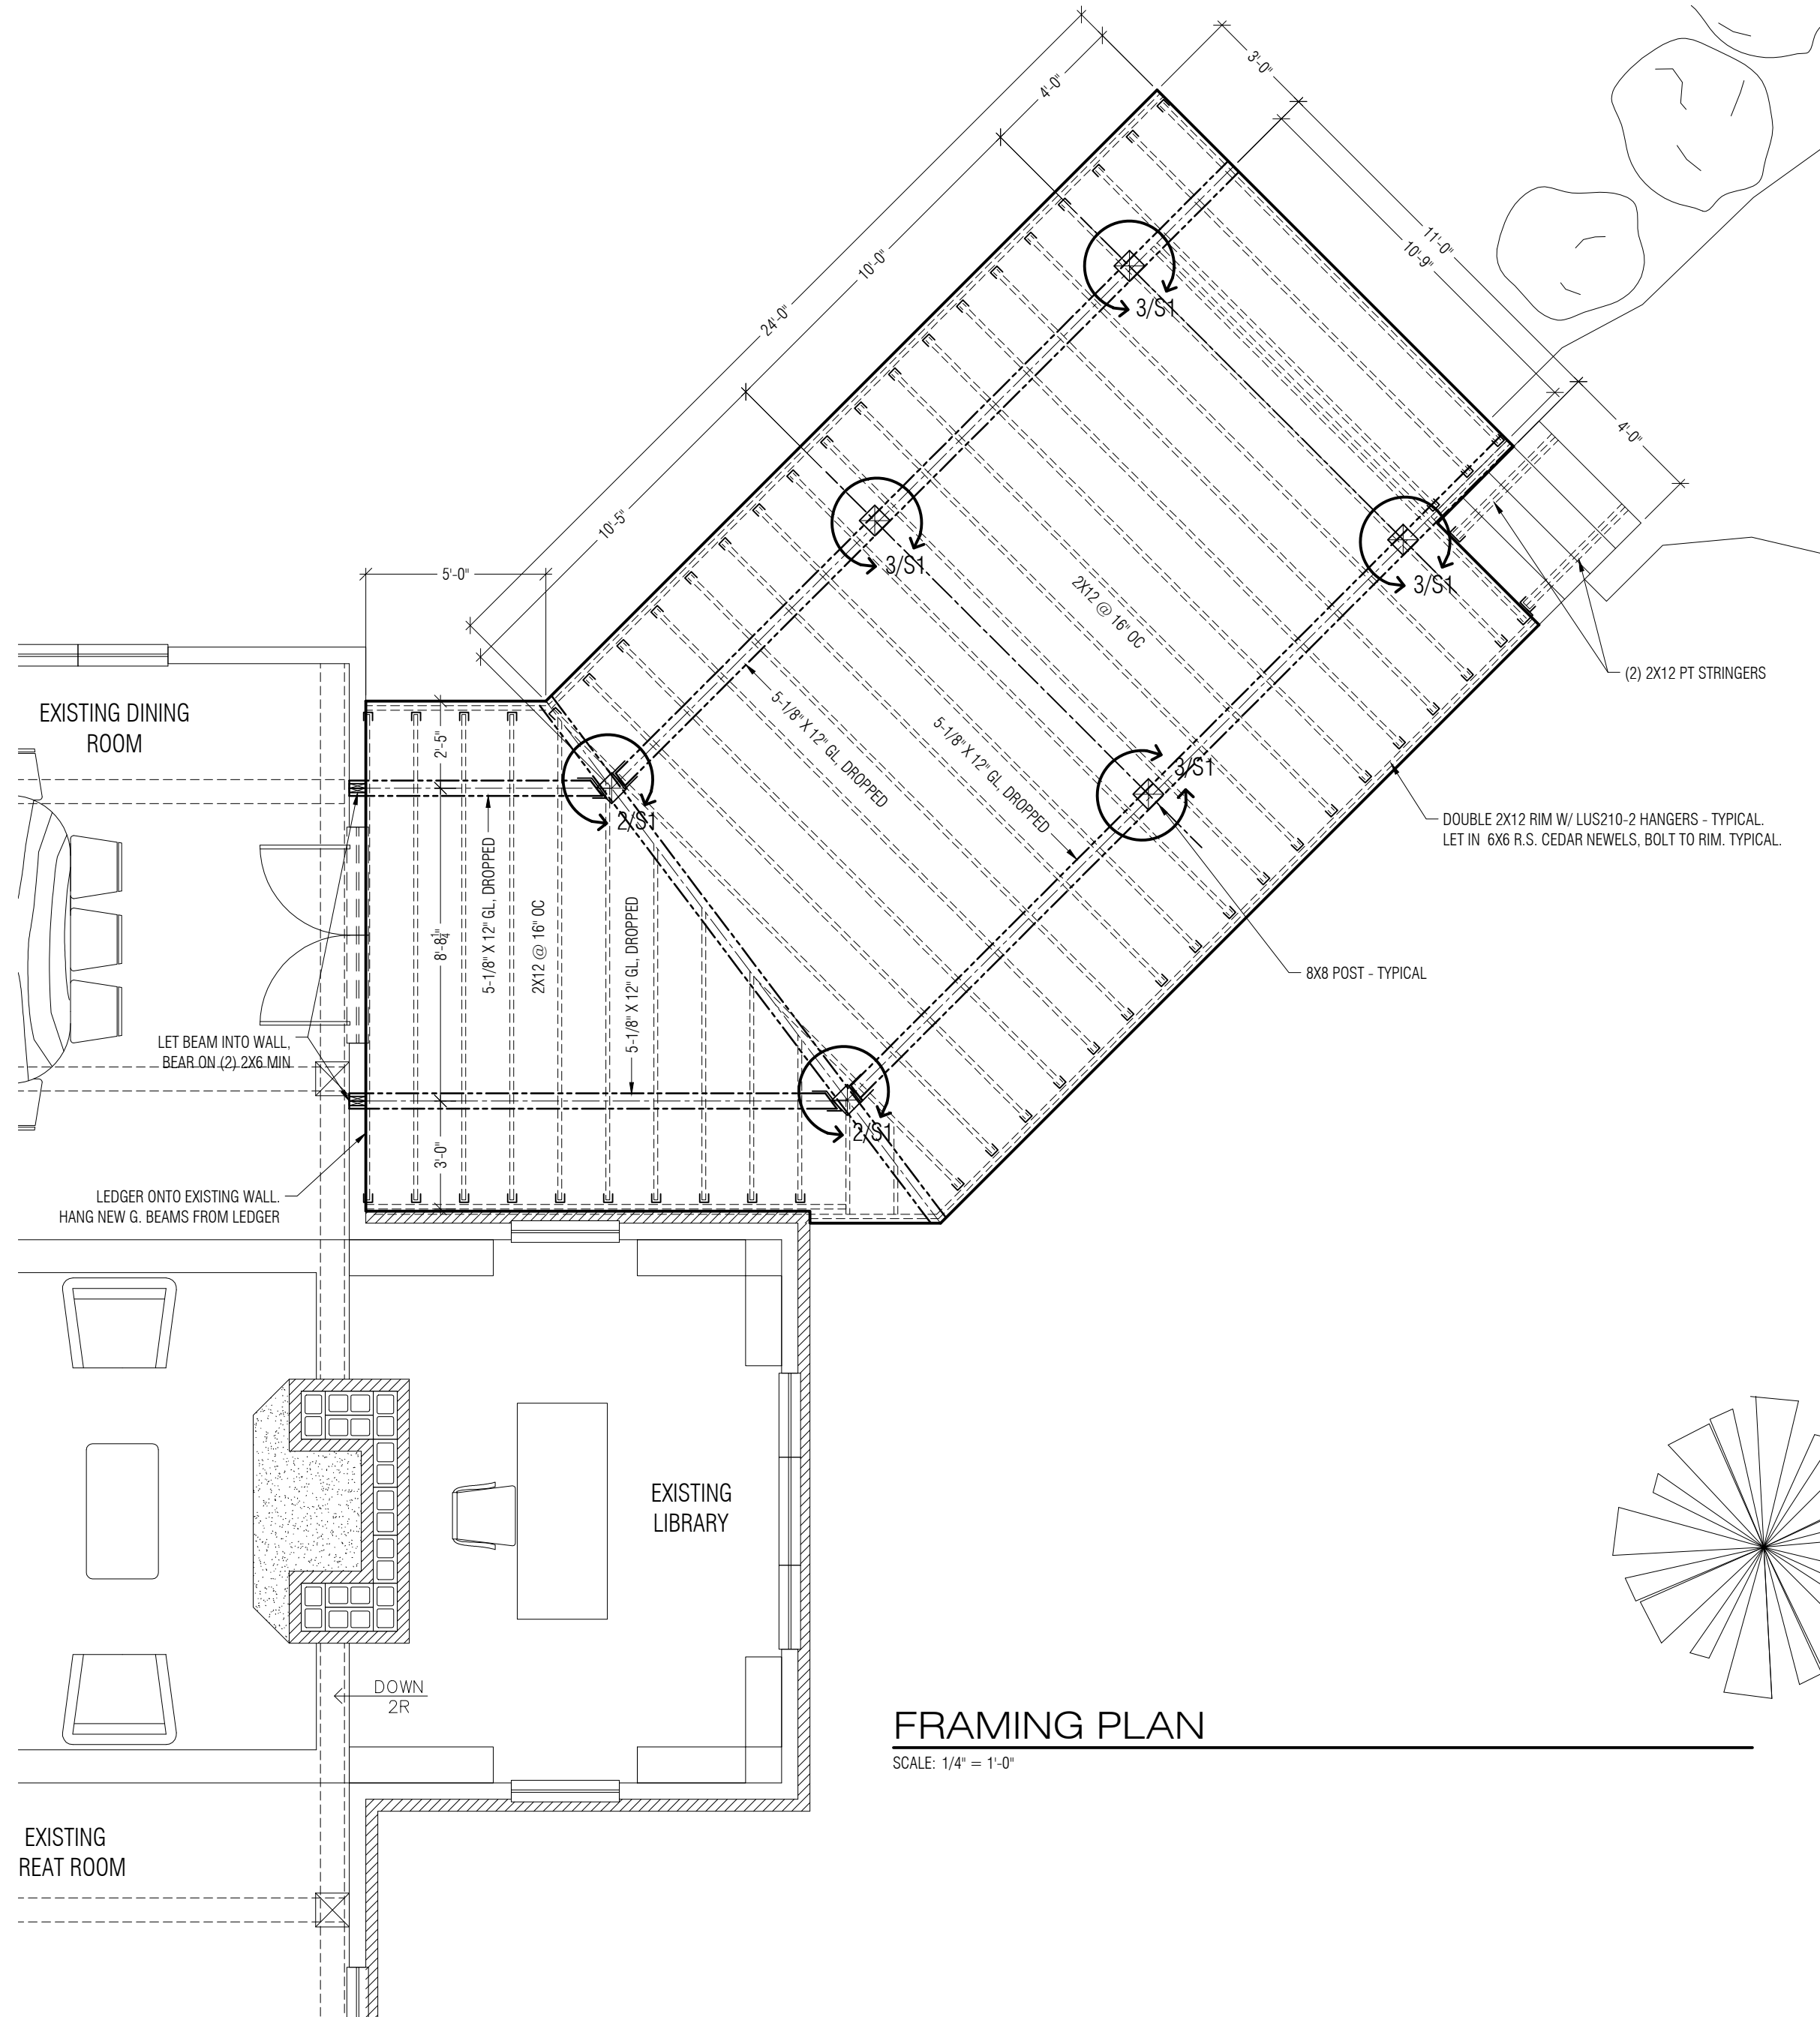

FRAMING PLAN
SCALE: 1/4" = 1'-0"

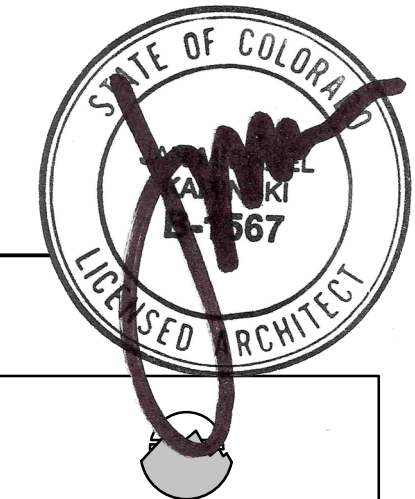

MOUNTAIN
ARCHITECTURE
•
DESIGN
GROUP
P.C.

JAN MICHAEL KAMRICK, PRESIDENT
ARCHITECT

P.O. BOX 170429
DENVER, COLORADO 80217
(303) 879-5184
(303) 879-5184 FAX
jan@mtarch.com - Email

©

A Deck Addition
ROBERT DOWSKI
27285 E. Whitewood Drive
Lot 23, Whitewood Subdivision, Aspen Highlands
Routt County, Colorado

TITLE
Foundation &
Framing Plans

JOB NO. 1621
DRAWN clk
CHECKED jmk
DATE 11.10.16
REVISIONS:
NO. DATE

DRAWING NUMBER
S1
OF 3 DRAWINGS