


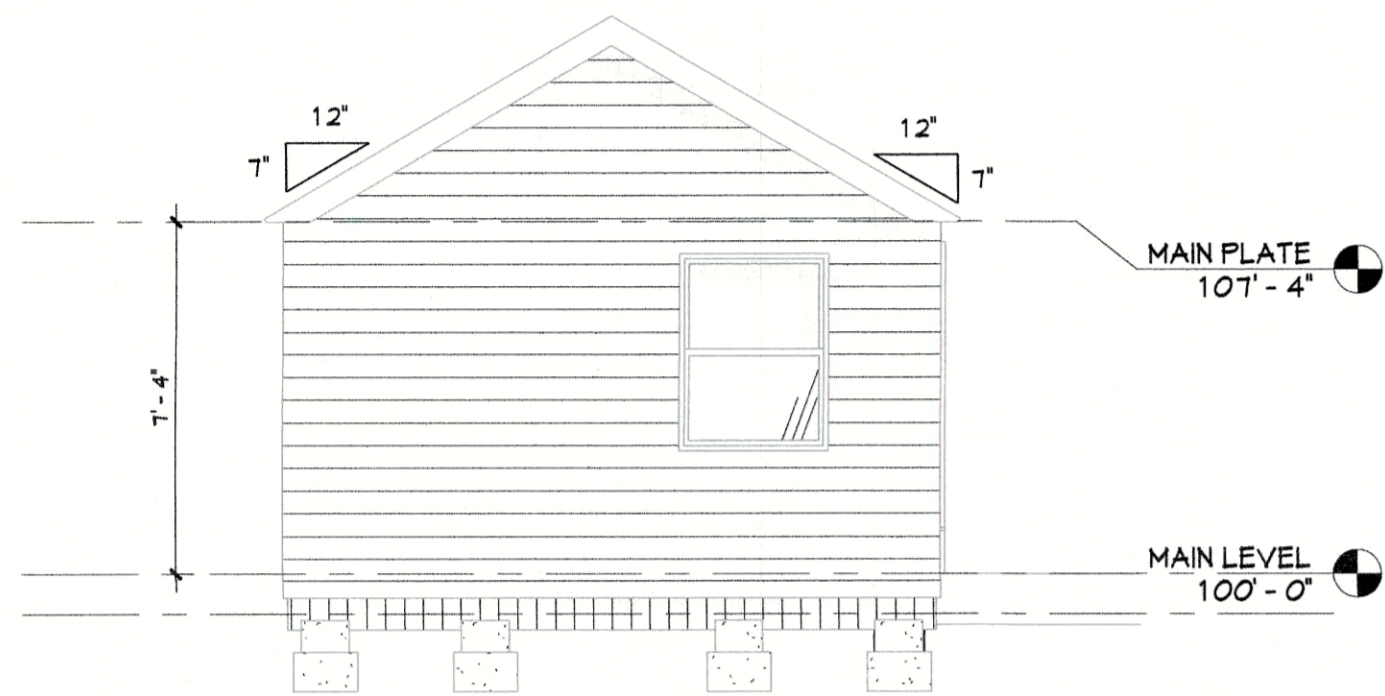


11/2/2017 2:59:43 PM H:\proj\osadchuk\TRAILERS\Trailer S.rvt


3 East  
1/4" = 1'-0"




4 MAIN LEVEL FLOOR PLAN  
1/4" = 1'-0"

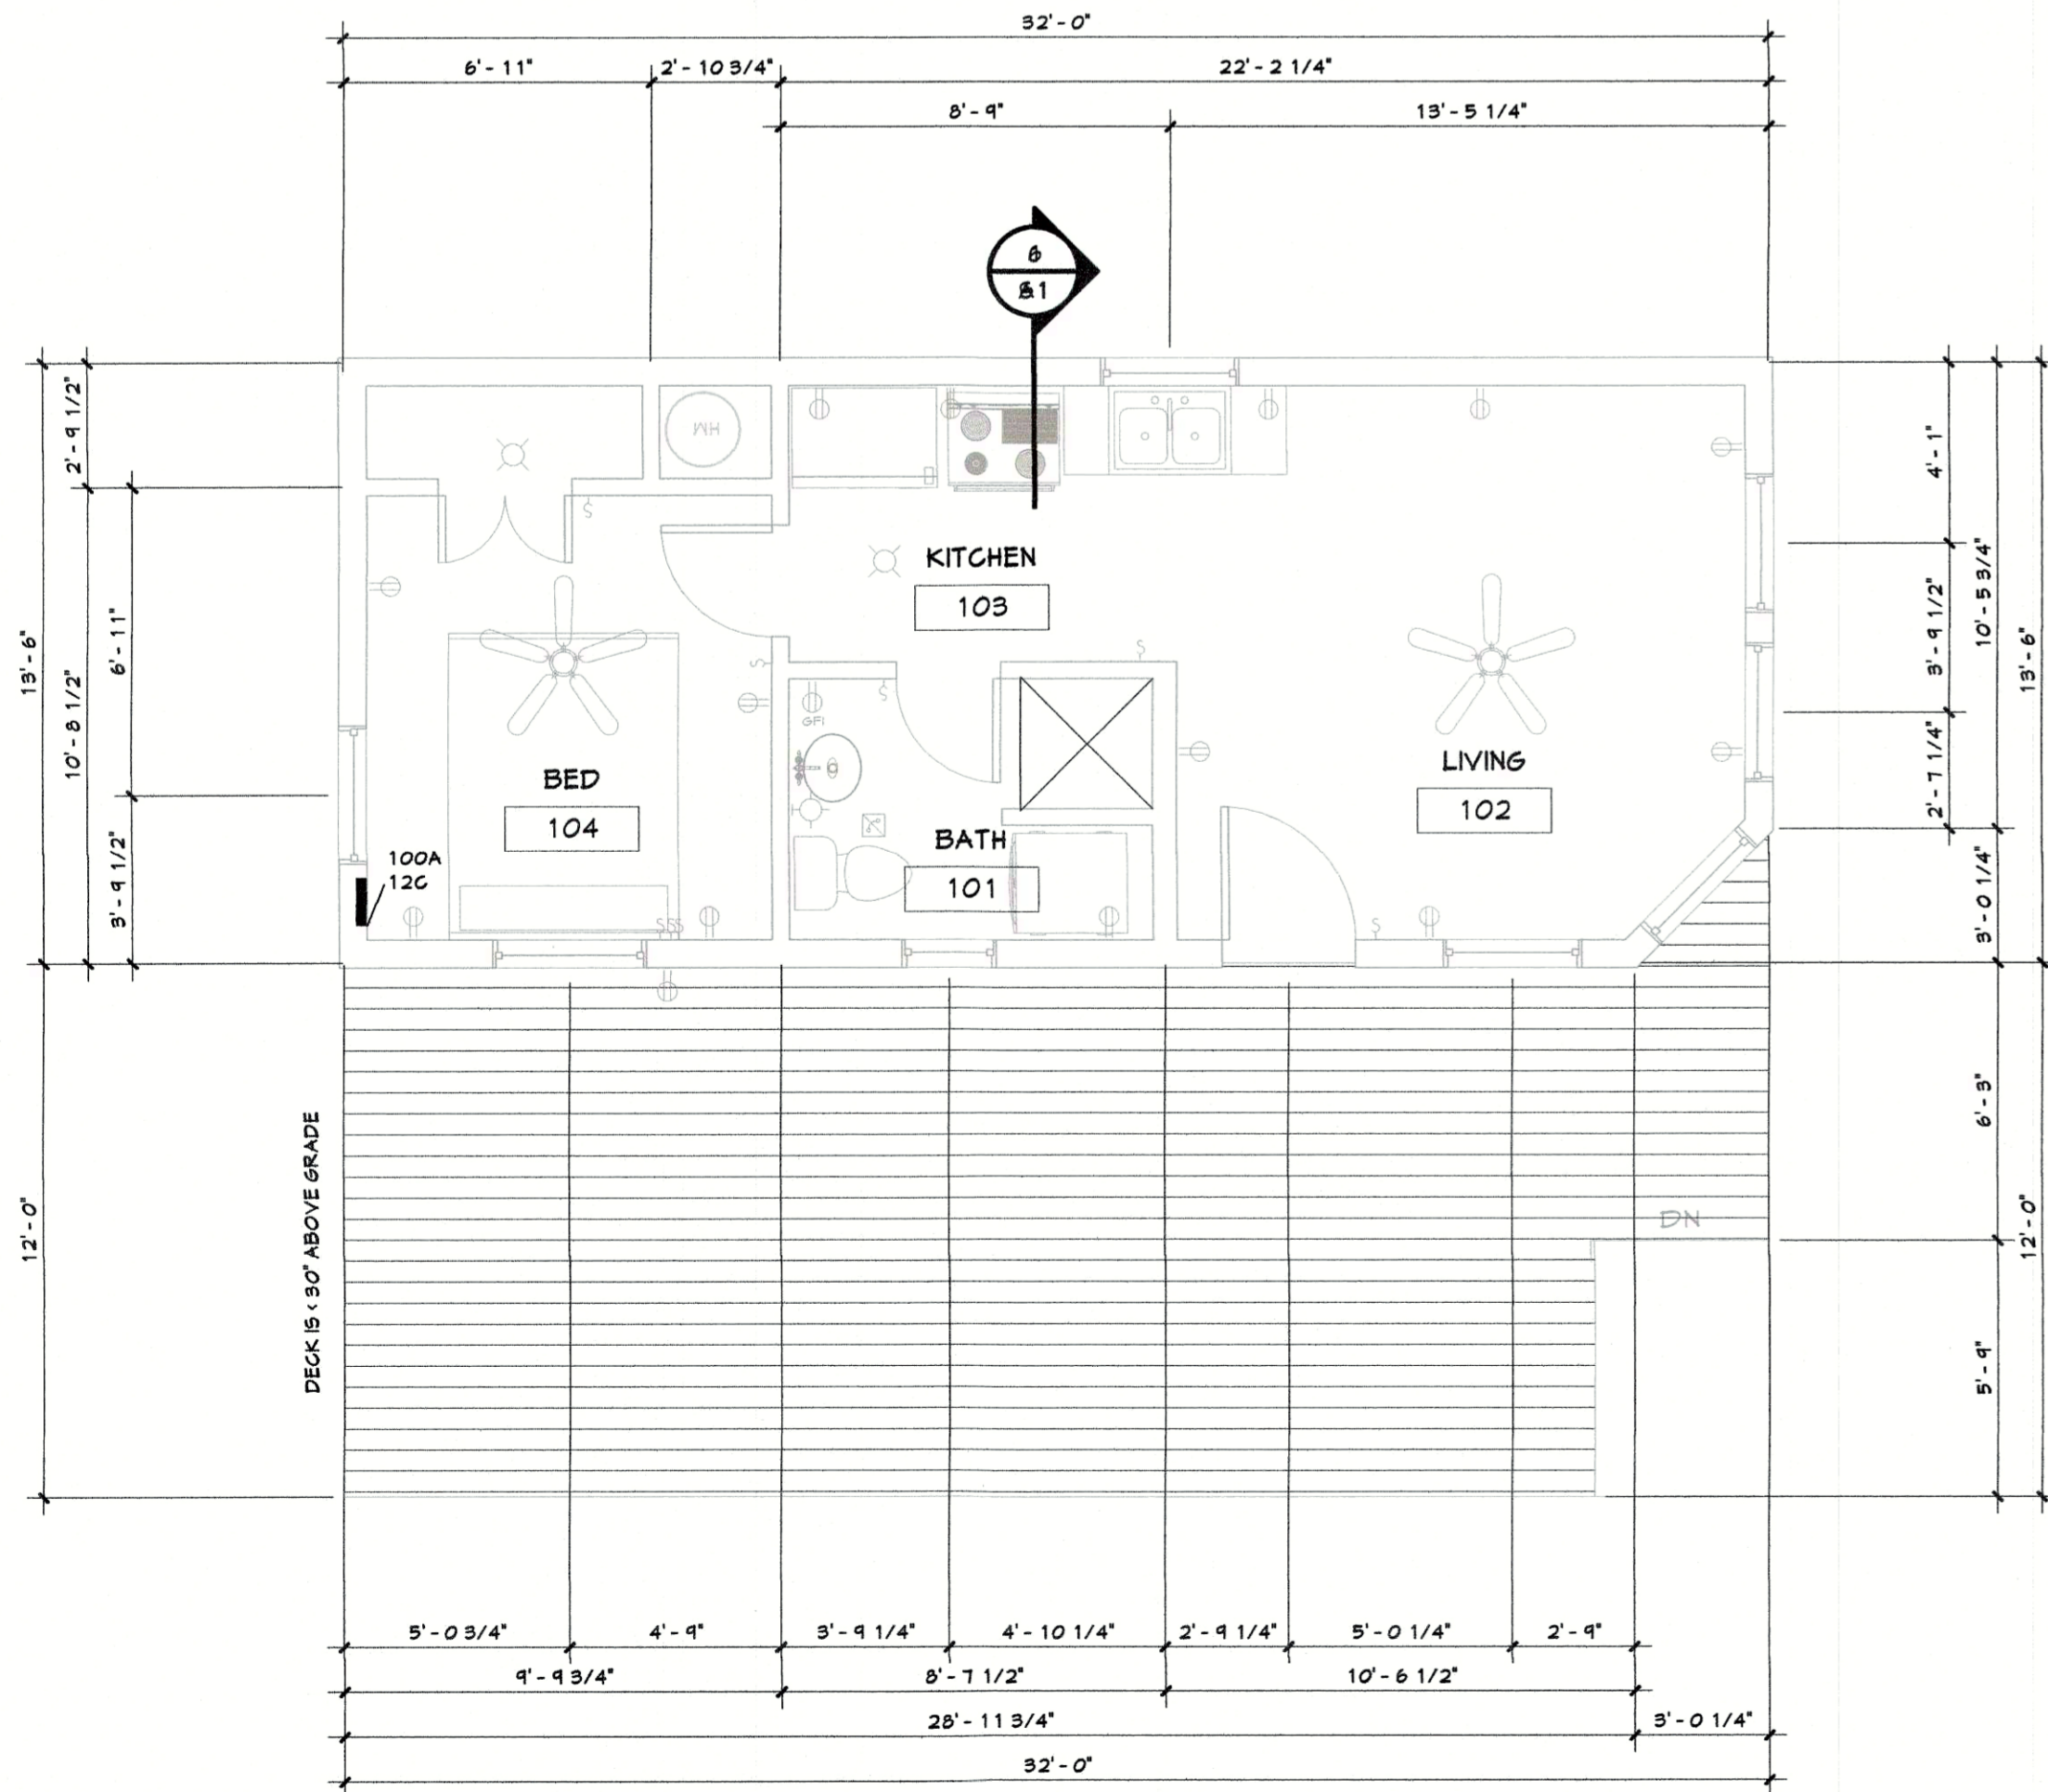


7 West  
1/4" = 1'-0"

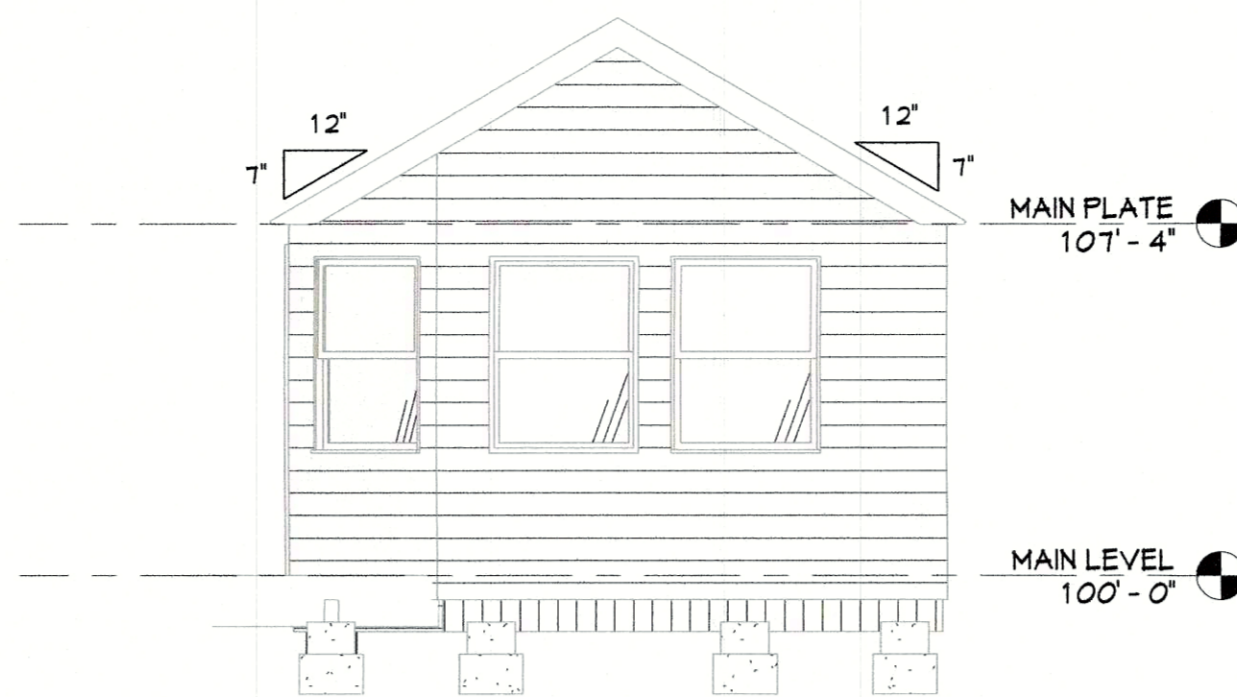



2 FOUNDATION & FRAMING PLAN  
1/4" = 1'-0"

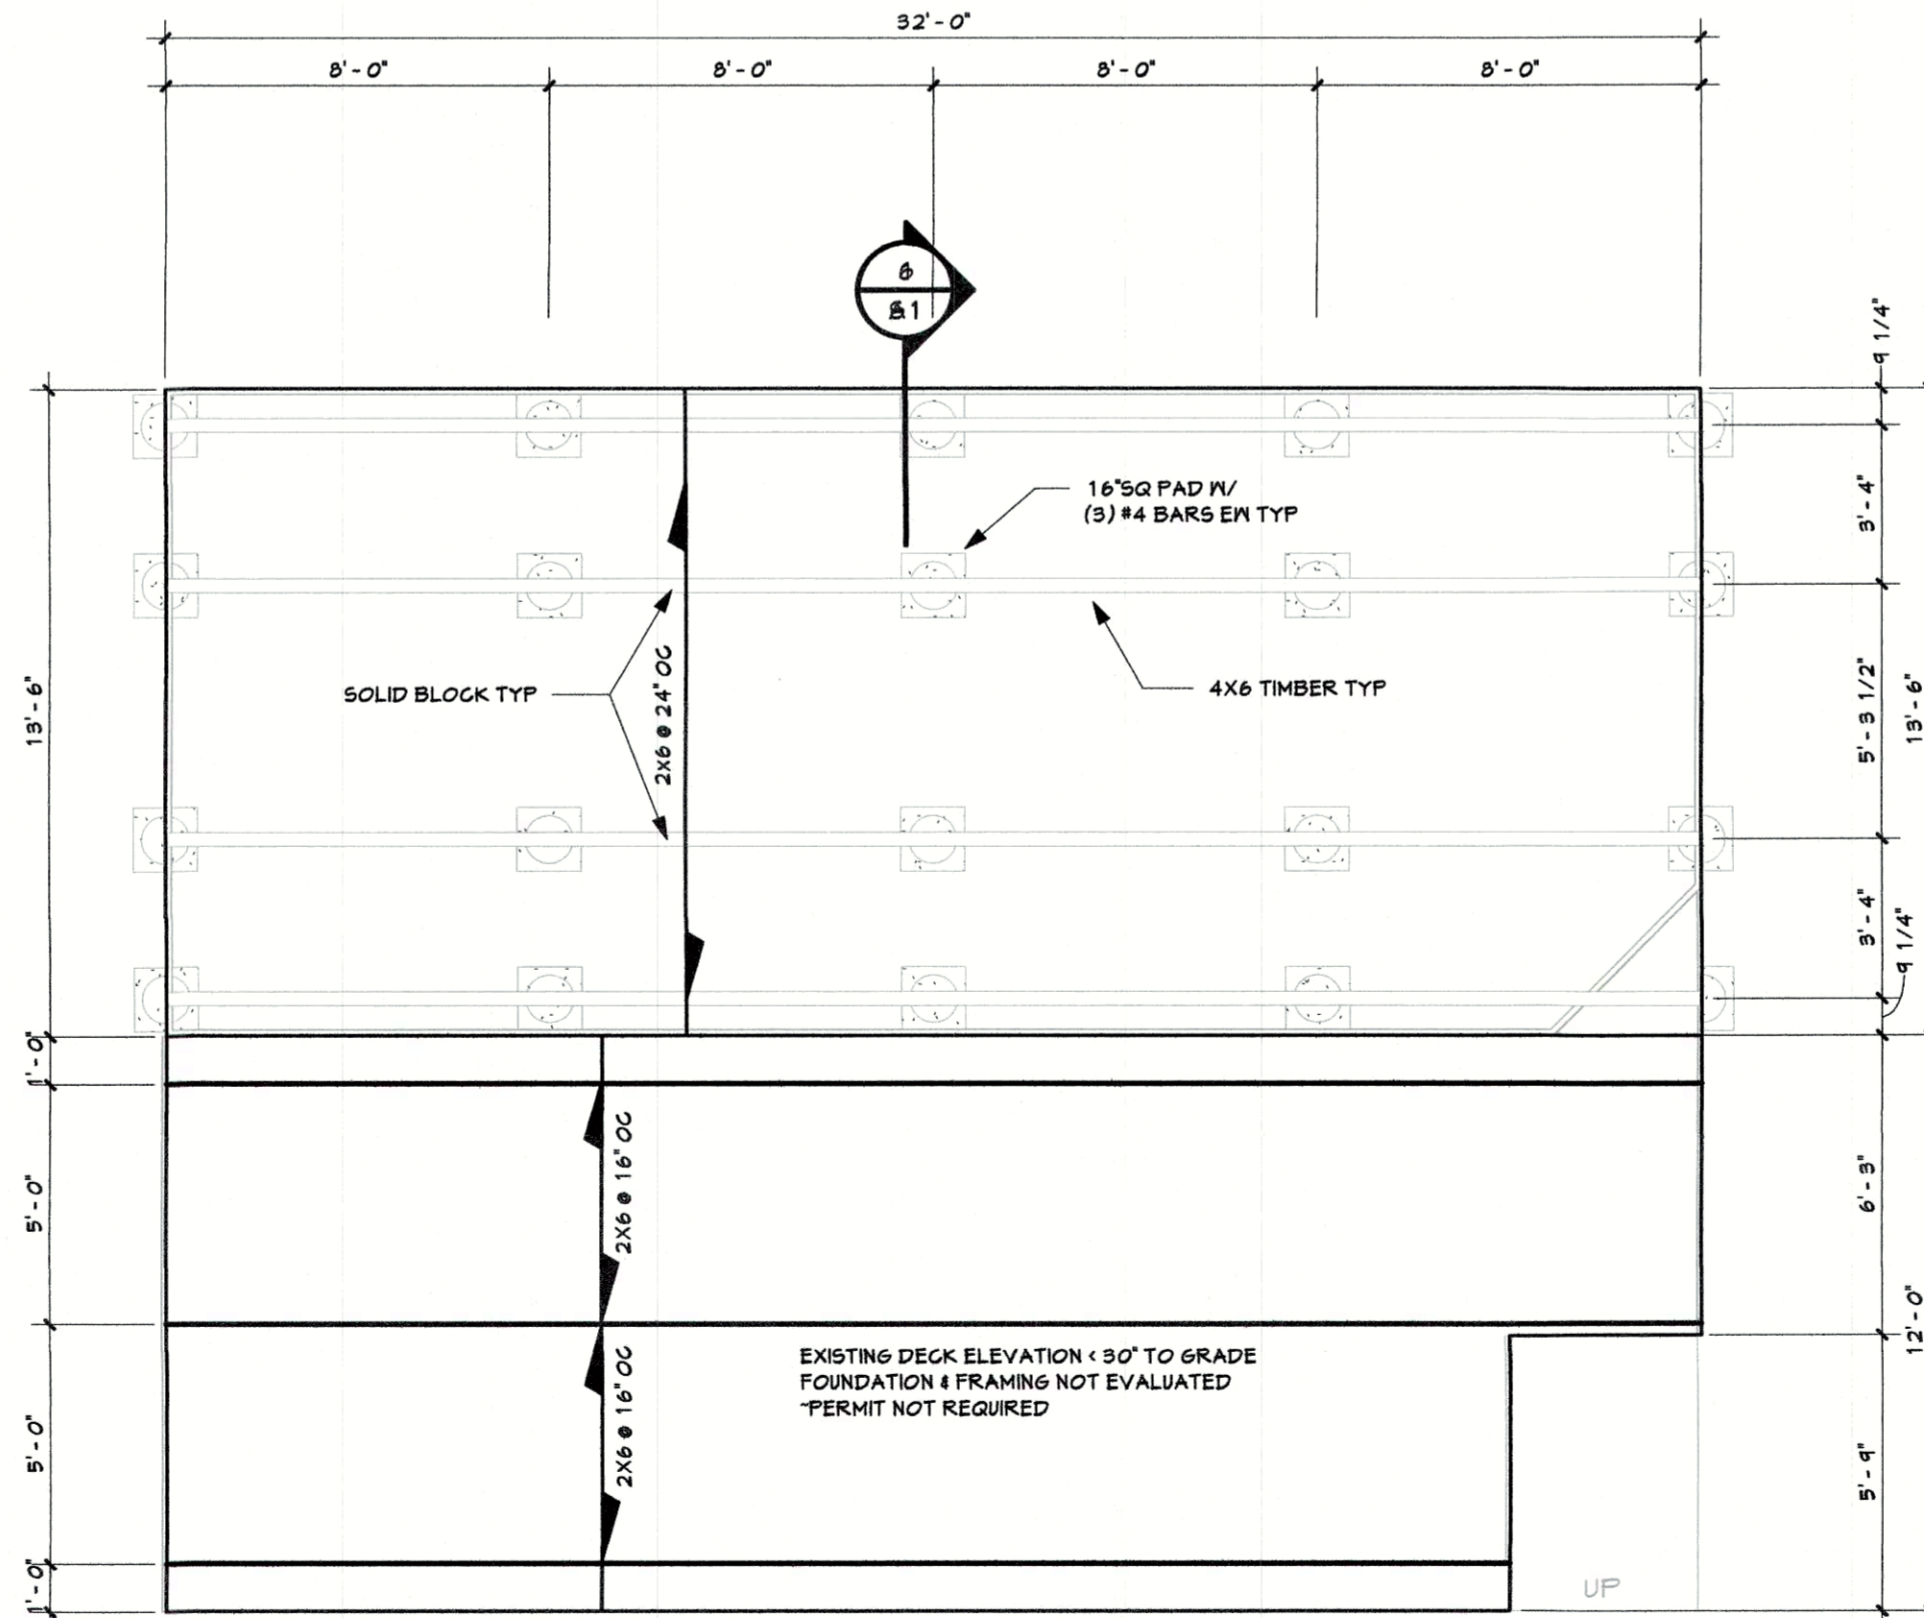

1 EXISTING CONDITIONS SECTION  
1/4" = 1'-0"

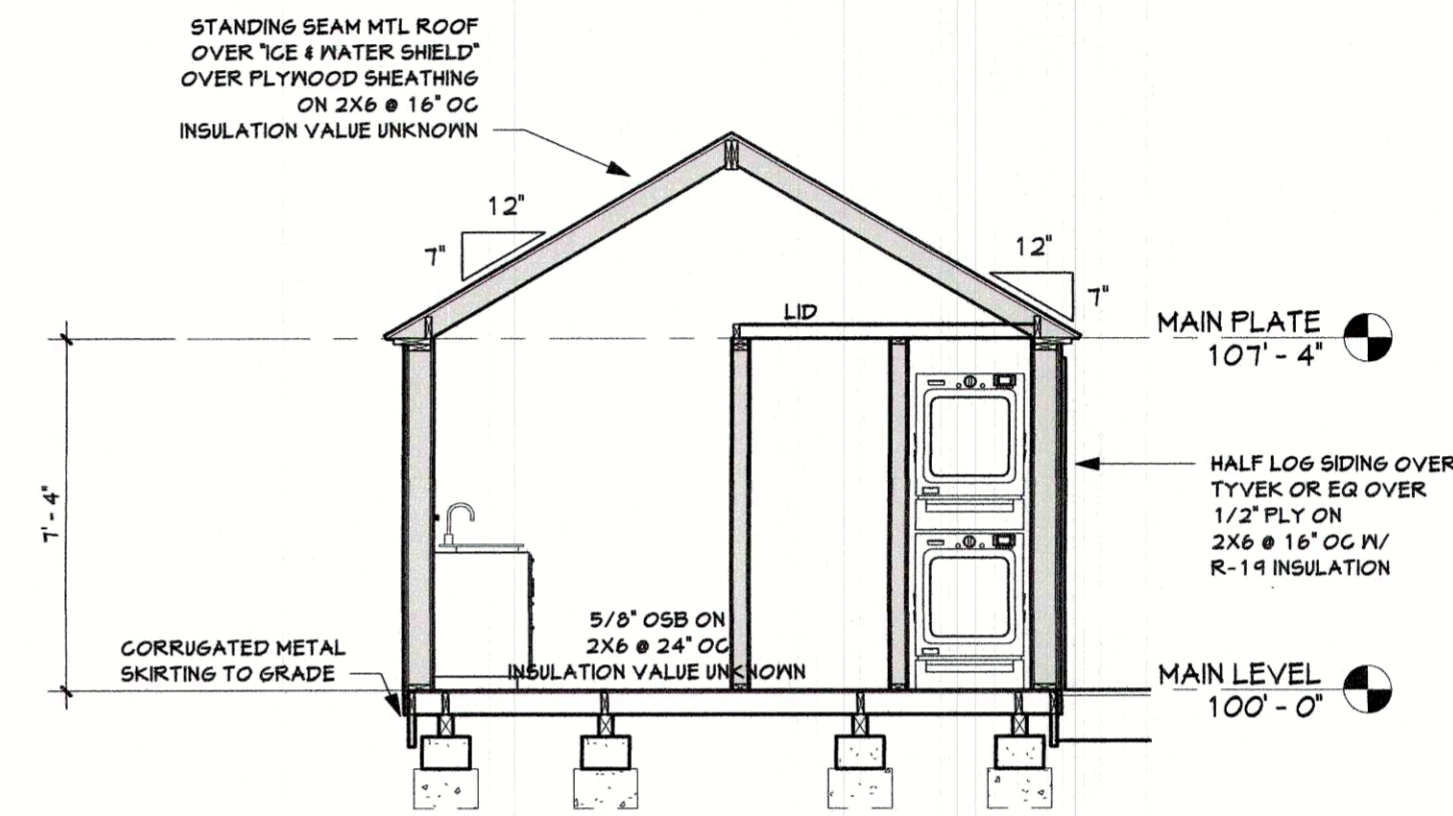

8 ROOF FRAMING PLAN  
1/4" = 1'-0"

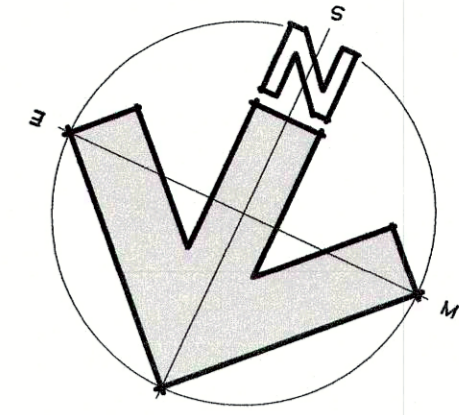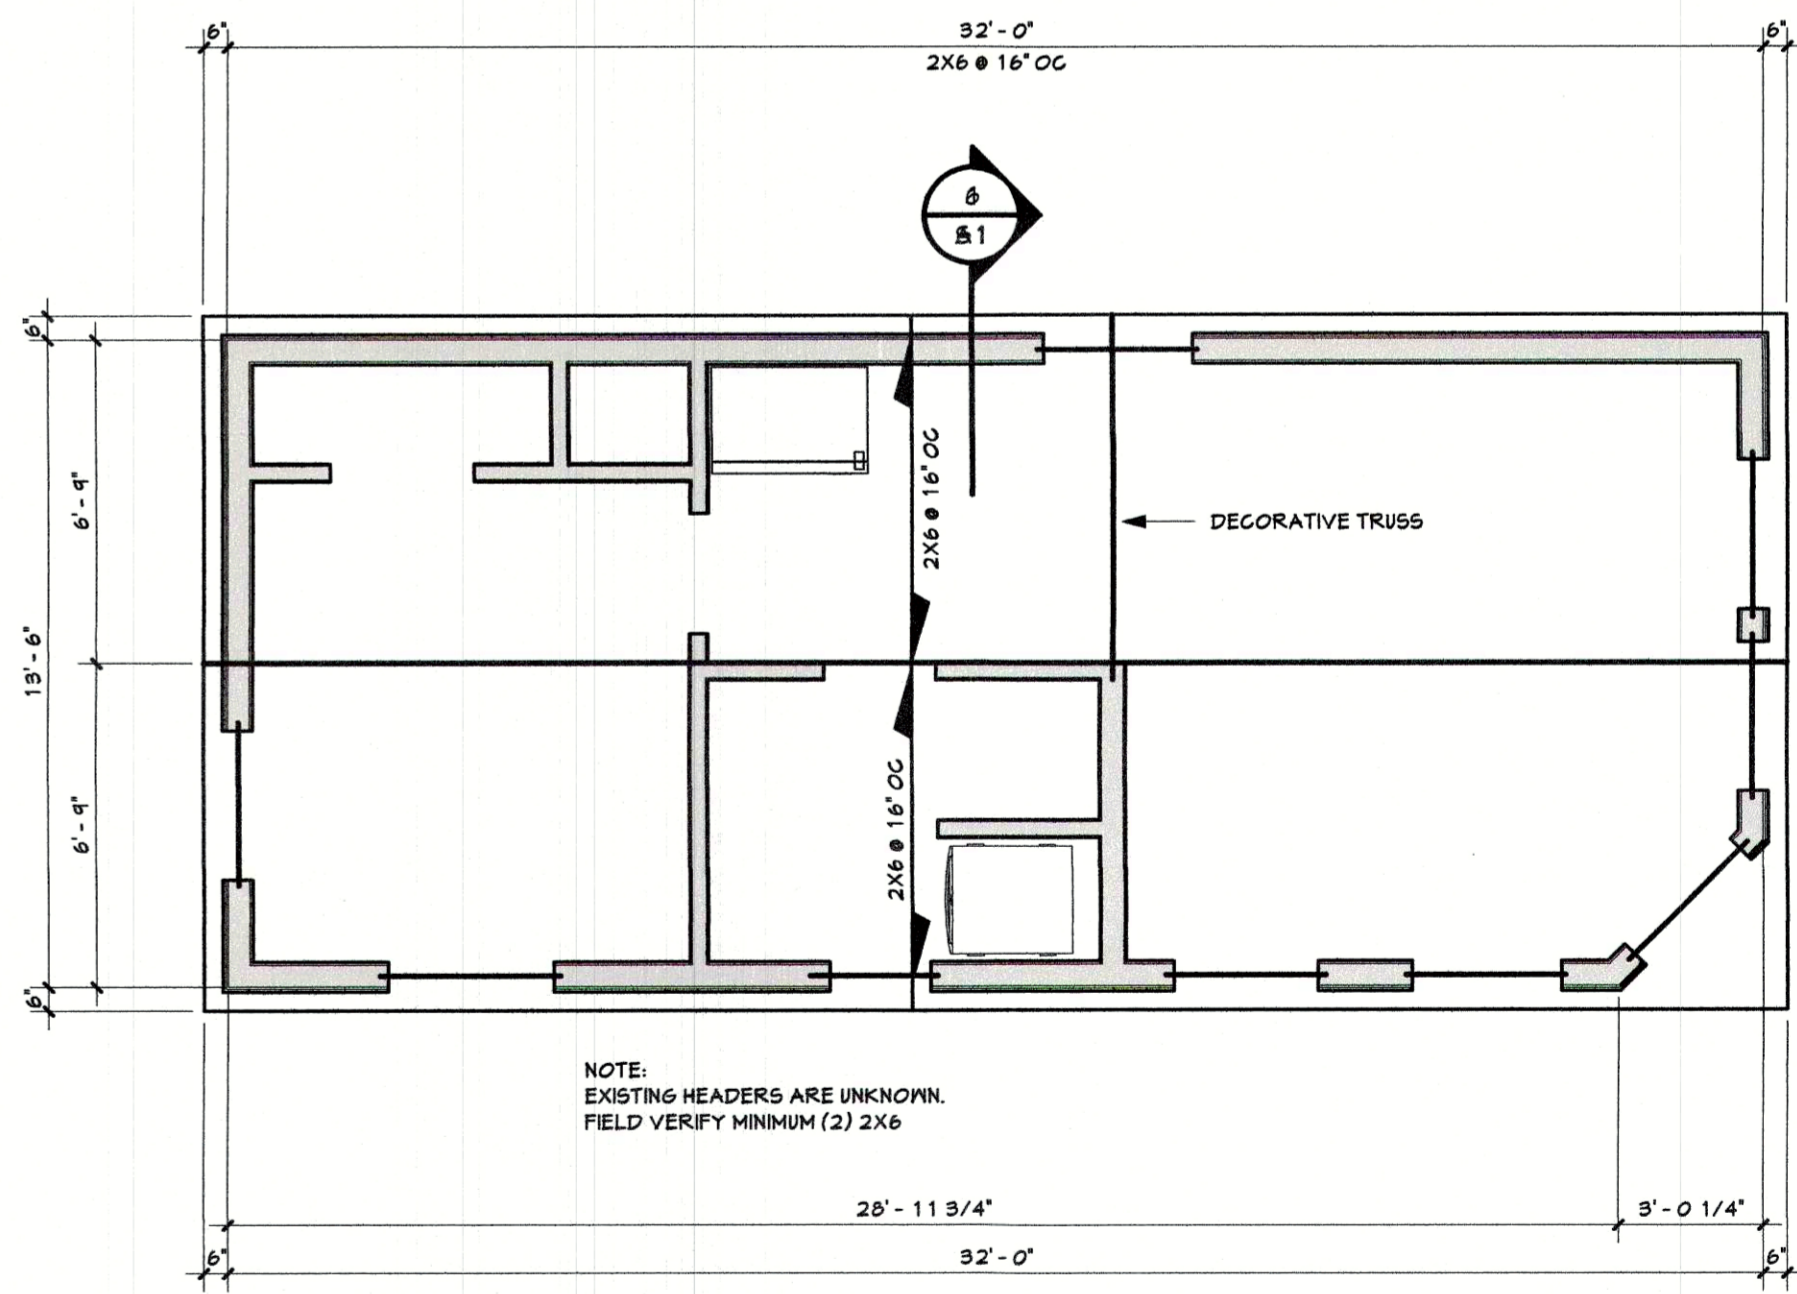

AS BUILT FLOOR PLANS, ELEVATIONS, & SECTION FOR  
**DWAYNE MOSADCHUK TRUST, C2 & C3**  
28850 TOBIANO TRL  
ROUTT COUNTY CO  
OWNER/ CONTRACTOR 846-5592

Job # 17.050  
File 17.050A10  
Date 2NOV17  
Drawn KAB  
Checked JMH  
Rel'd 2NOV17  
Rev'd


Sheet Number  
**A 1**  
SHEET 2 OF 3

COLORADO LICENSED  
Professional Engineer  
30988  
11-2-17  
"STRUCTURE ONLY"


**Jake's**  
CELEBRATING 30 YEARS  
IN BUSINESS 1987-2017

DRAFTING SERVICE INC.  
P.O. BOX 774121  
426 OAK STREET  
STEAMBOAT SPRINGS, COLORADO  
81087-4121  
FAX 970.879.8709  
JAKES@SPRINGSPIE.COM


11/2/2017 2:59:39 PM H:\proj\osadchuk\TRAILERS\Trailer 3.rvt

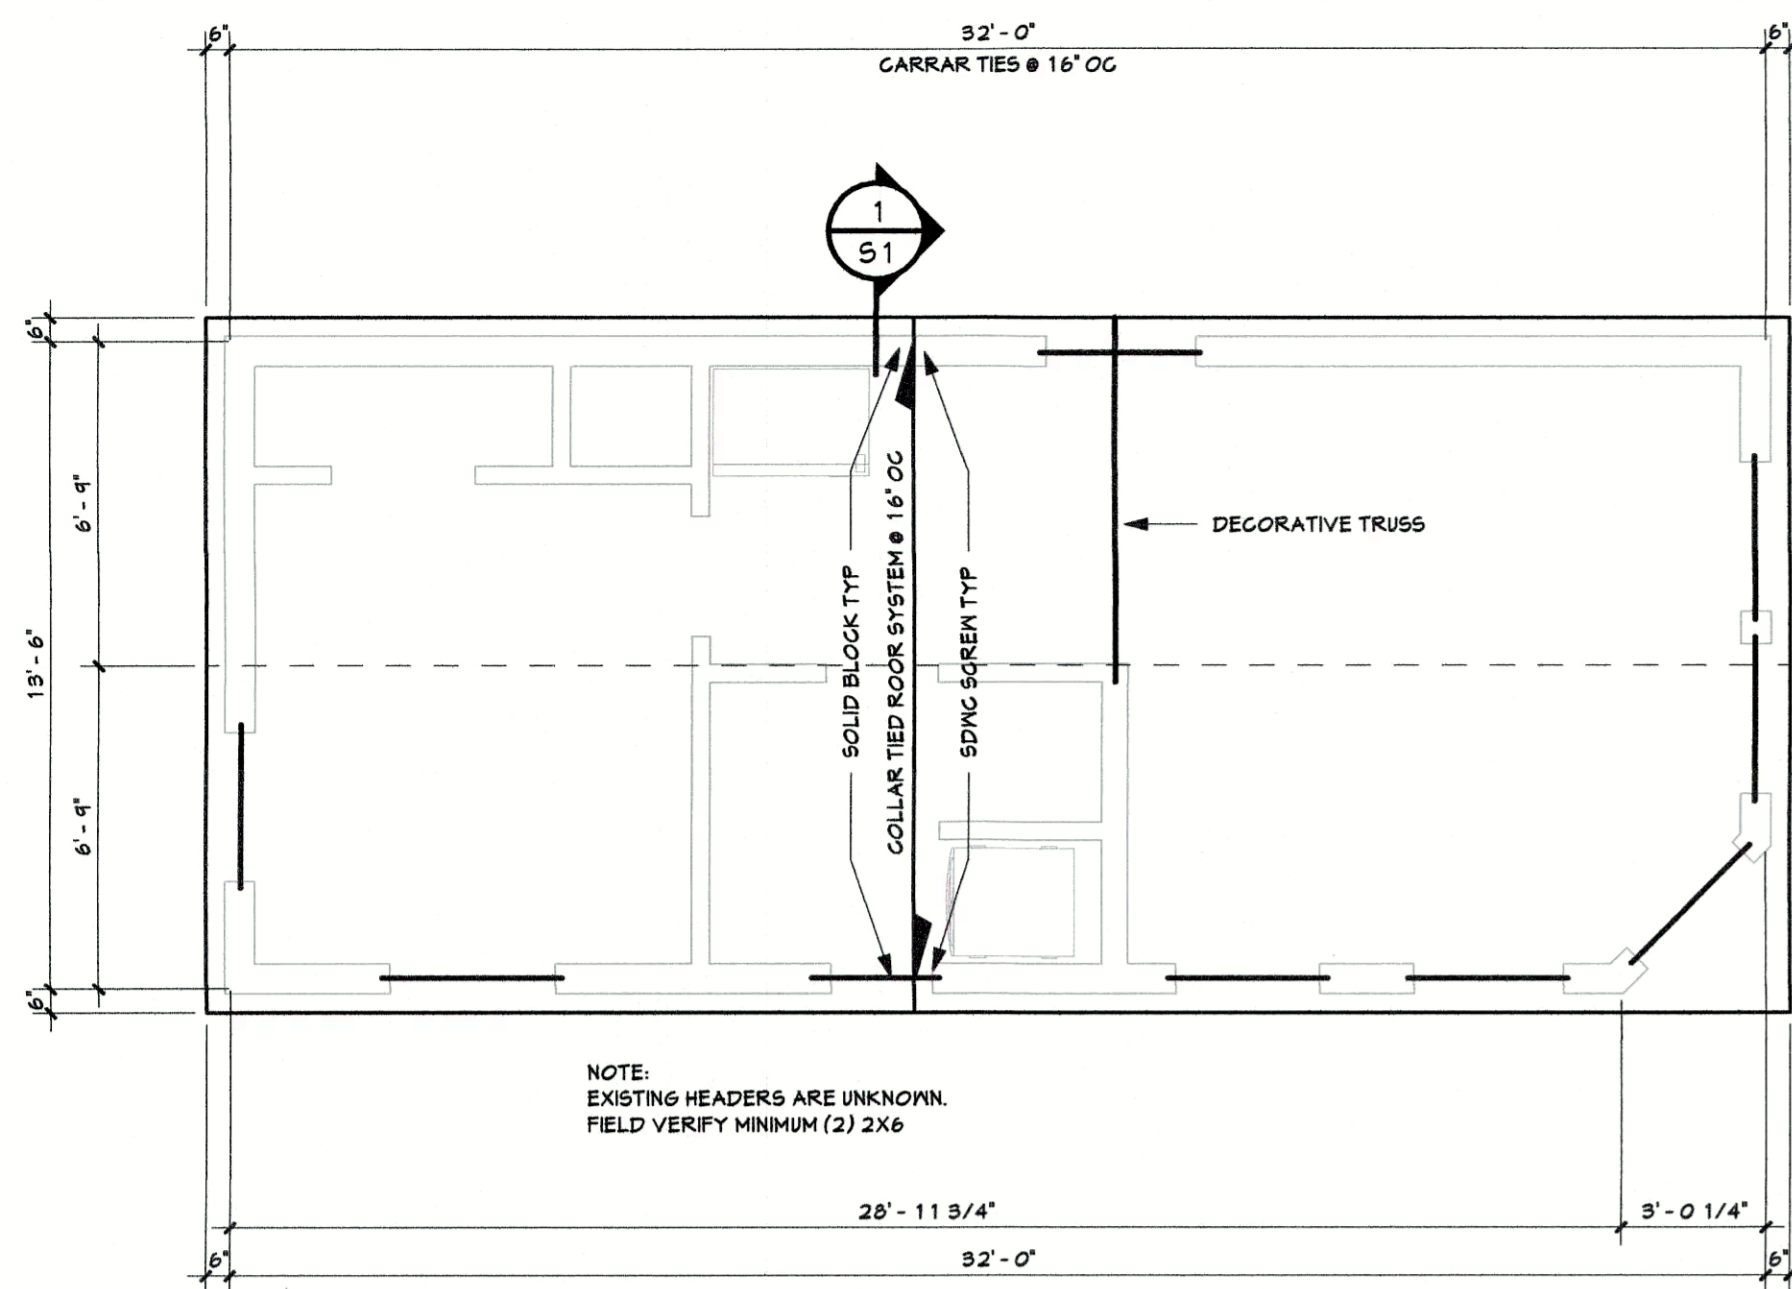


5 ROOF FRAMING REPAIR PLAN  
1/4" = 1'-0"

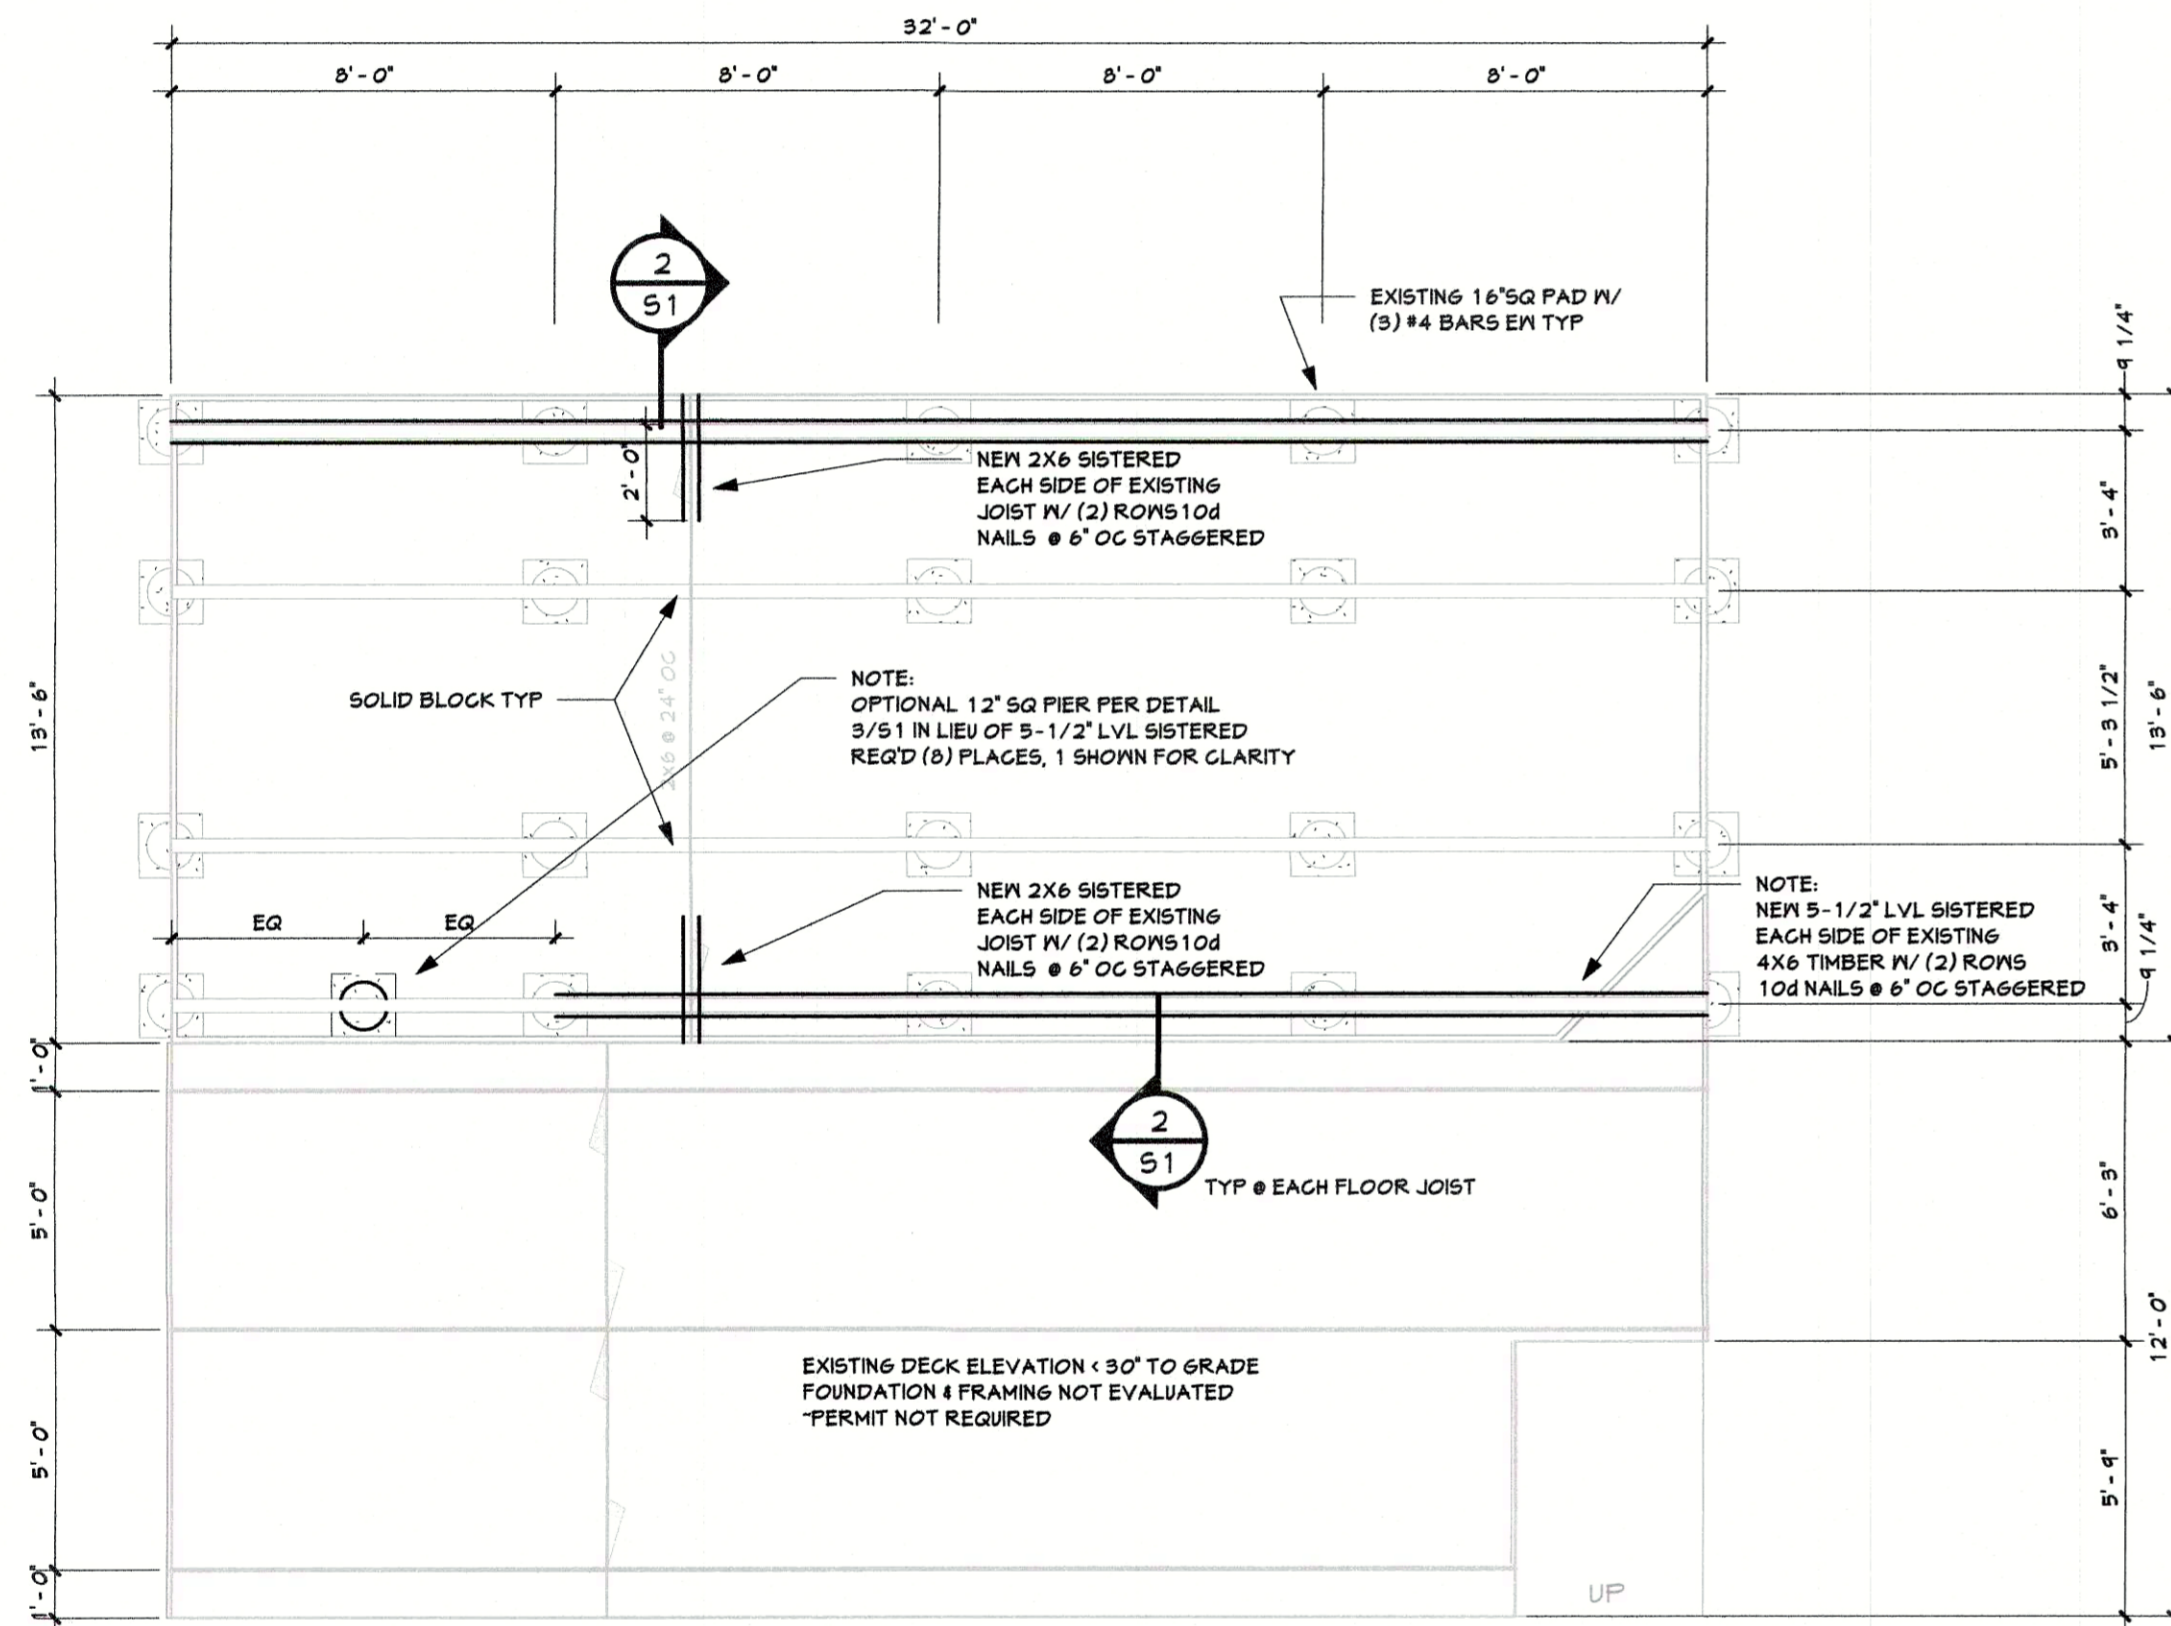


4 FOUNDATION & FRAMING REPAIR PLAN  
1/4" = 1'-0"

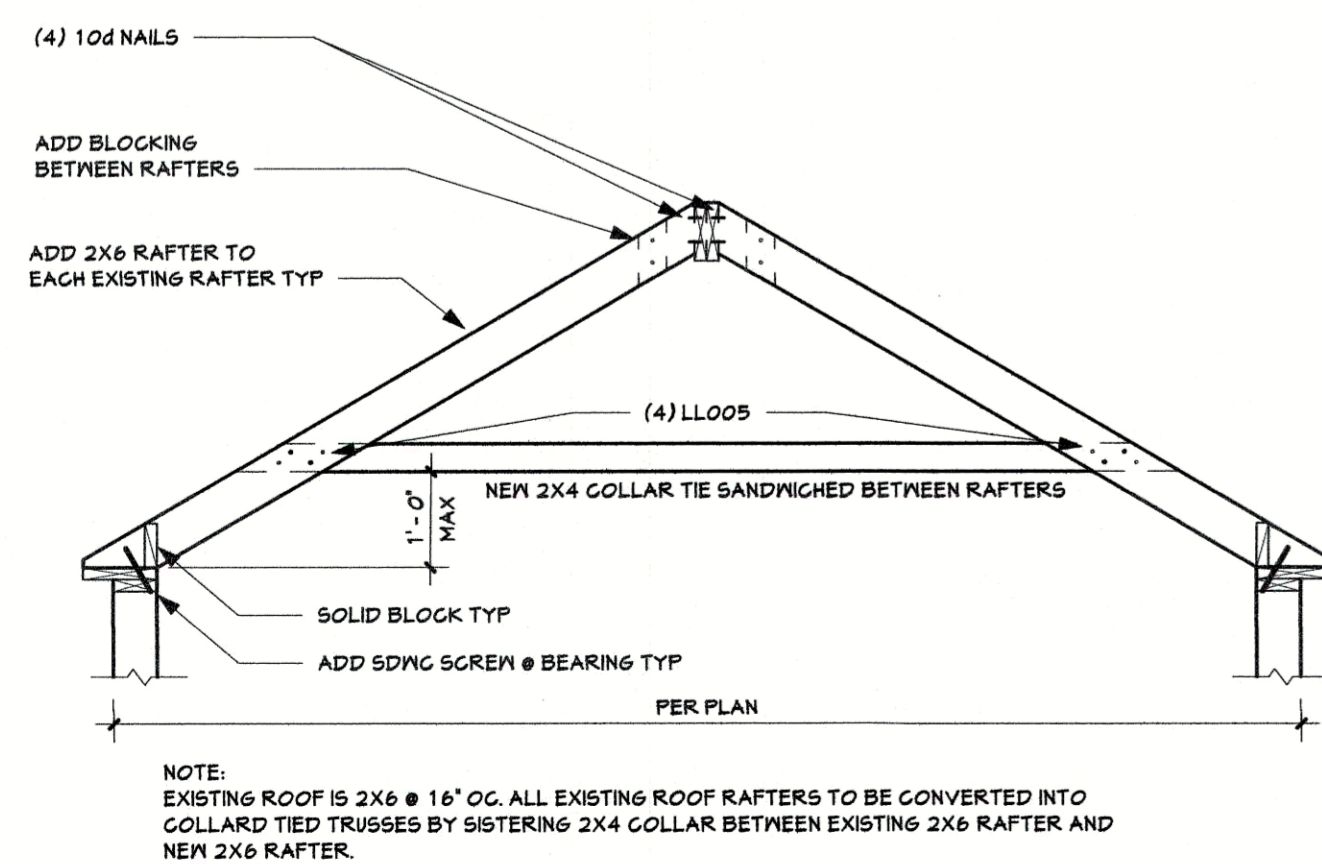


1 COLLAR TIE DETAIL  
1/2" = 1'-0"

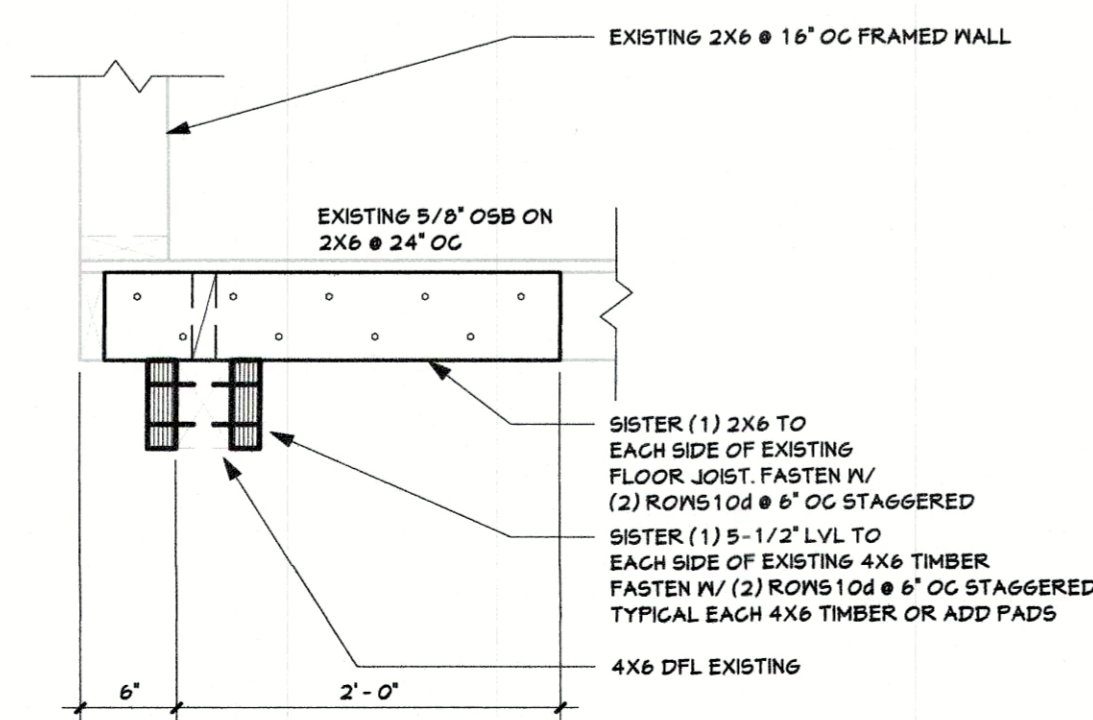

2 RIM DETAIL  
1" = 1'-0"

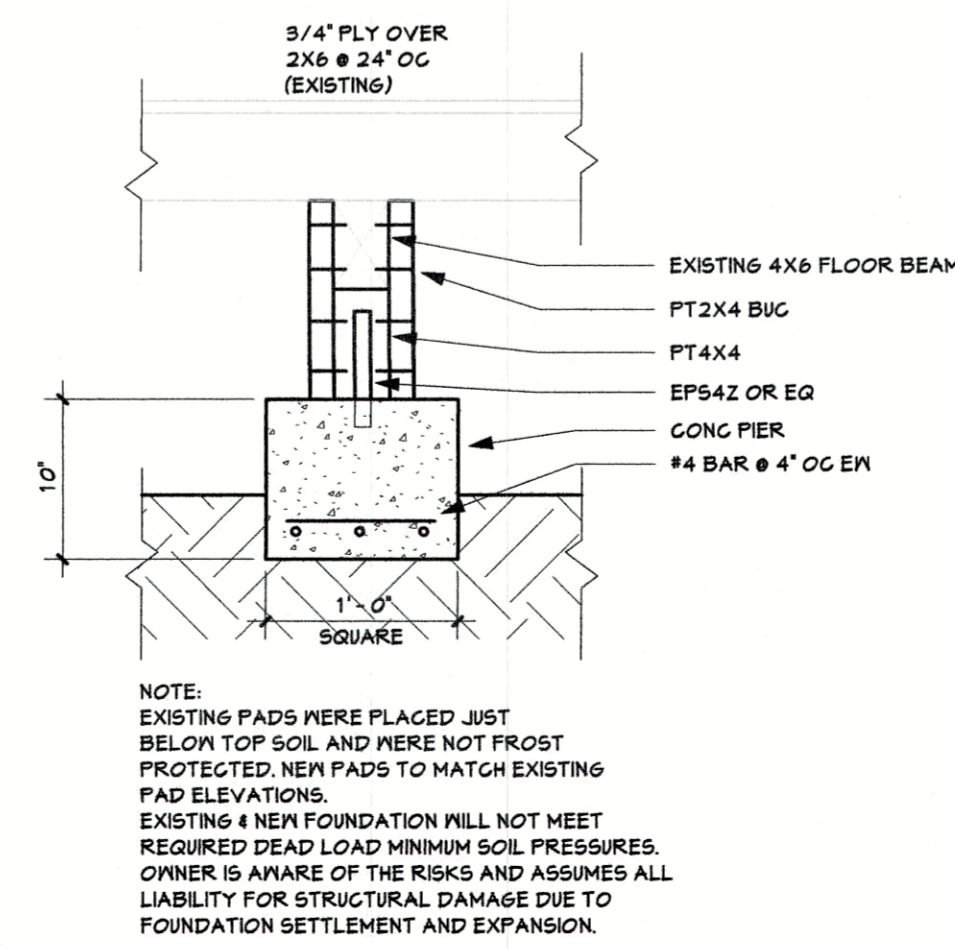

3 OPTIONAL PAD DESIGN  
1" = 1'-0"

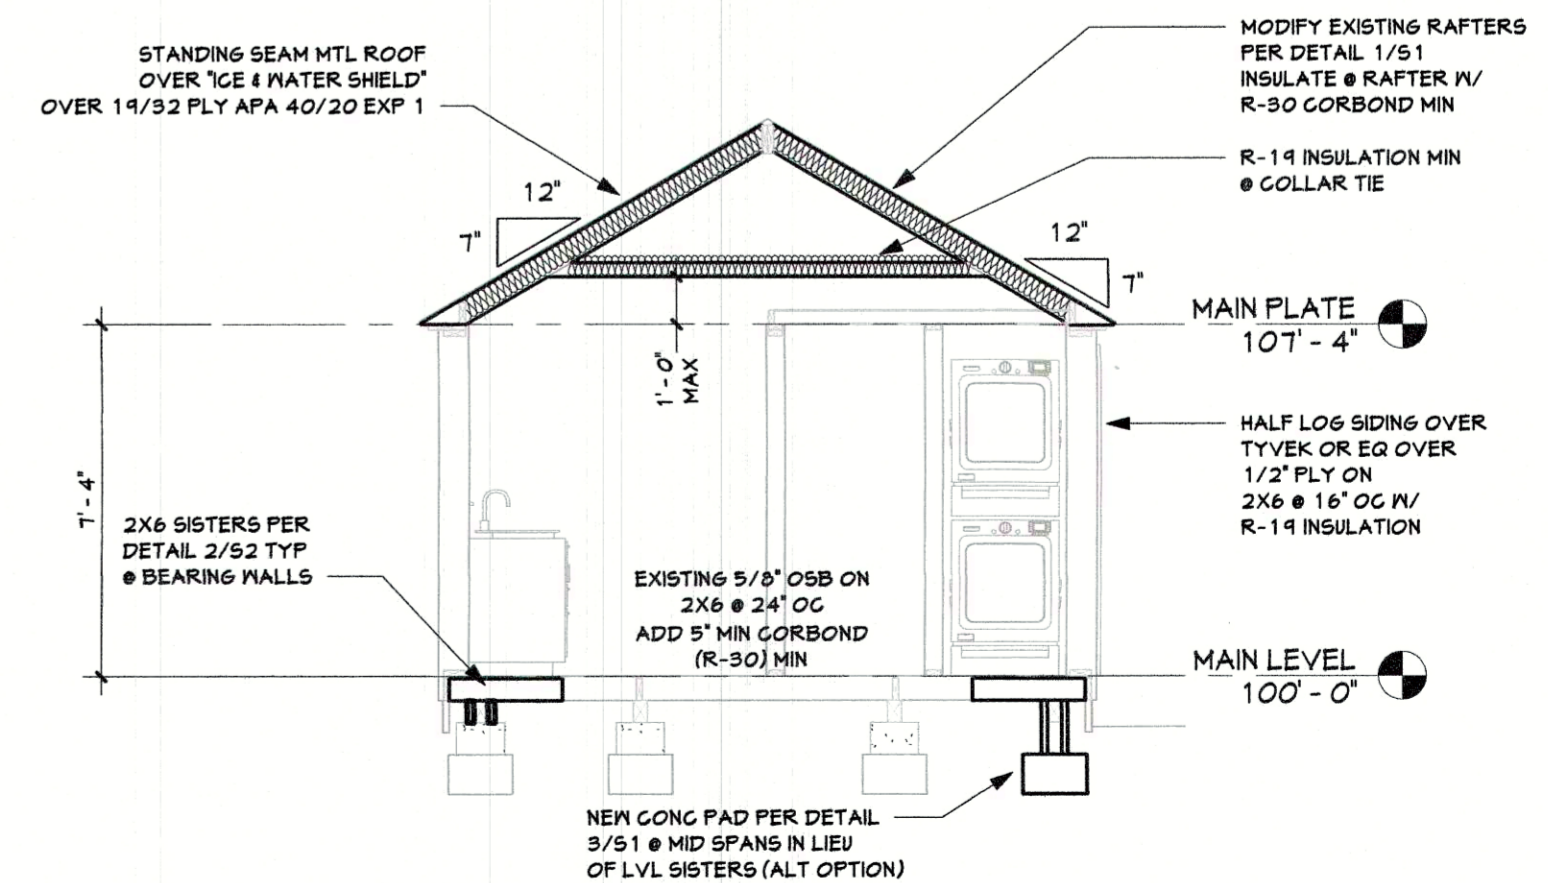

6 NEW TYP SECTION  
1/4" = 1'-0"

DRAFTING SERVICE INC.  
P.O. BOX 774121  
426 OAK STREET  
STEAMBOAT SPRINGS, COLORADO  
970.879.7429  
FAX 970.879.8709  
JAKES@SPRINGSIPS.COM

**Jake's**  
CELEBRATING 30 YEARS  
IN BUSINESS 1987-2017

COLORADO LICENSED  
Professional Engineer  
11-2-17  
"STRUCTURE ONLY"


REPAIR DETAILS & SPECIFICATIONS  
**DWAYNE M OSADCHUK TRUST, C2 & C3**  
23850 TOBIANO TRL  
ROUTT COUNTY CO  
OWNER/ CONTRACTOR 946-55592

Job # 17.050  
File 17.050510  
Date 2NOV17  
Drawn JMH  
Checked JMH  
Re'd 2NOV17


Sheet Number  
**S 1**  
SHEET 3 OF 3




11/2/2017 2:59:26 PM H:\proj\osadchuk\TRAILERS\Trailer 1.rvt

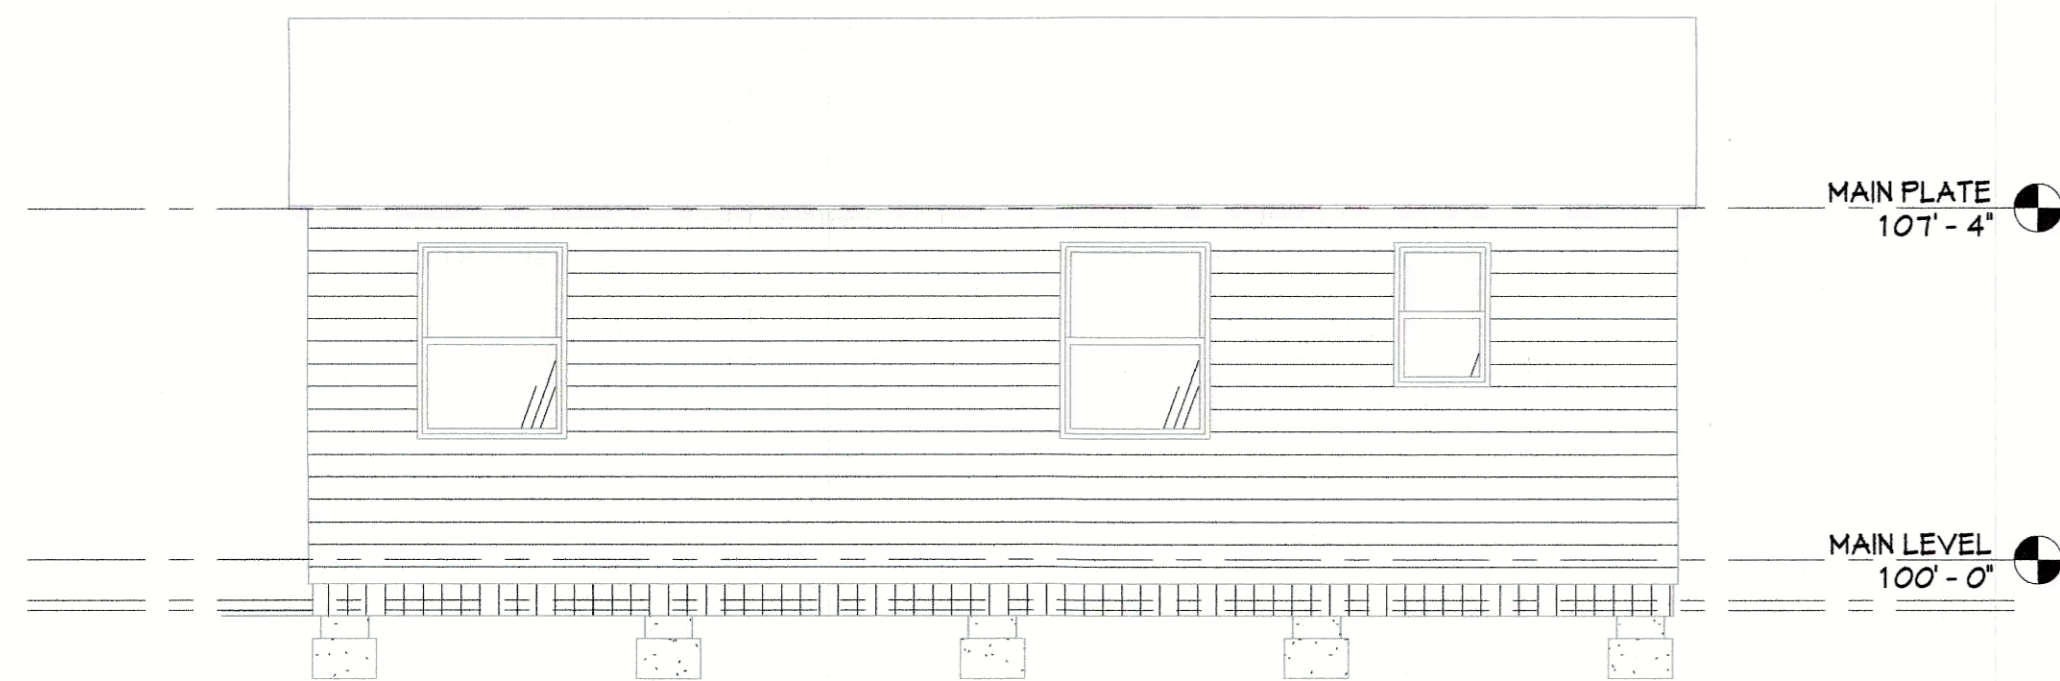


5 North  
1/4" = 1'-0"

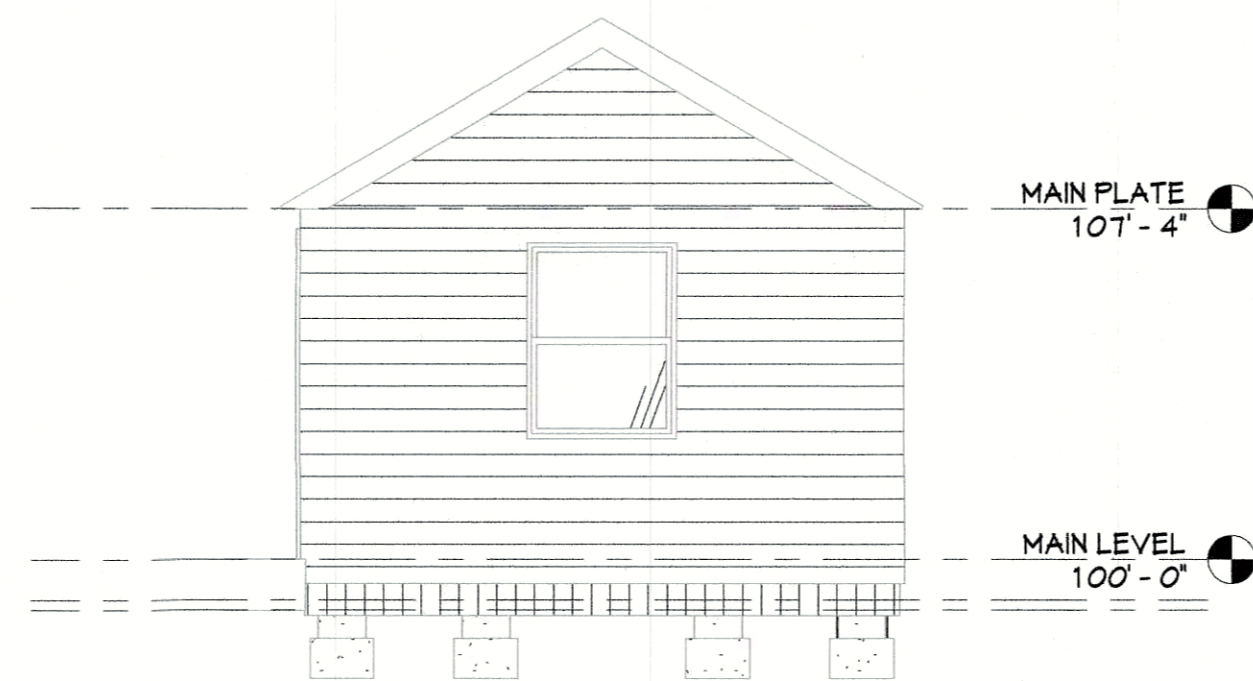


7 West  
1/4" = 1'-0"

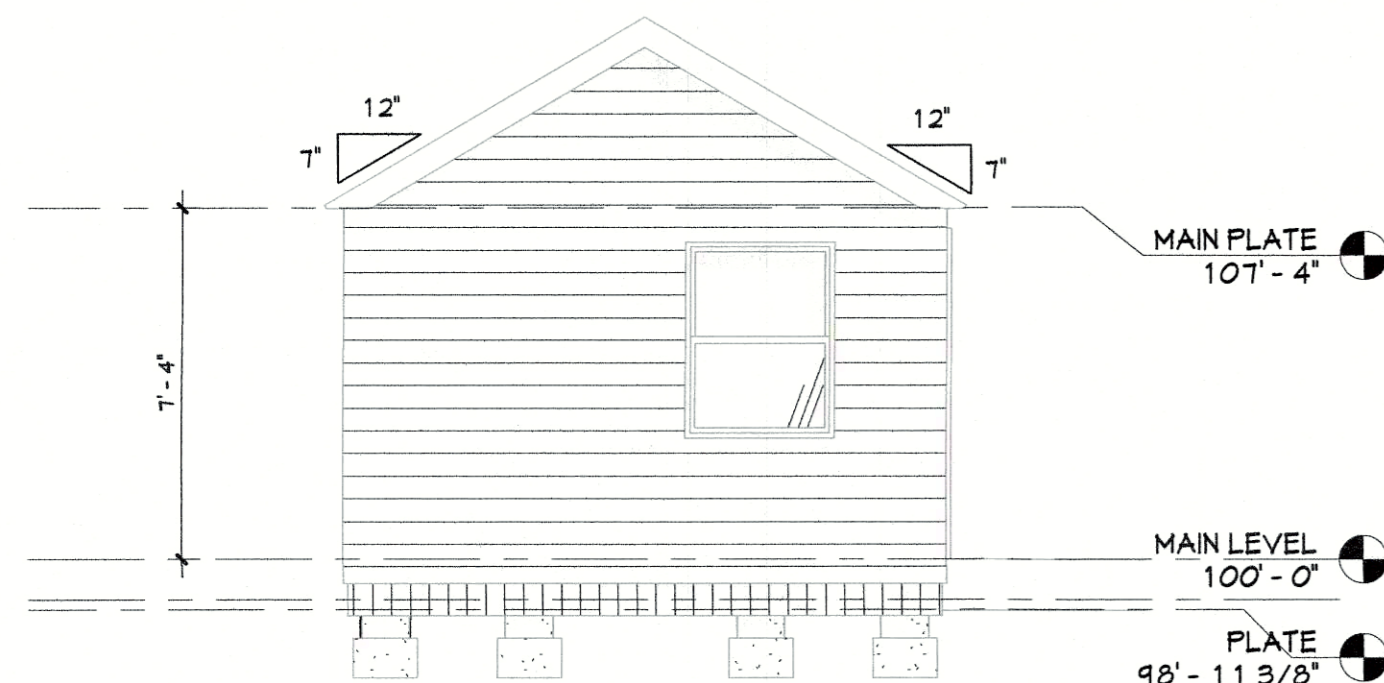


3 East  
1/4" = 1'-0"

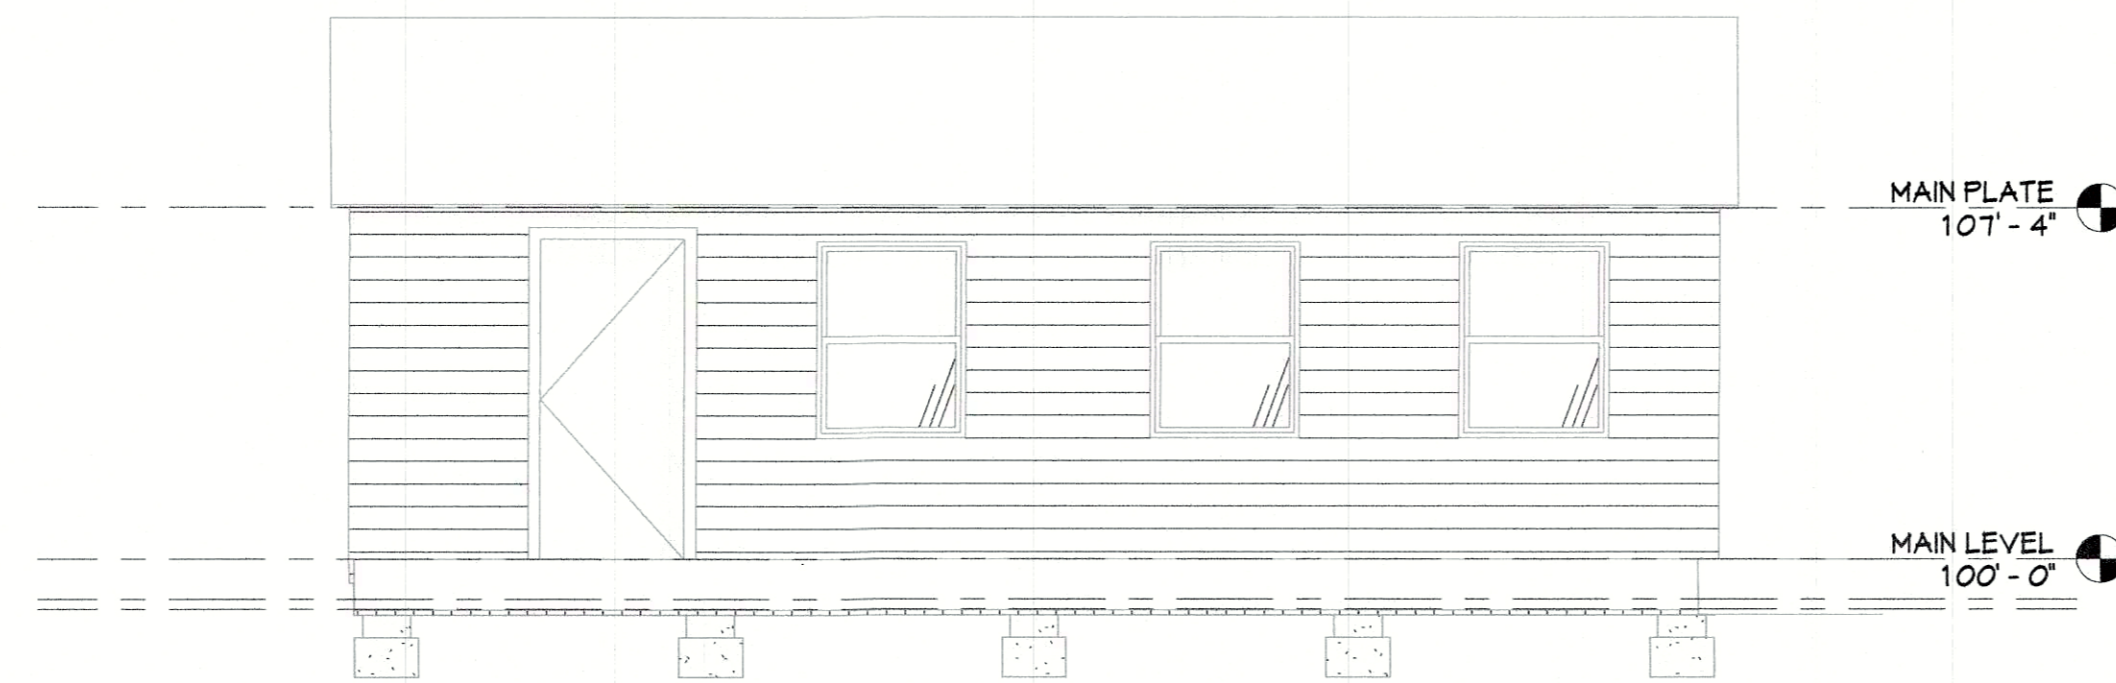


6 South  
1/4" = 1'-0"

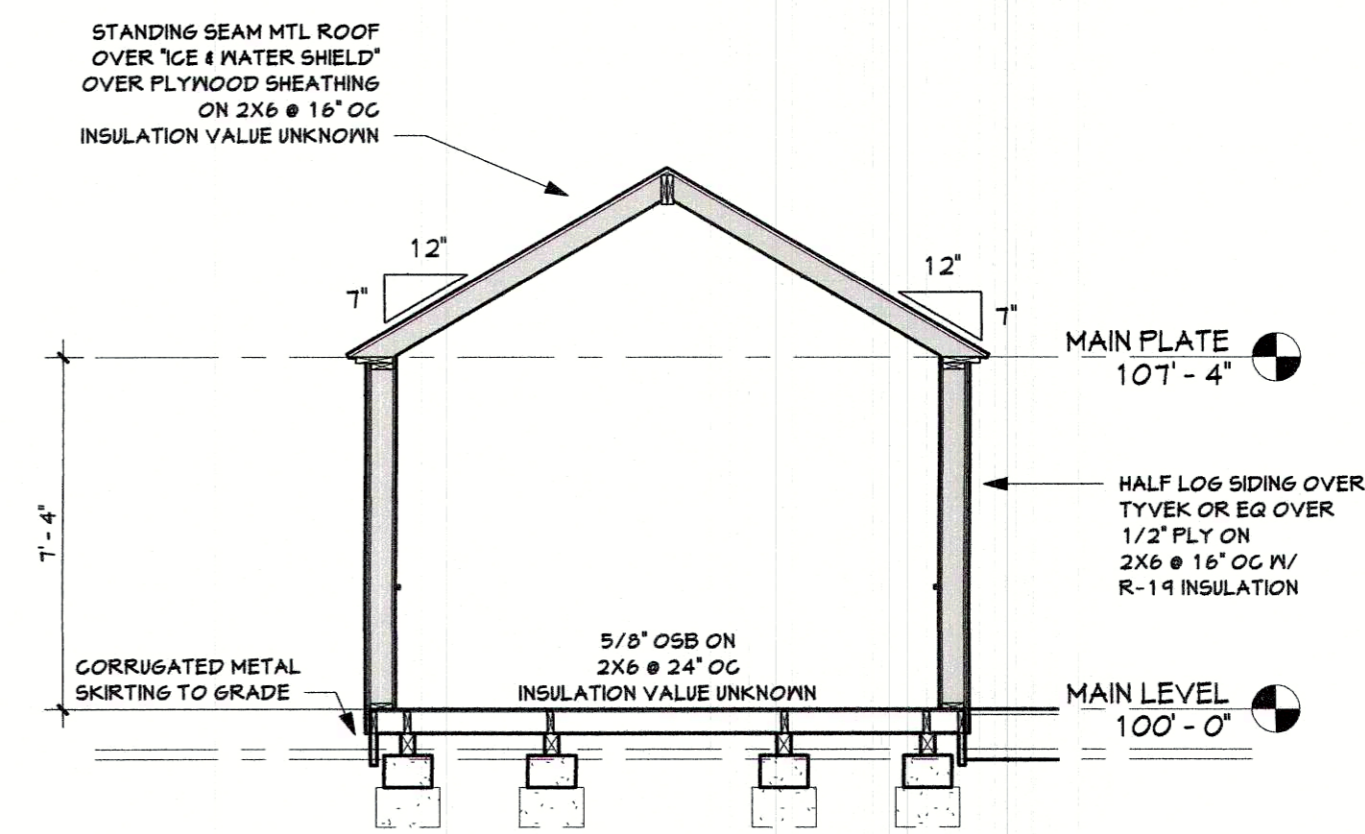


1 EXISTING CONDITIONS SECTION  
1/4" = 1'-0"

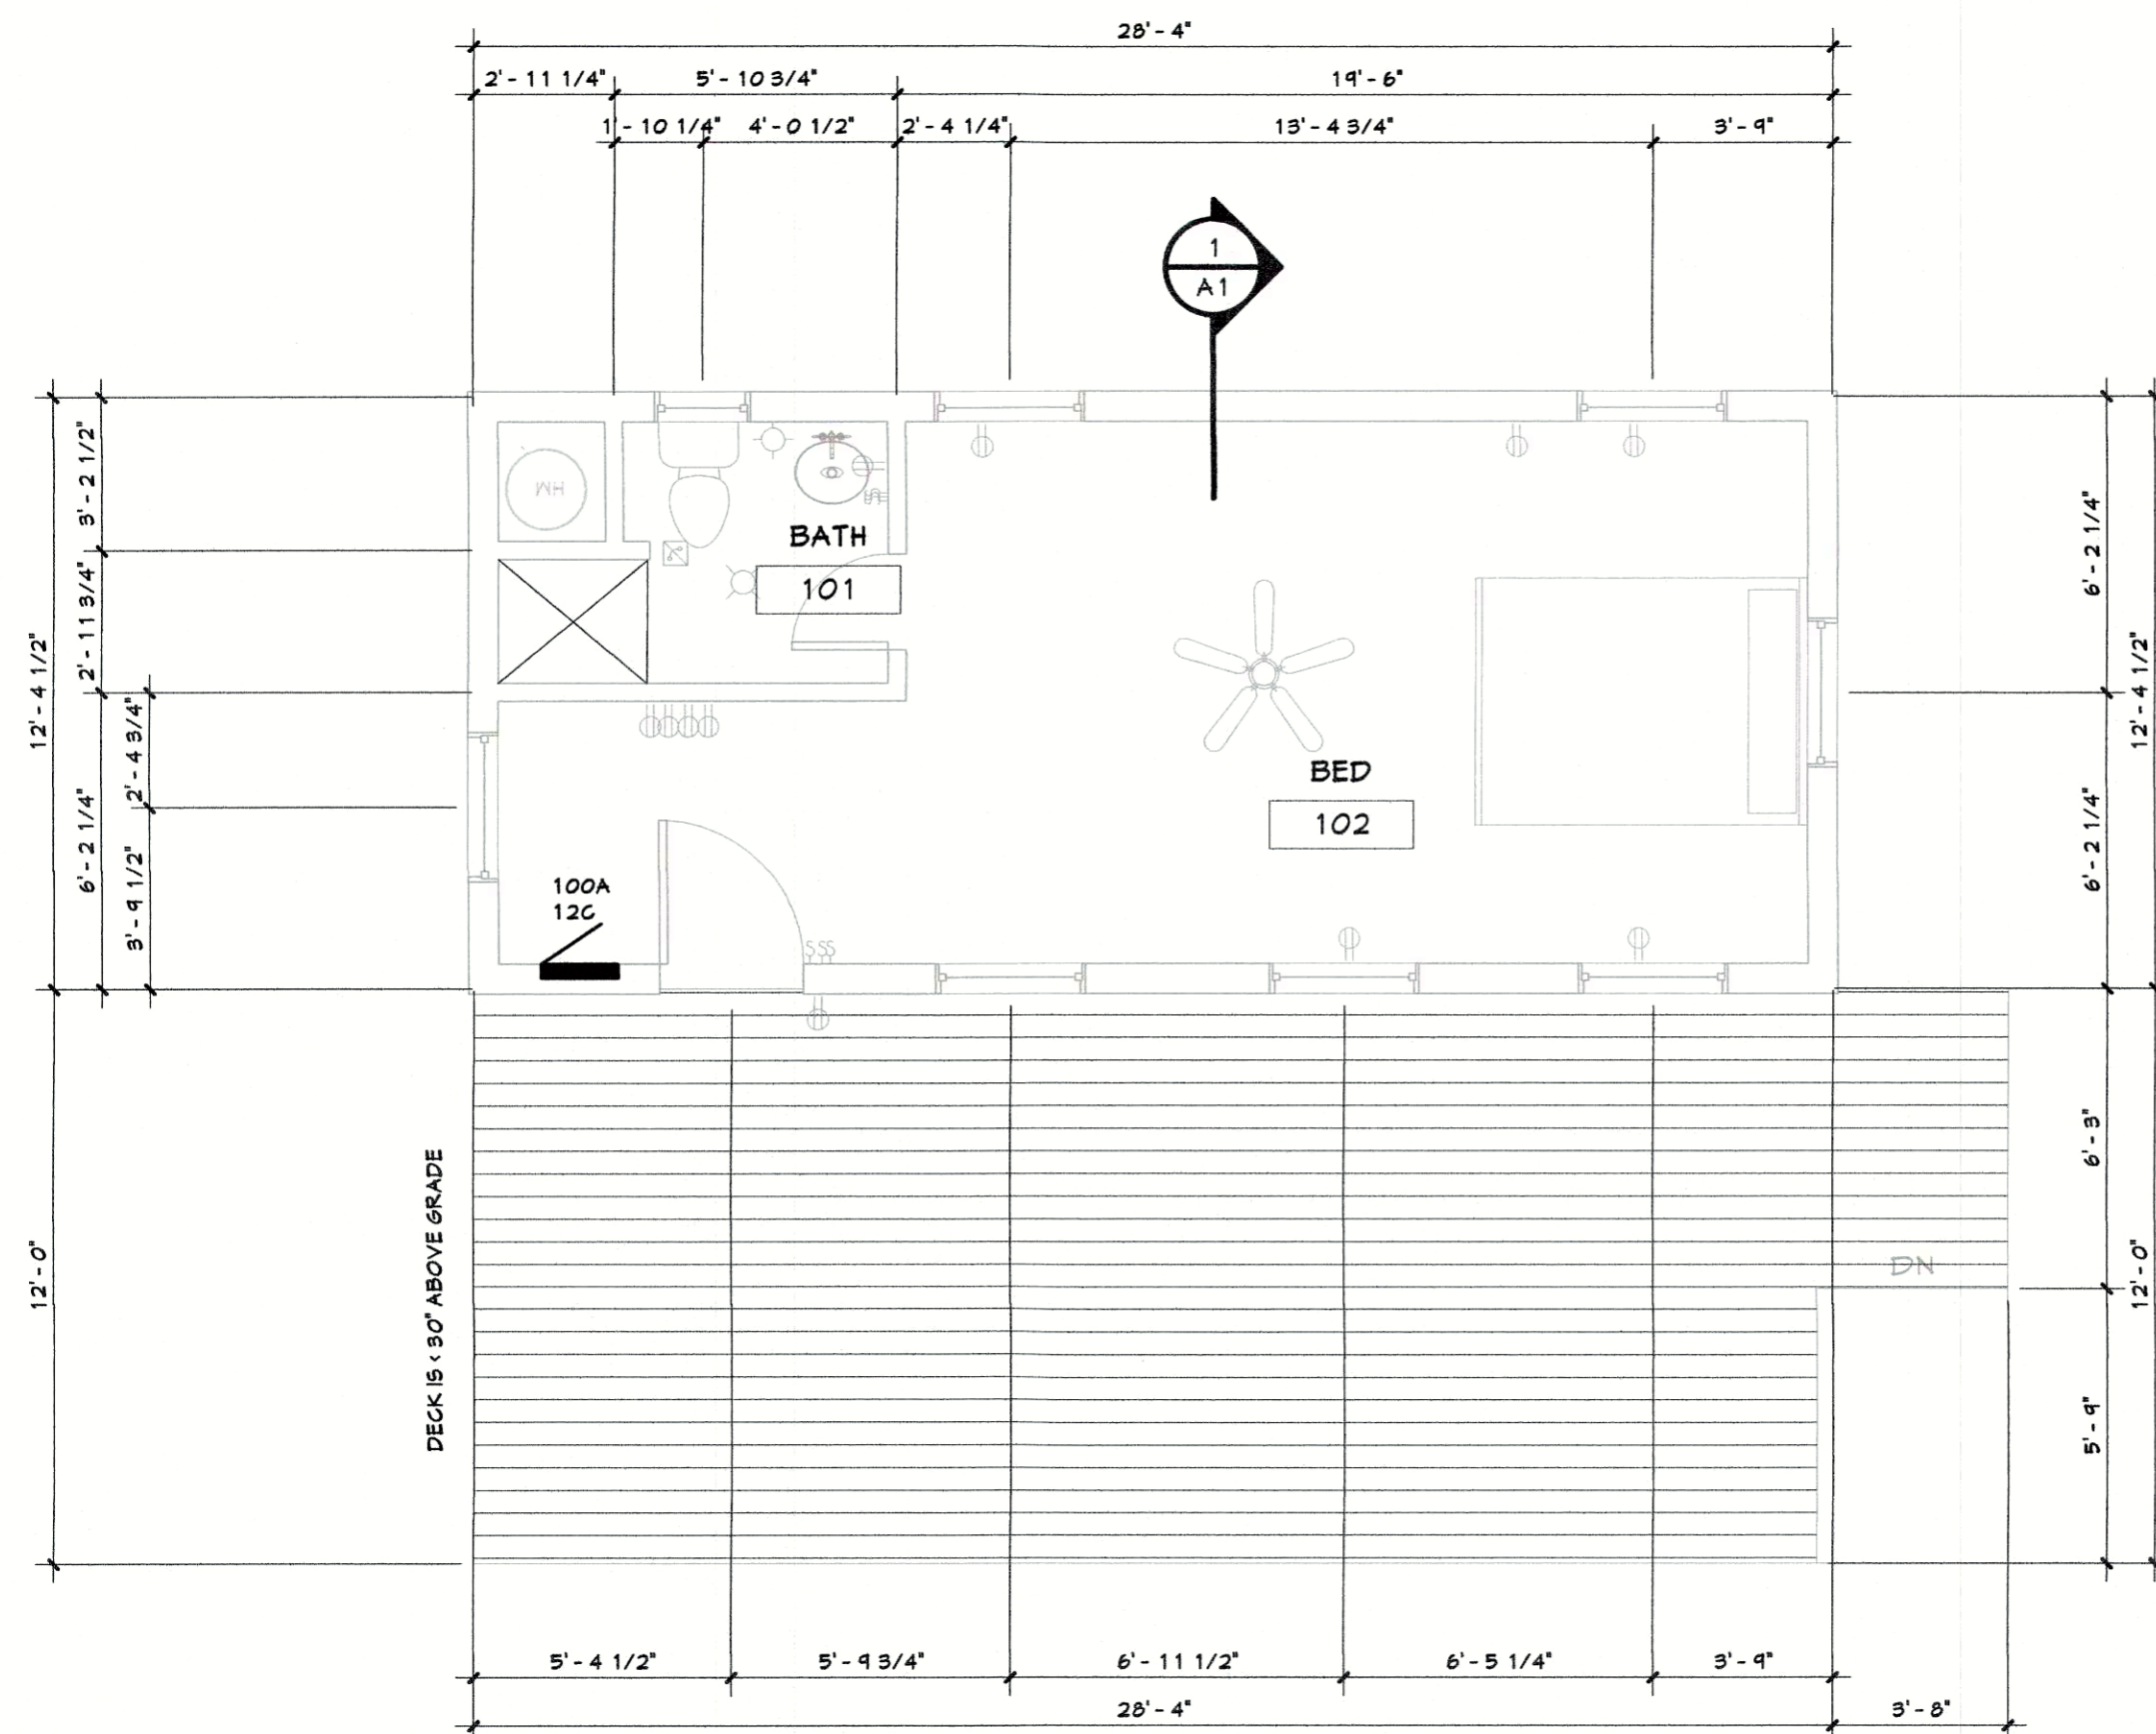


4 MAIN LEVEL FLOOR PLAN  
1/4" = 1'-0"

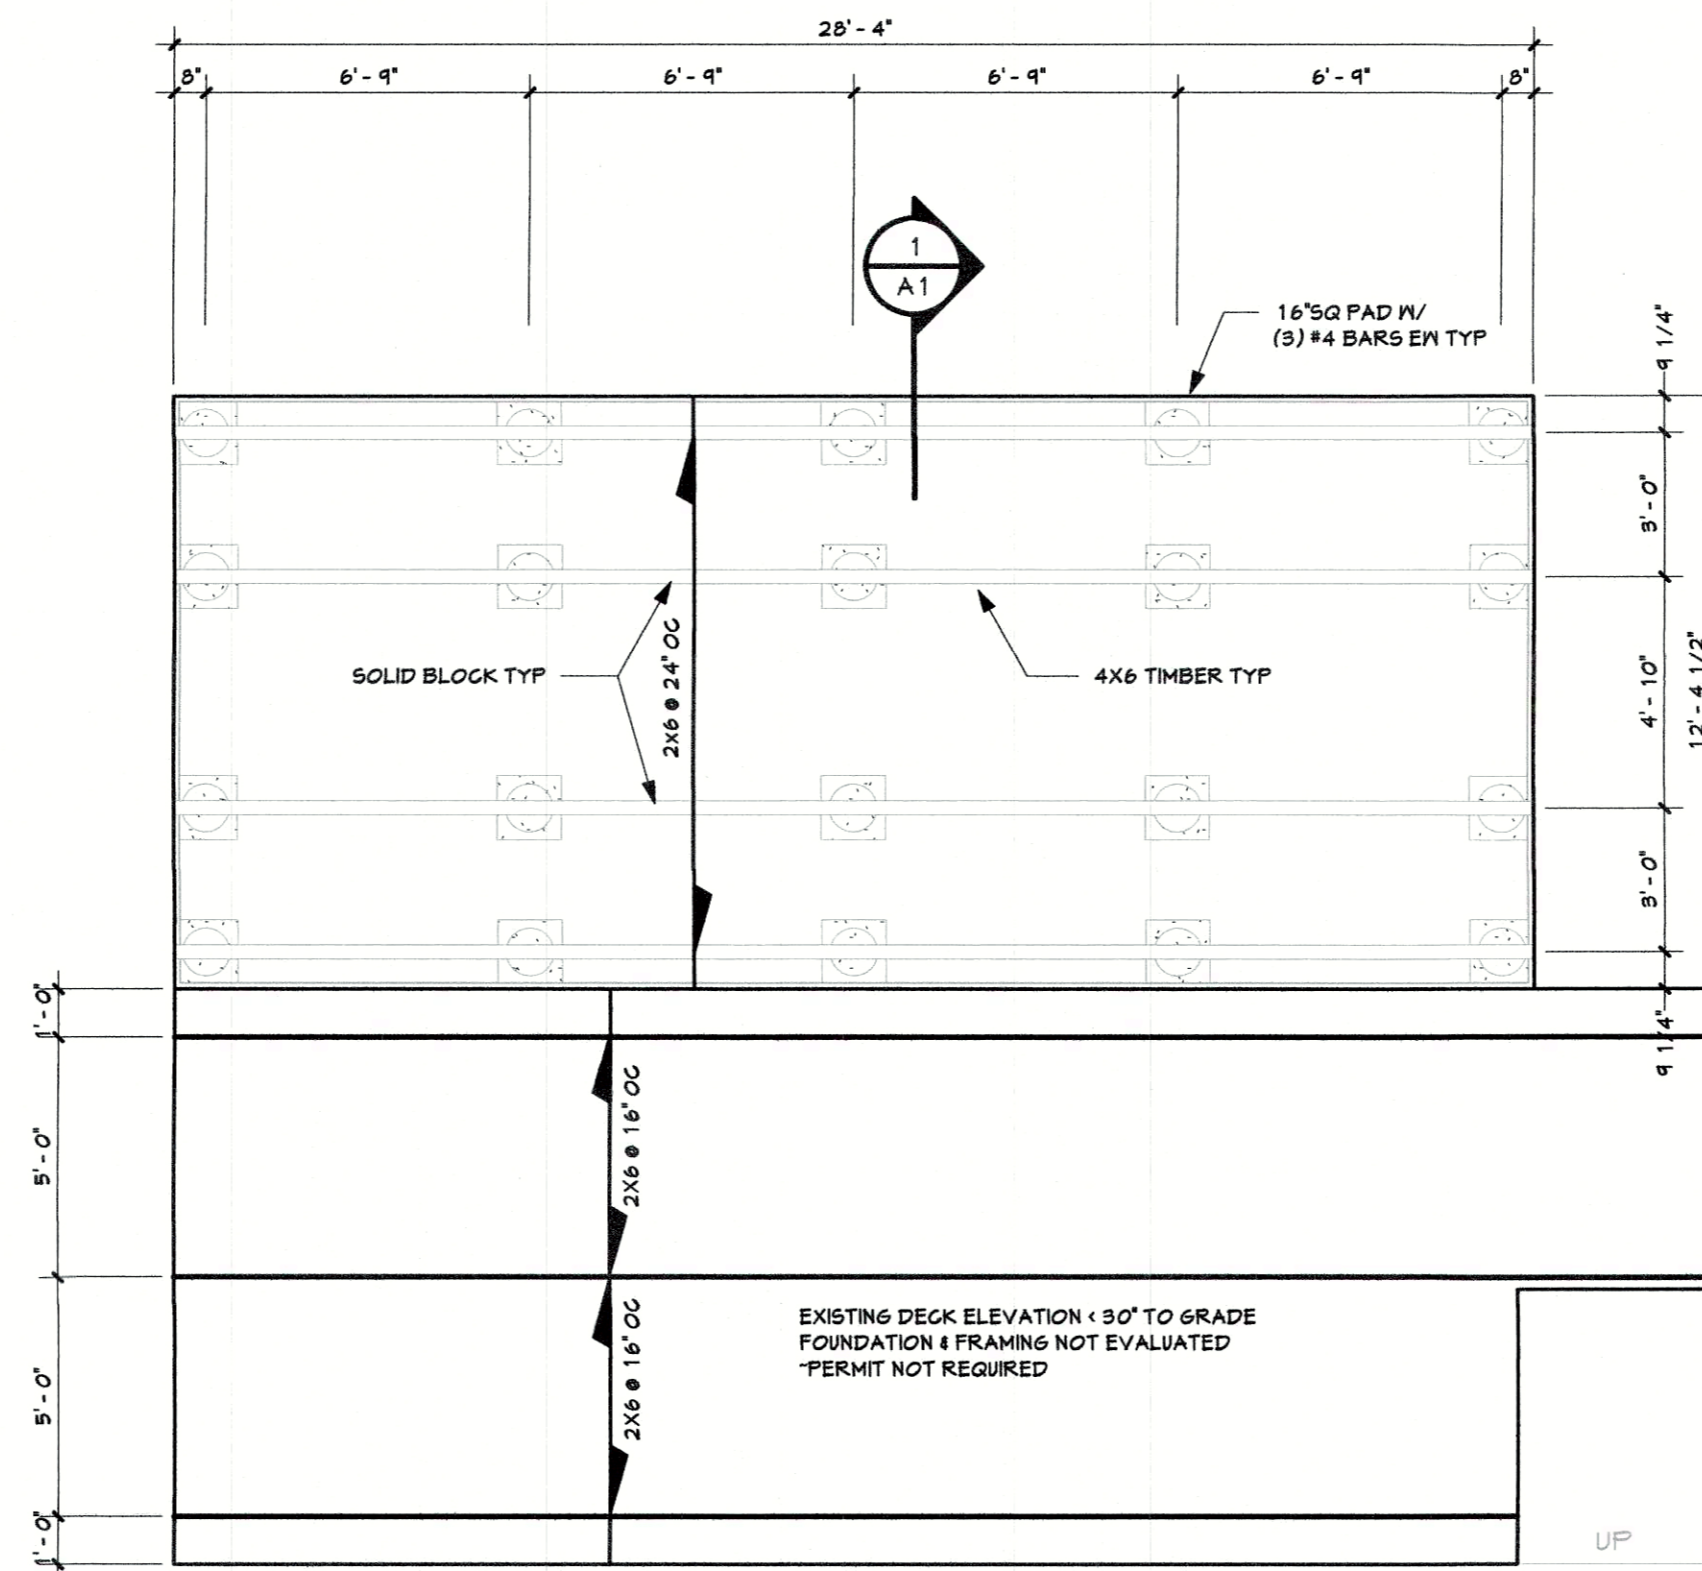

2 FOUNDATION & FRAMING PLAN  
1/4" = 1'-0"

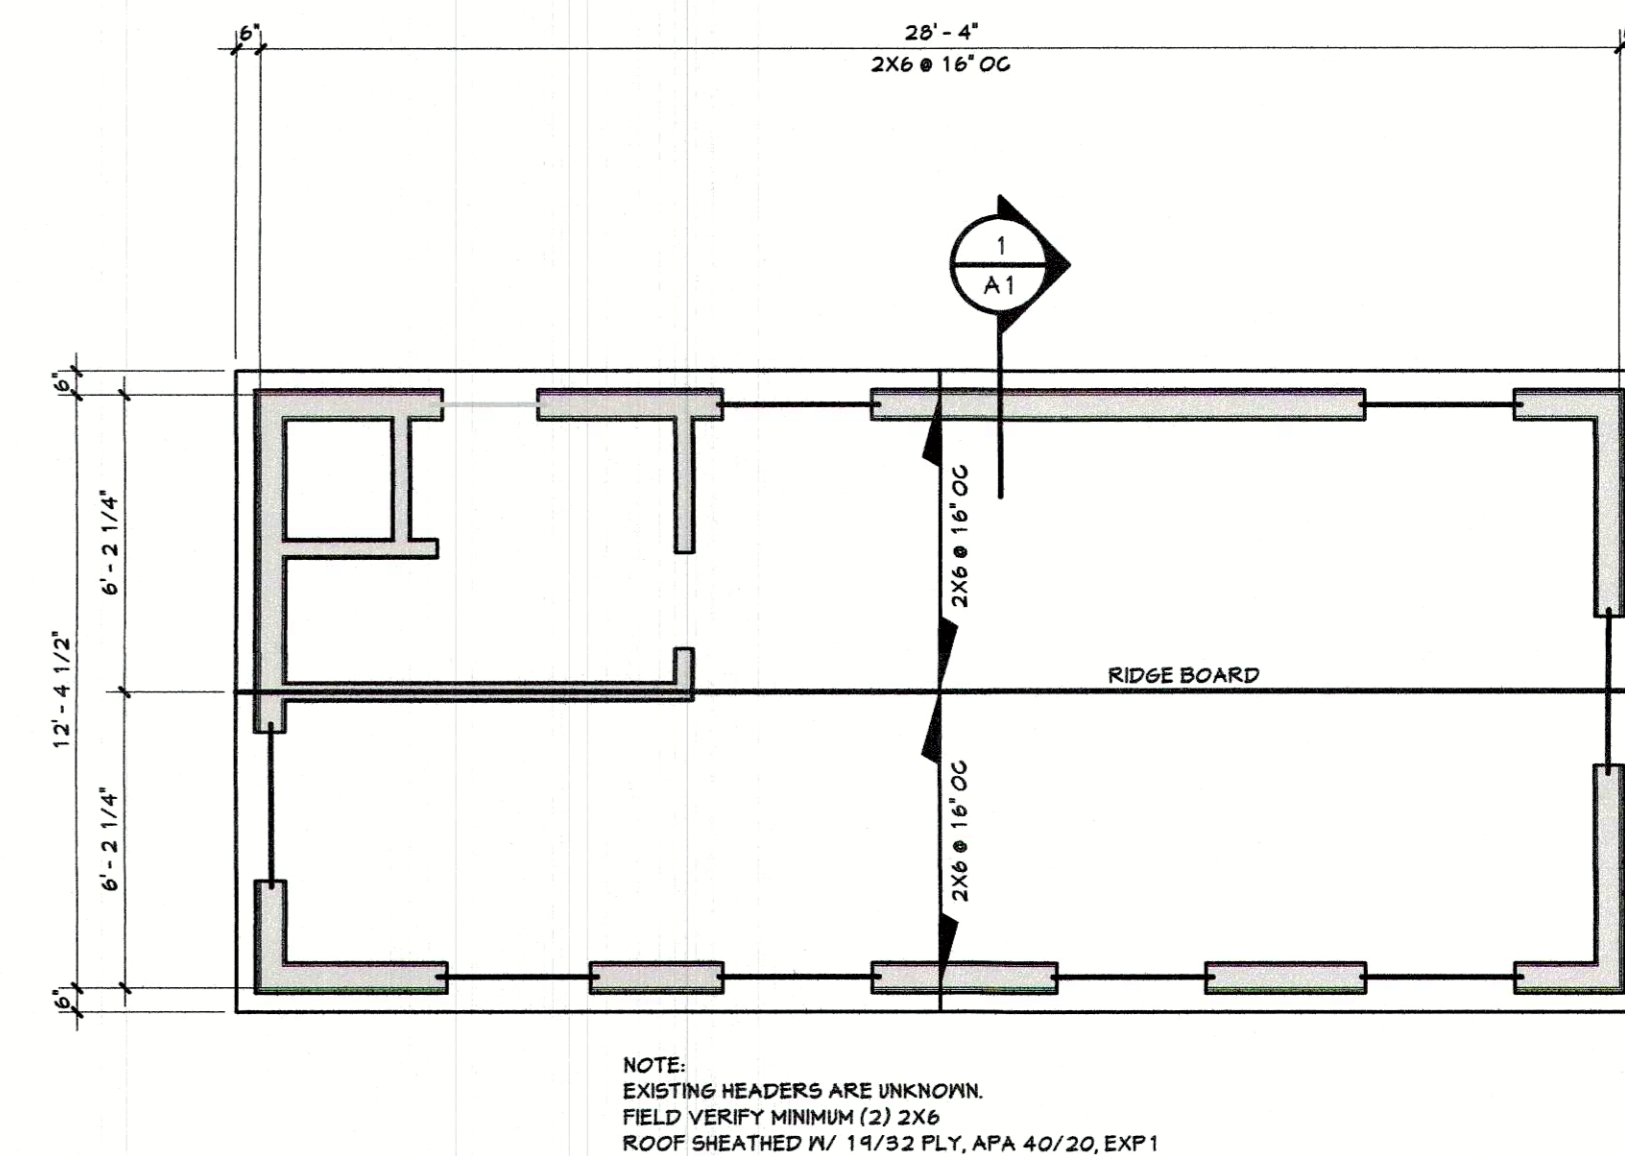

8 ROOF FRAMING PLAN  
1/4" = 1'-0"

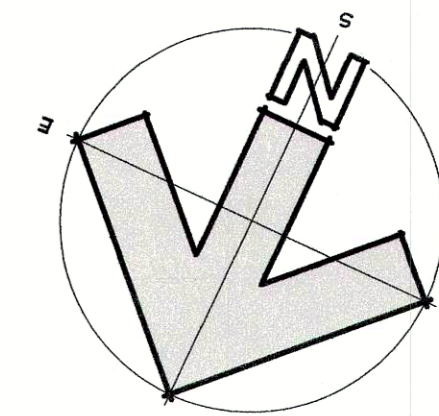

DRAFTING SERVICE INC.  
P.O. BOX 774121  
426 OAK STREET  
STEAMBOAT SPRINGS, COLORADO  
970.879.7929  
FAX 970.879.8709  
JAKES@SPRINGSIPS.COM

**Jake's**  
CELEBRATING 30 YEARS  
IN BUSINESS 1987-2017

COLORADO LICENSED  
PROFESSIONAL ENGINEER  
11-2-17  
"STRUCTURE ONLY"

AS BUILT FLOOR PLANS, ELEVATIONS & SECTION FOR  
**DWAYNE M OSADCHUK TRUST, C1**  
28850 TOBIANO TRL  
ROUTT COUNTY CO  
OWNER/ CONTRACTOR 946-5592


Job # 17.050  
File 17.050A10  
Date 2NOV17  
Drawn KAB  
Checked JMH  
Re'd 2NOV17  
Rev'd

Sheet Number

A 1

SHEET 2 OF 3


11/2/2017 2:50:23 PM H:\proj\osadchuk\TRAILERS\Trailer 1.rvt

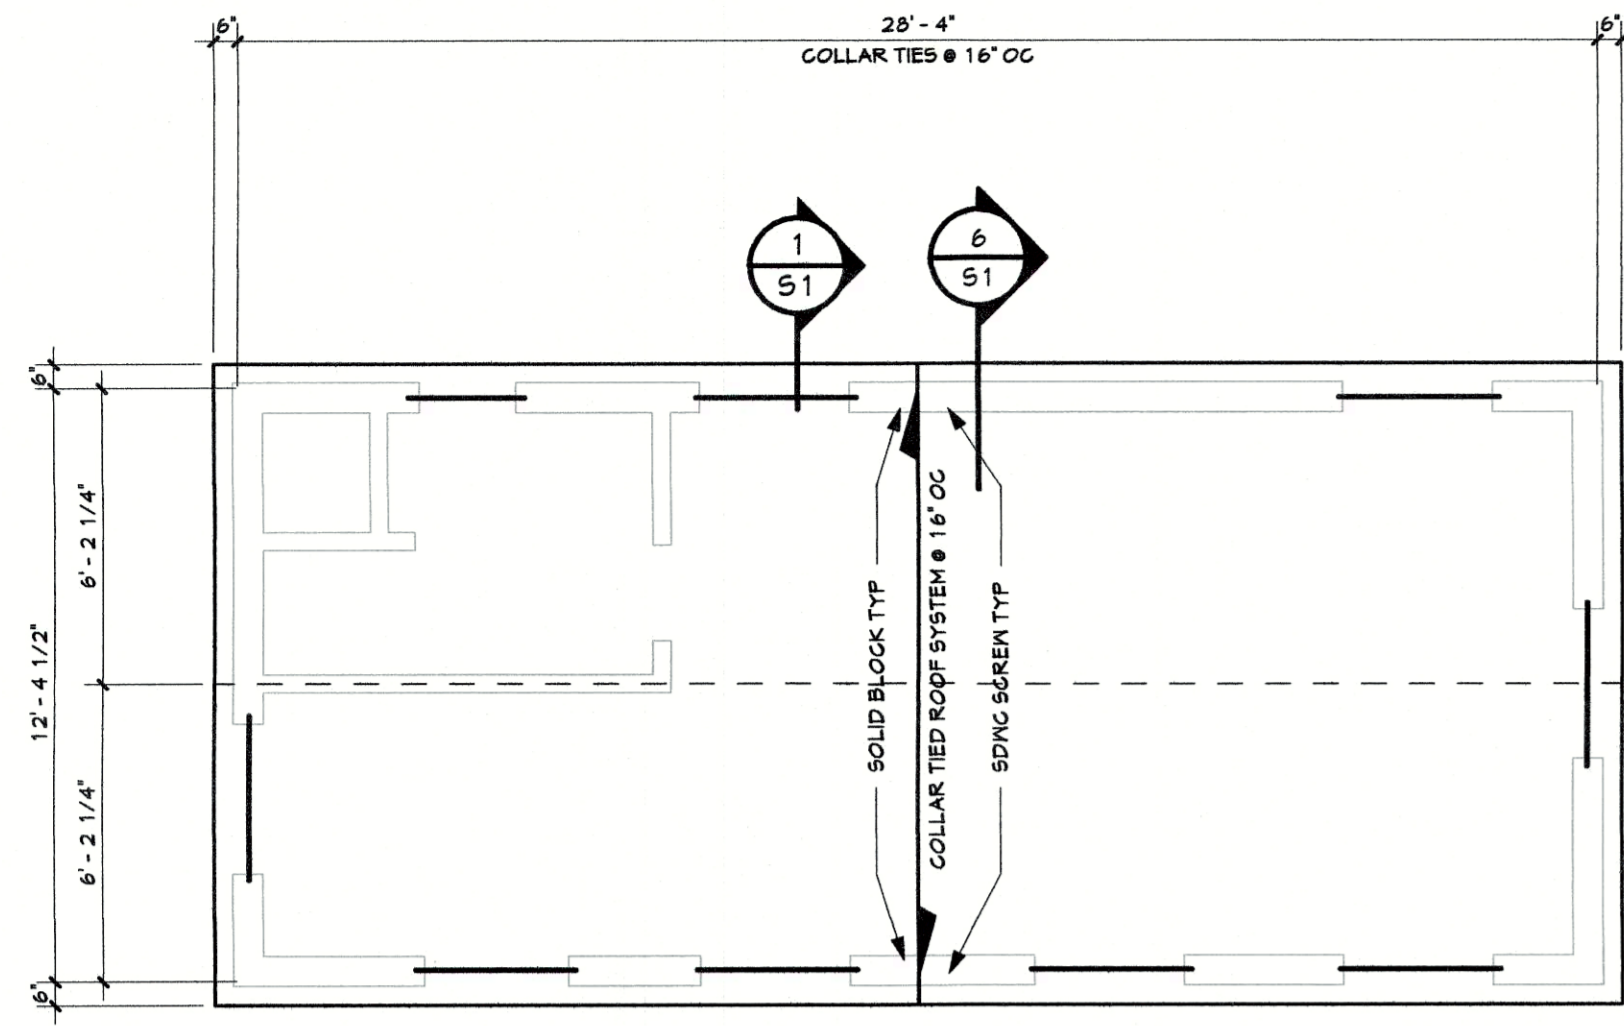

5 ROOF FRAMING PLAN REPAIR

1/4" = 1'-0"


NOTE: EXISTING HEADERS ARE UNKNOWN. FIELD VERIFY MINIMUM (2) 2X6

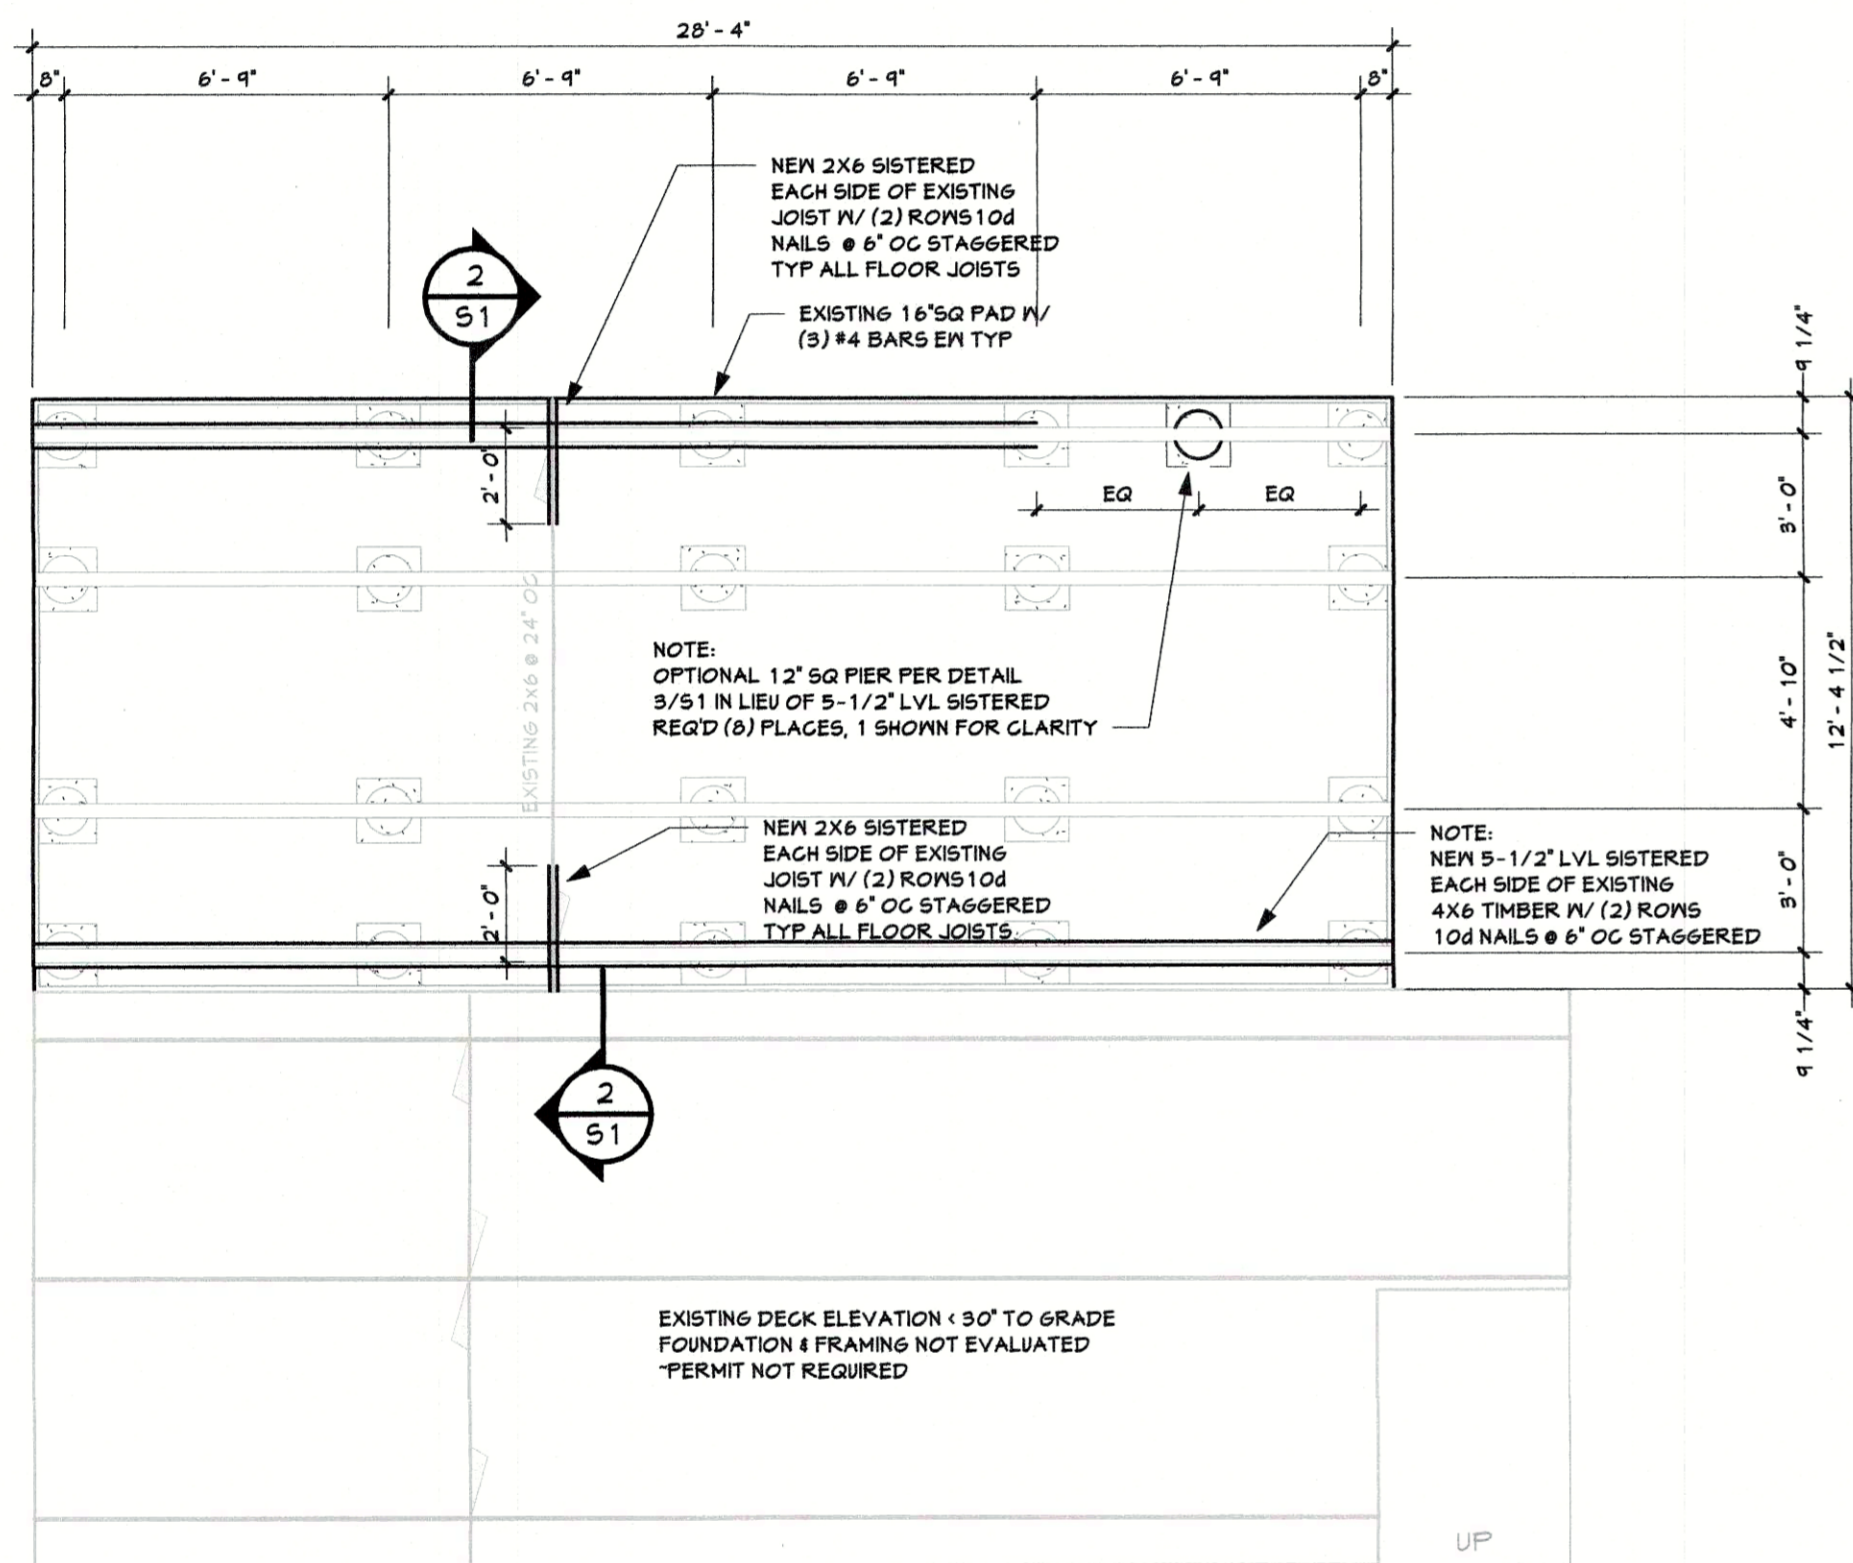

4 FOUNDATION & FRAMING REPAIR PLAN


1/4" = 1'-0"

NOTE: EXISTING FOUNDATION WILL COMPLY WITH BUILDING CODES BY EITHER ADDING (2) 5-1/2" LVL'S TO EXISTING FLOOR BEAMS OR BY ADDING NEW 12" SQ PADS @ MIDSPAN

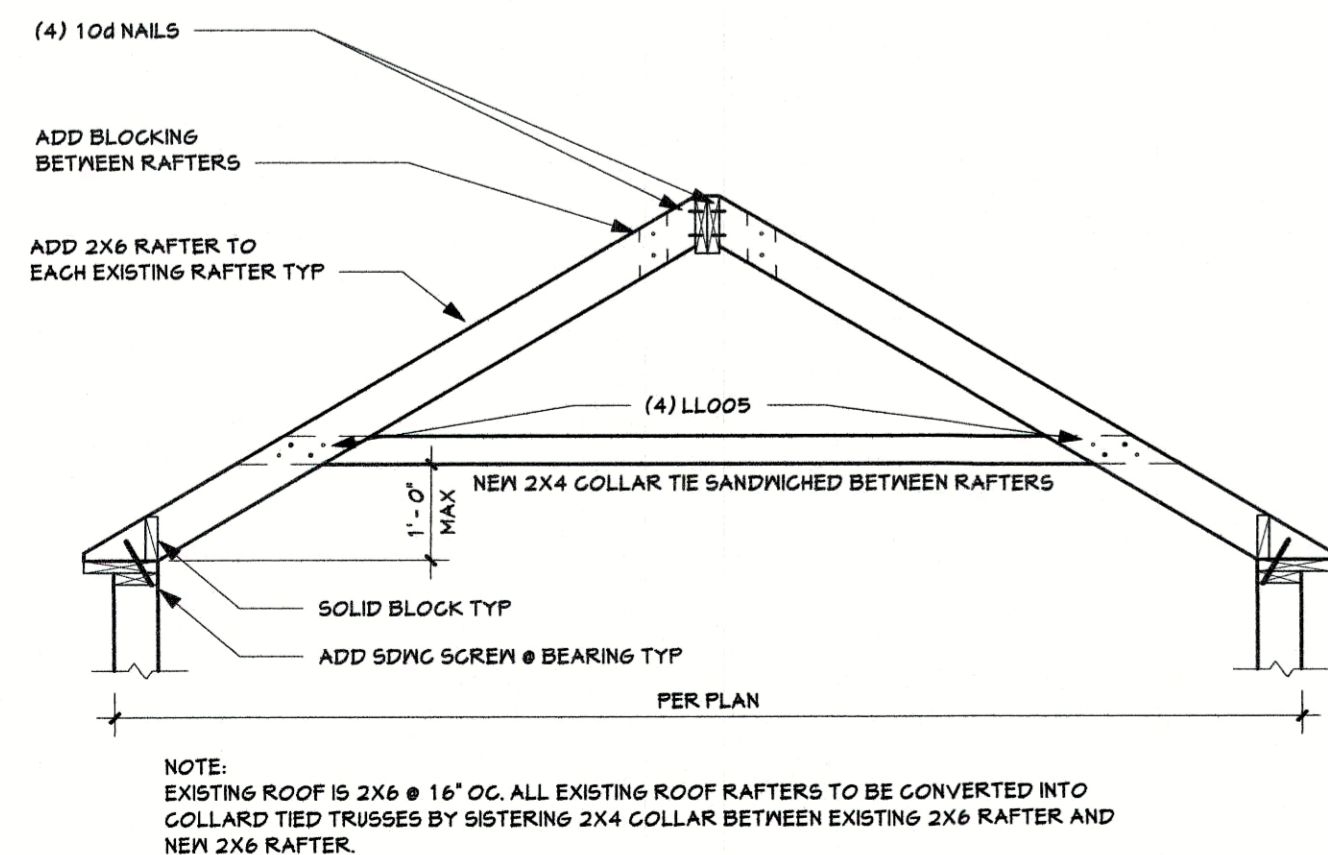


1 COLLAR TIE DETAIL

1/2" = 1'-0"

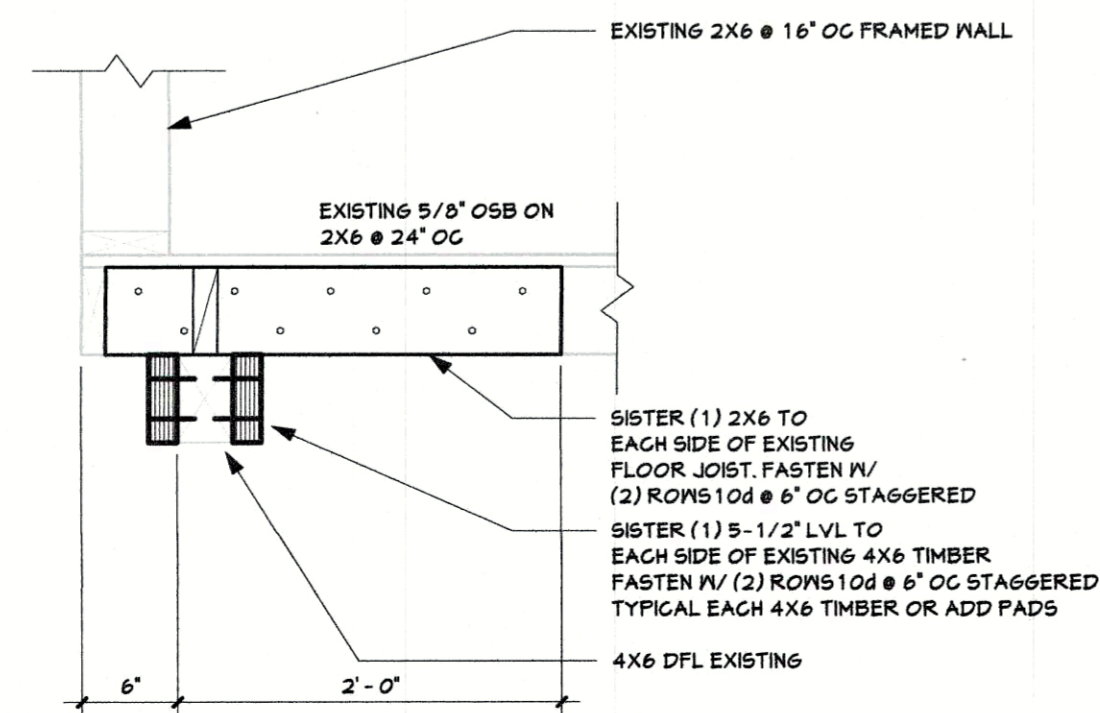


2 RIM DETAIL

1" = 1'-0"

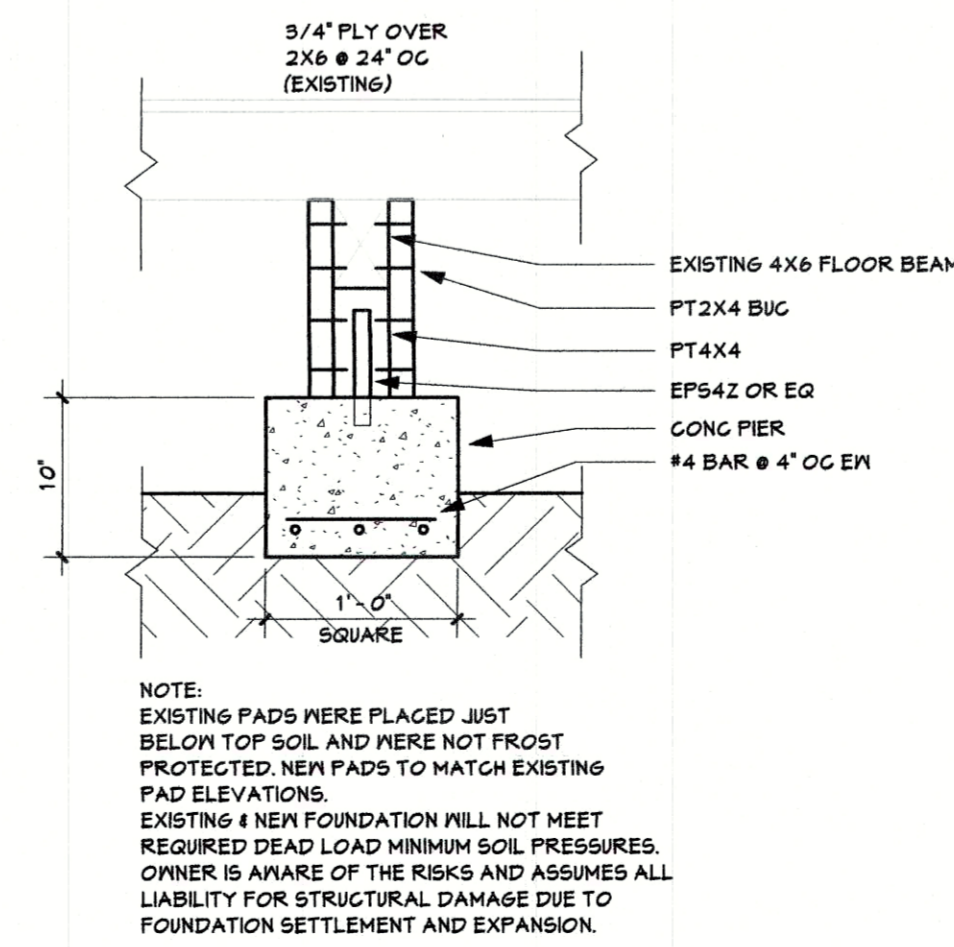

3 OPTIONAL PAD DESIGN

1" = 1'-0"

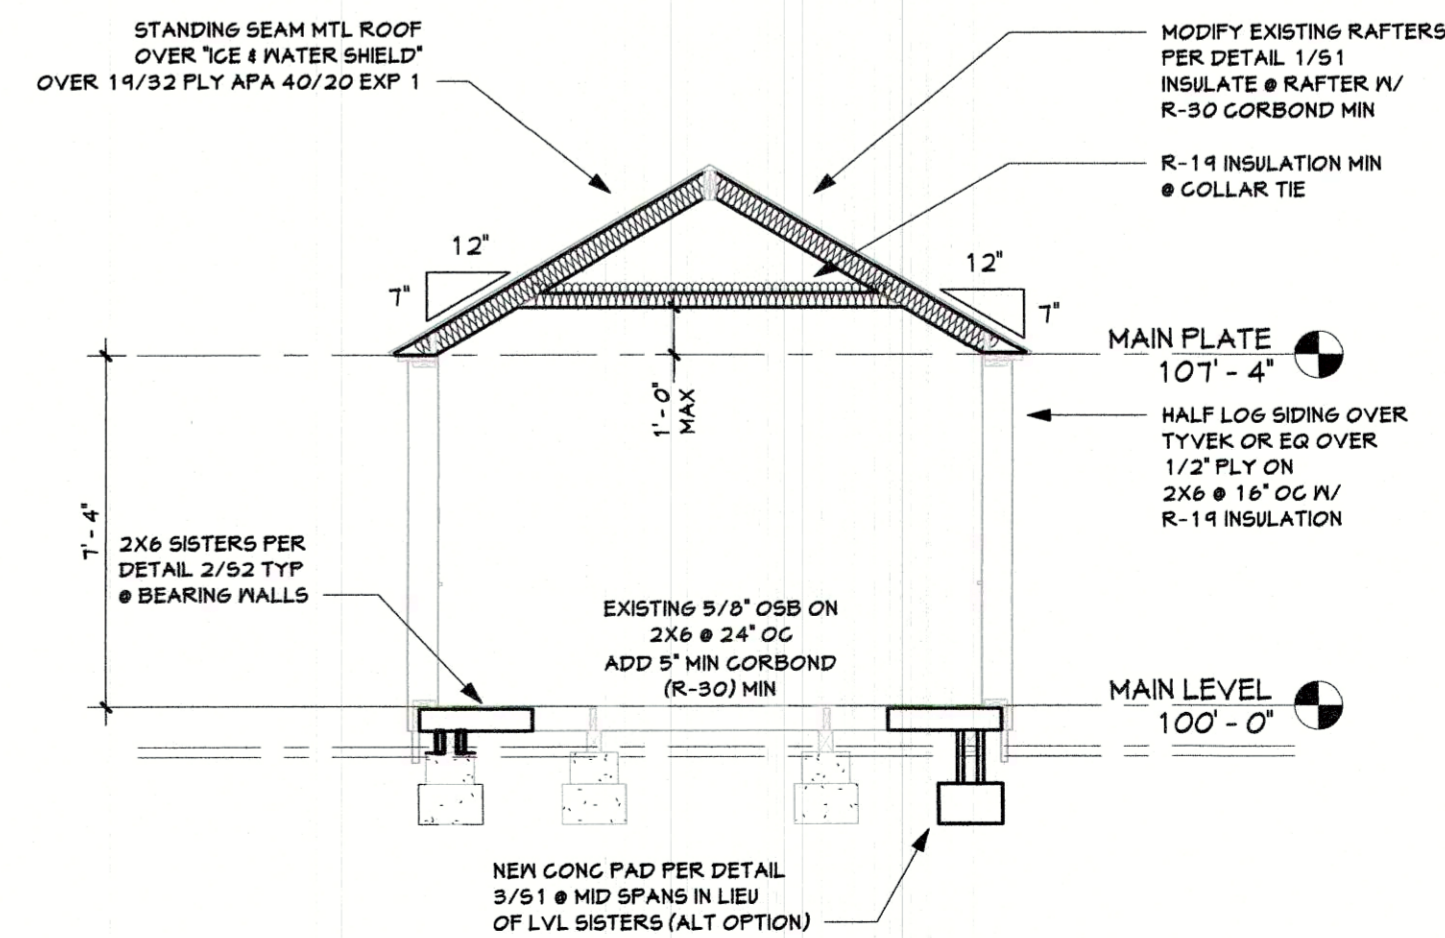

6 NEW TYP SECTION

1/4" = 1'-0"

REPAIR DETAILS & SPECIFICATIONS

DWAYNE MOSADCHUK TRUST, C1  
28850 TOBIANO TRL  
ROUTT COUNTY CO  
OWNER/ CONTRACTOR 946-5592

Job # 17.050  
File 17.050510  
Date 2NOV17  
Drawn KAB  
Checked JMH  
Rev'd 2NOV17

Sheet Number

S1

SHEET 3 OF 3



DRAFTING SERVICE, INC.  
P.O. BOX 174121  
426 OAK STREET  
STEAMBOAT SPRINGS, COLORADO  
970.879.1989  
FAX 970.879.8709  
JAKES@SPRINGSIFS.COM