




11/2/2017 2:59:43 PM H:\proj\osadchuk\TRAILERS\Trailer S.rvt

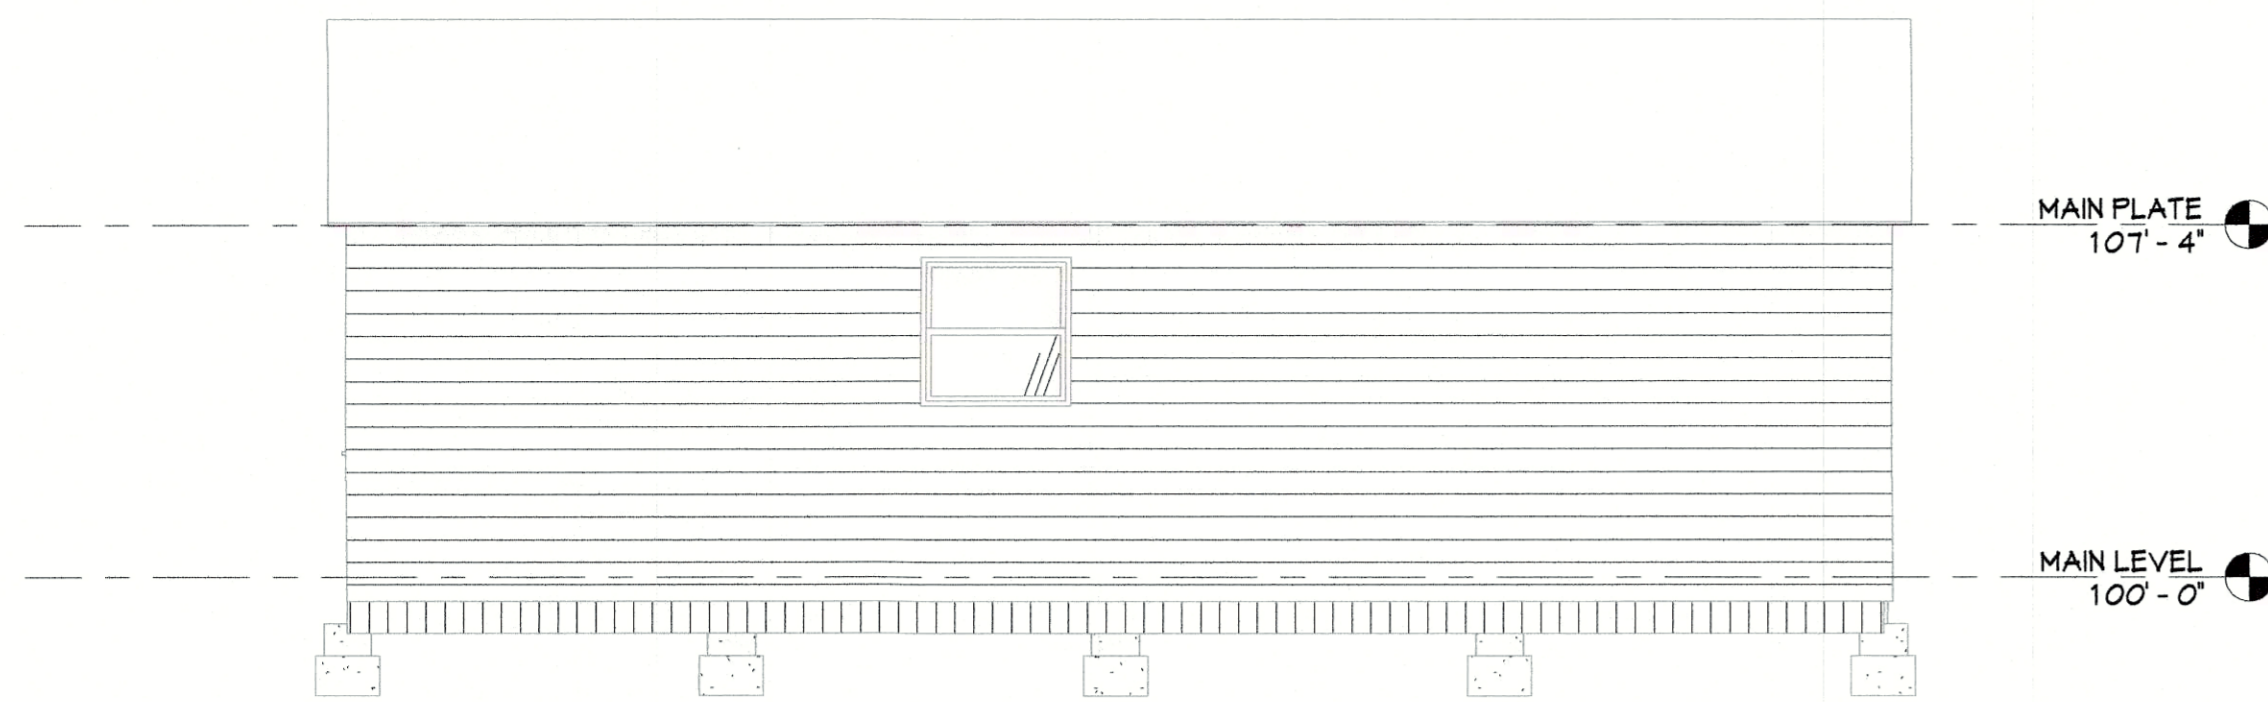


5 North
1/4" = 1'-0"

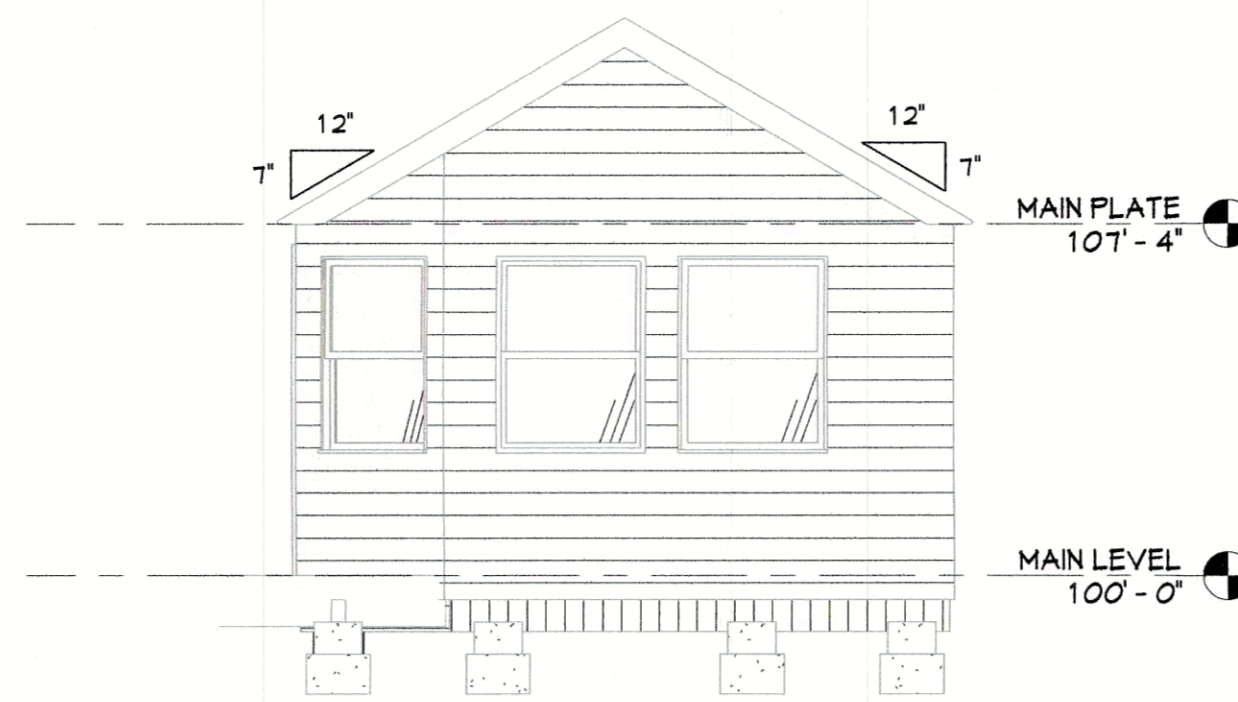


7 West
1/4" = 1'-0"

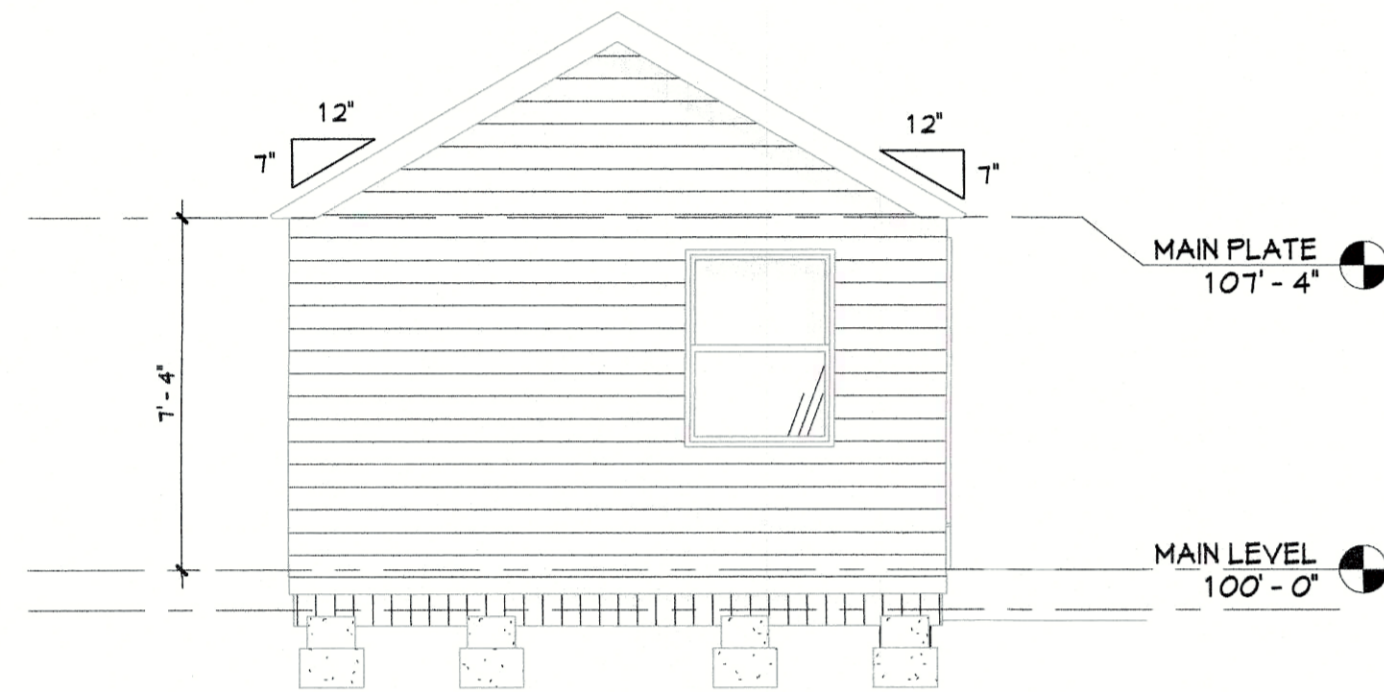


3 East
1/4" = 1'-0"

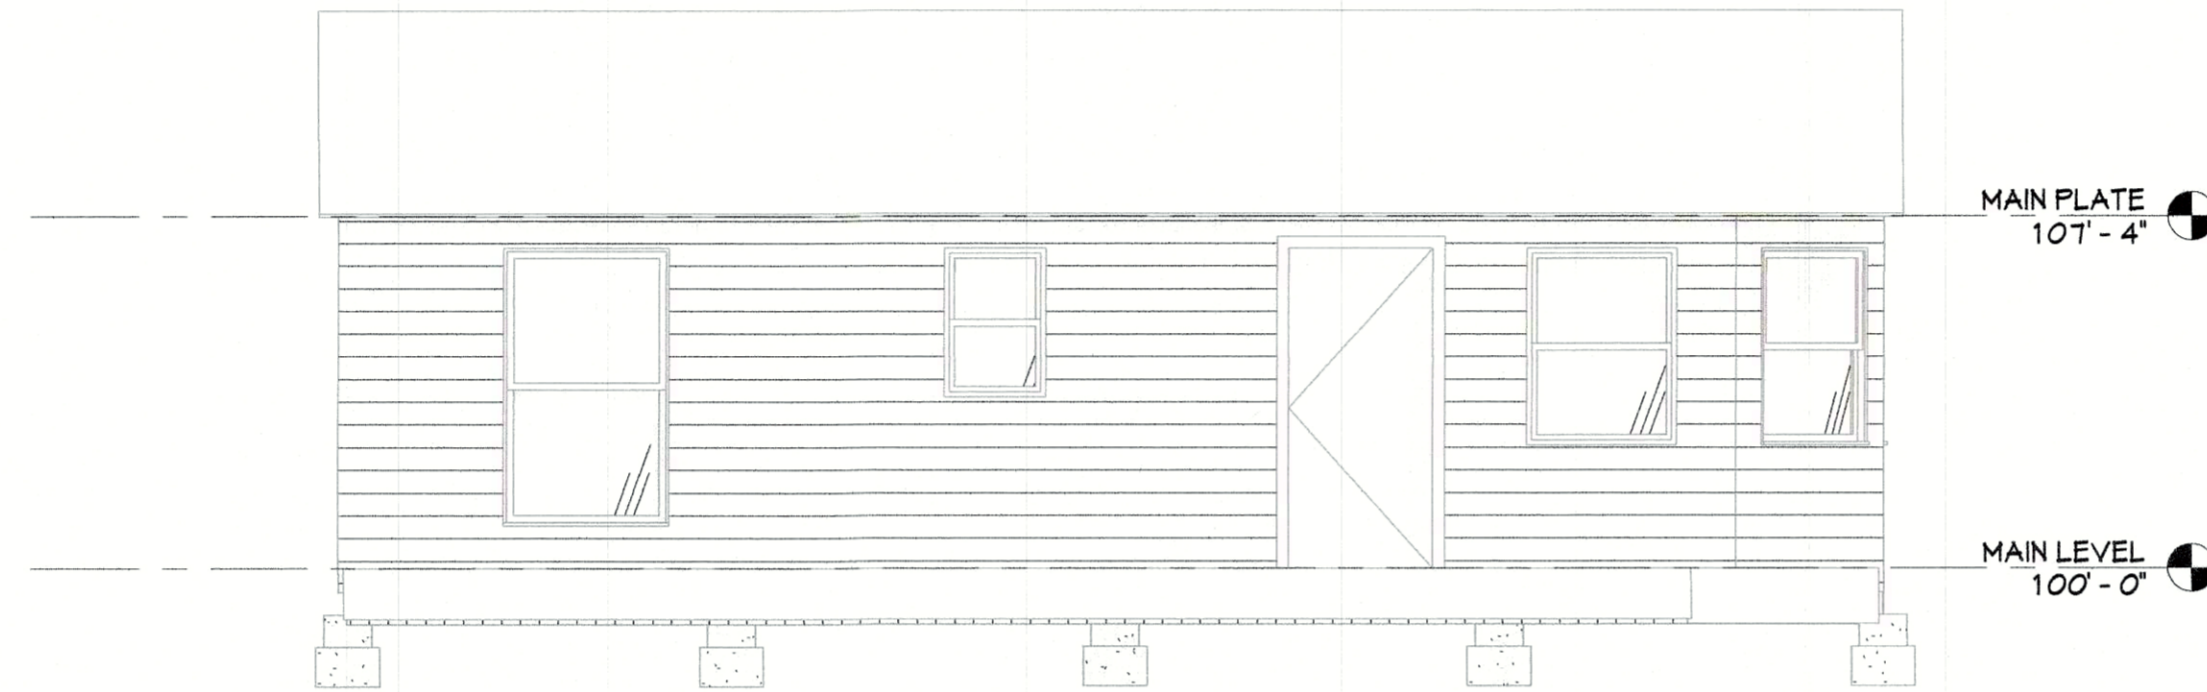


6 South
1/4" = 1'-0"

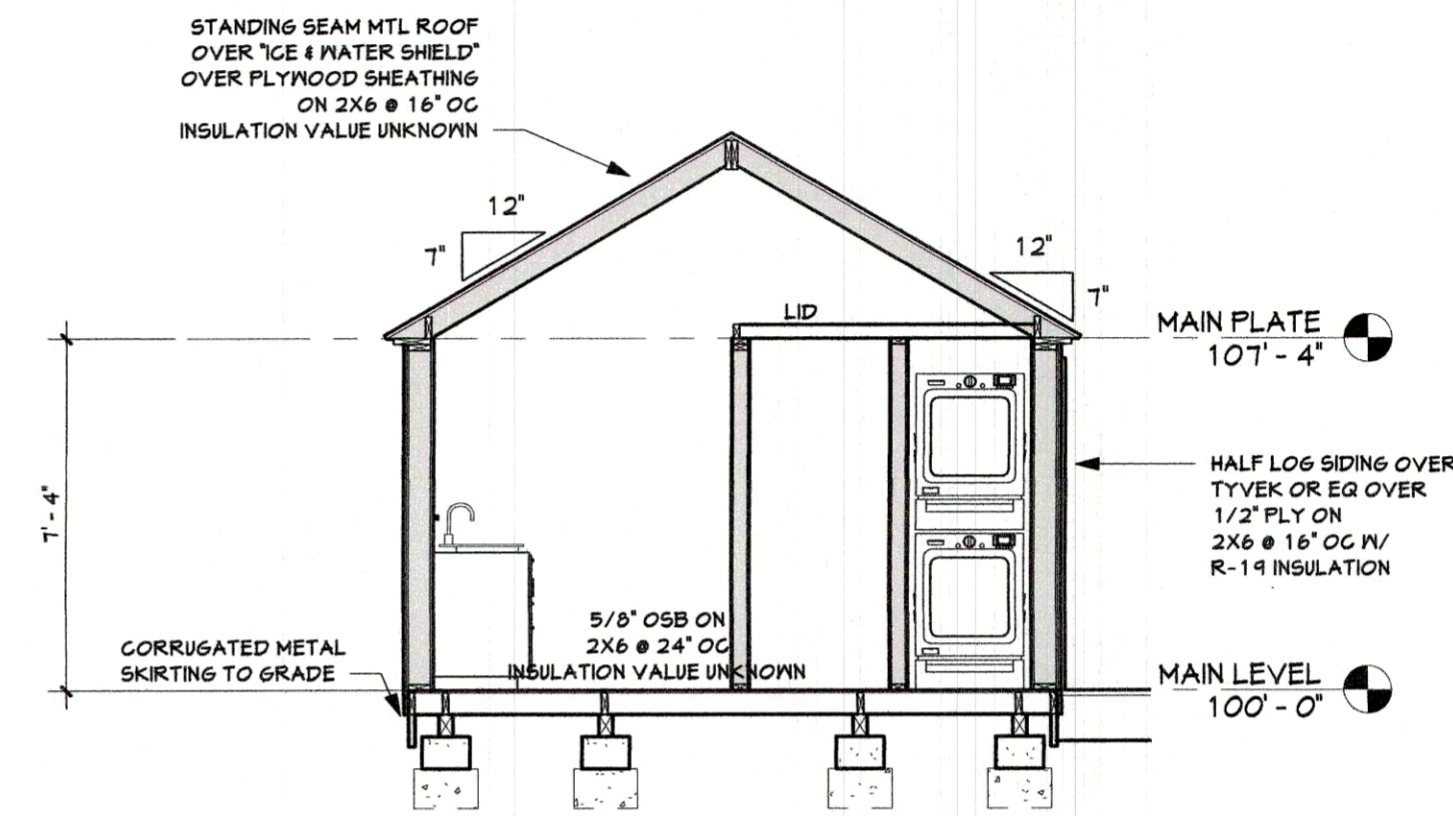


1 EXISTING CONDITIONS SECTION
1/4" = 1'-0"

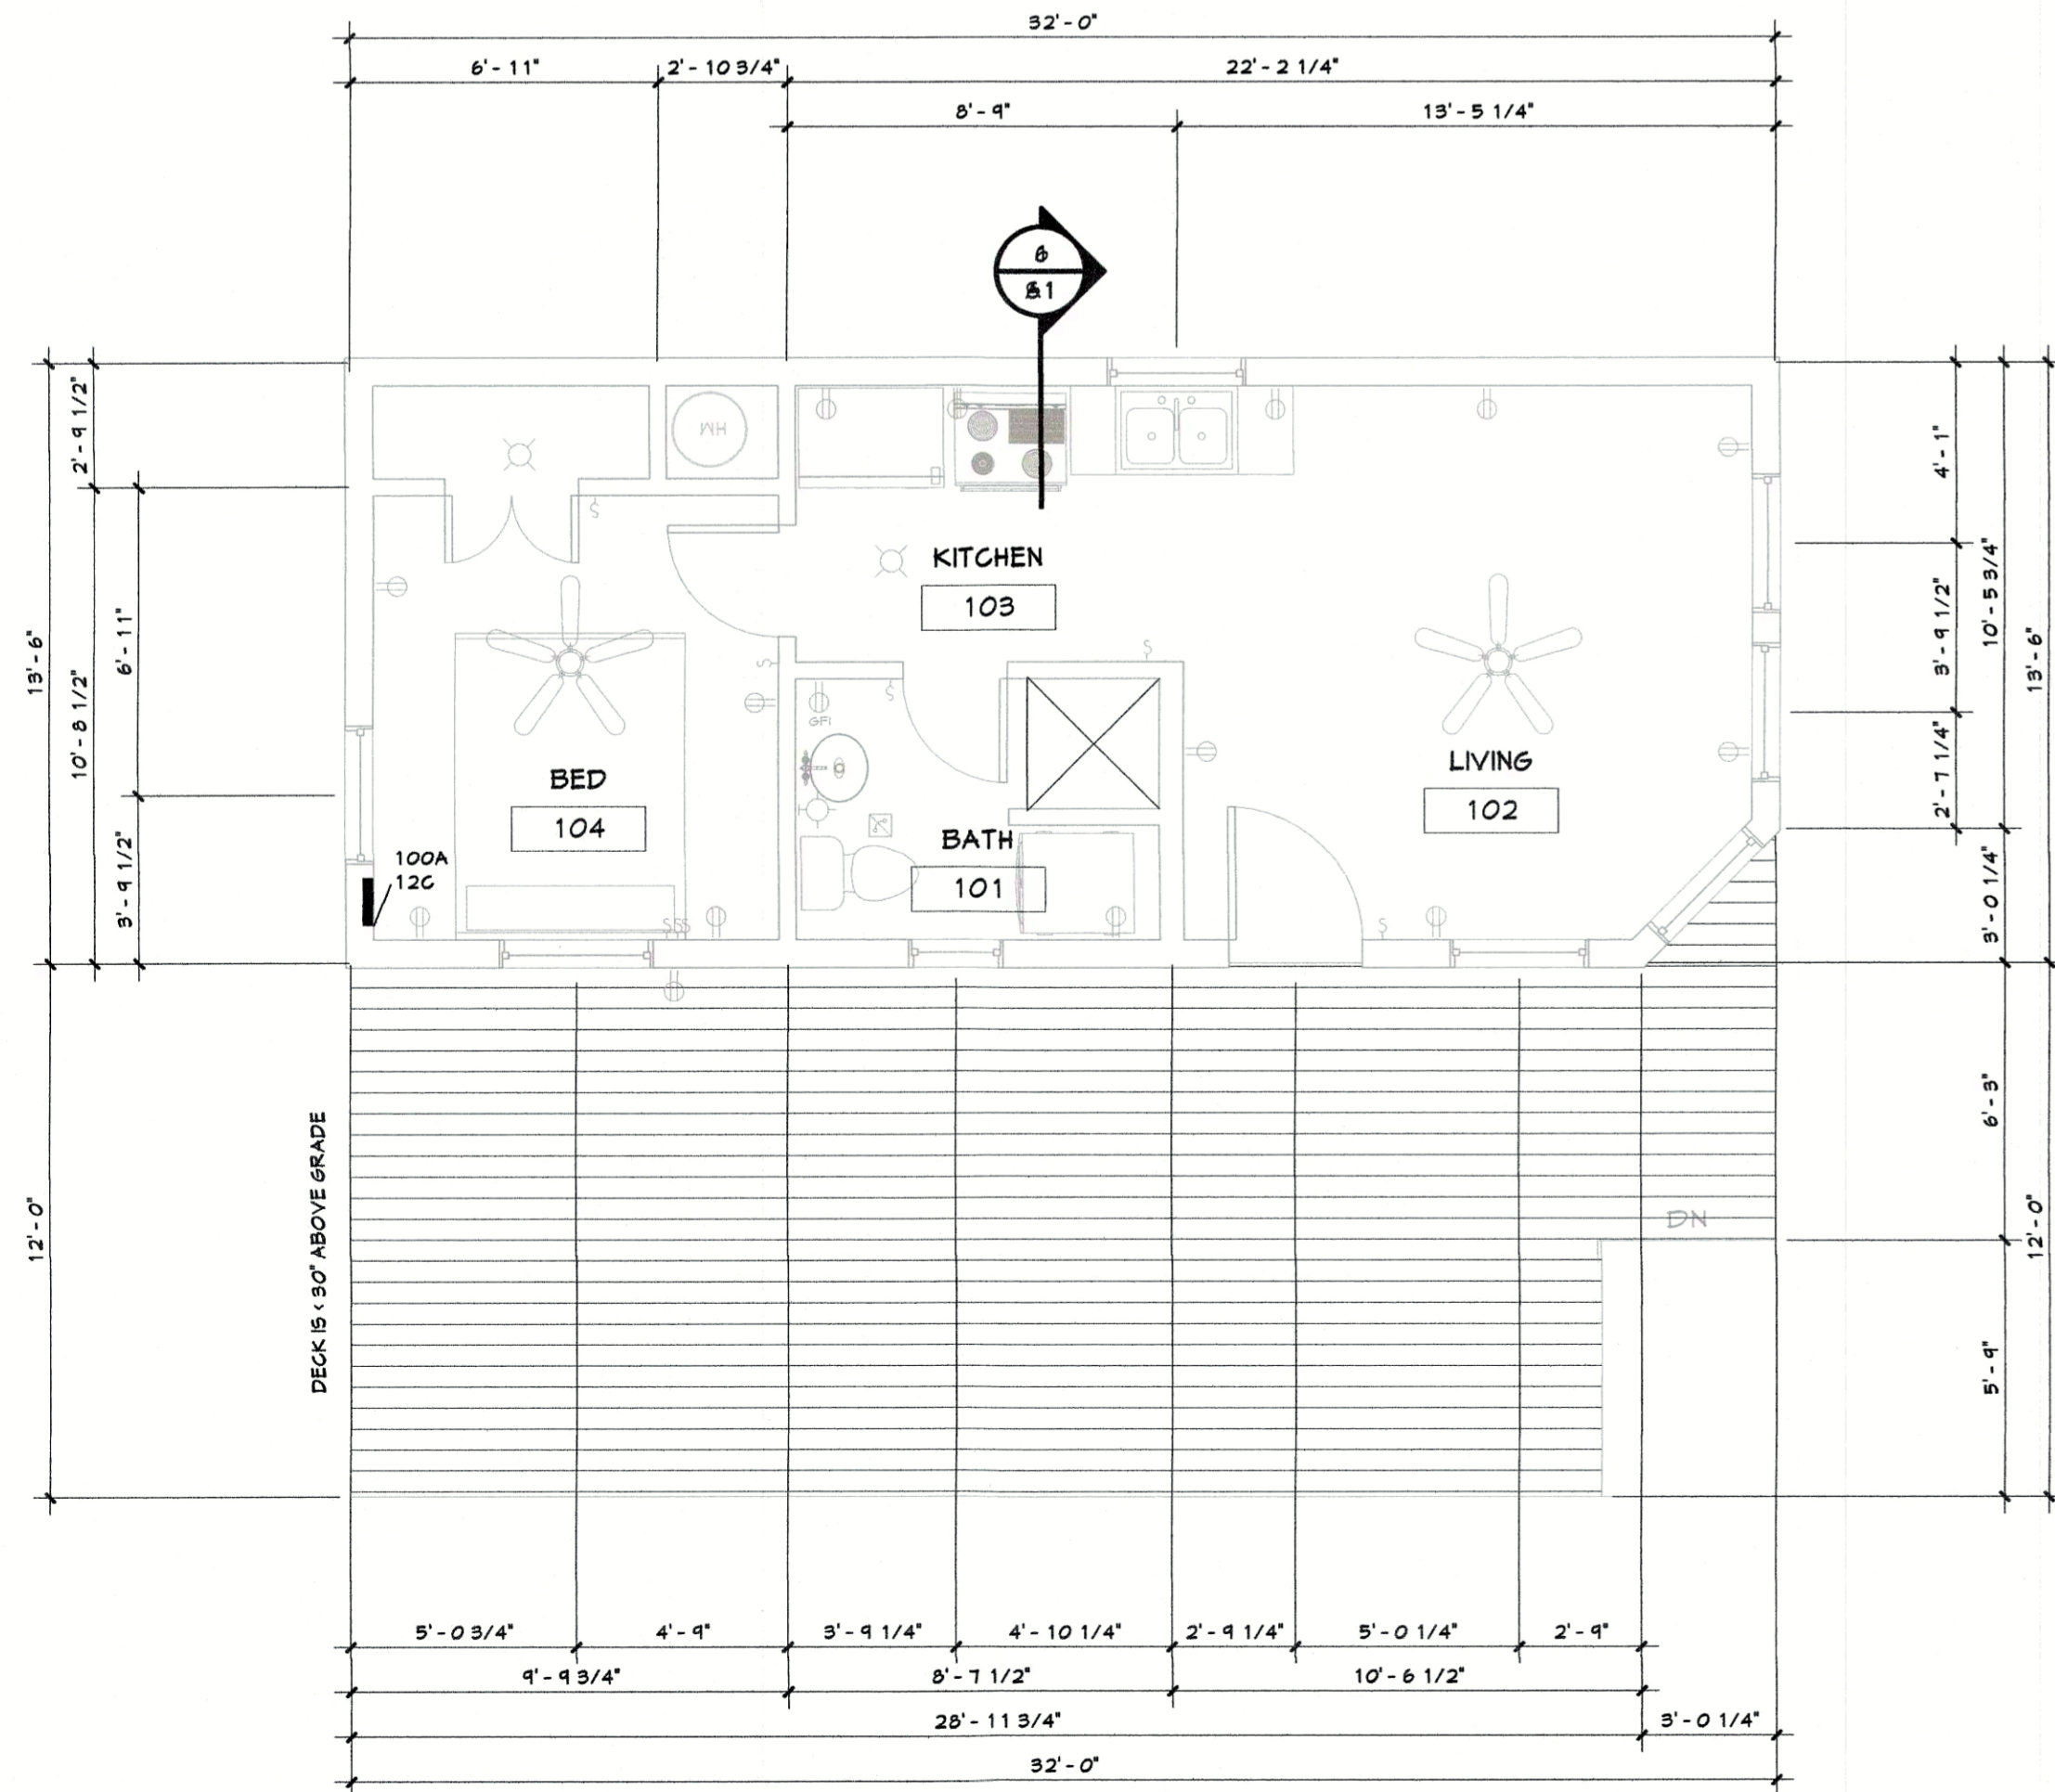

4 MAIN LEVEL FLOOR PLAN
1/4" = 1'-0"

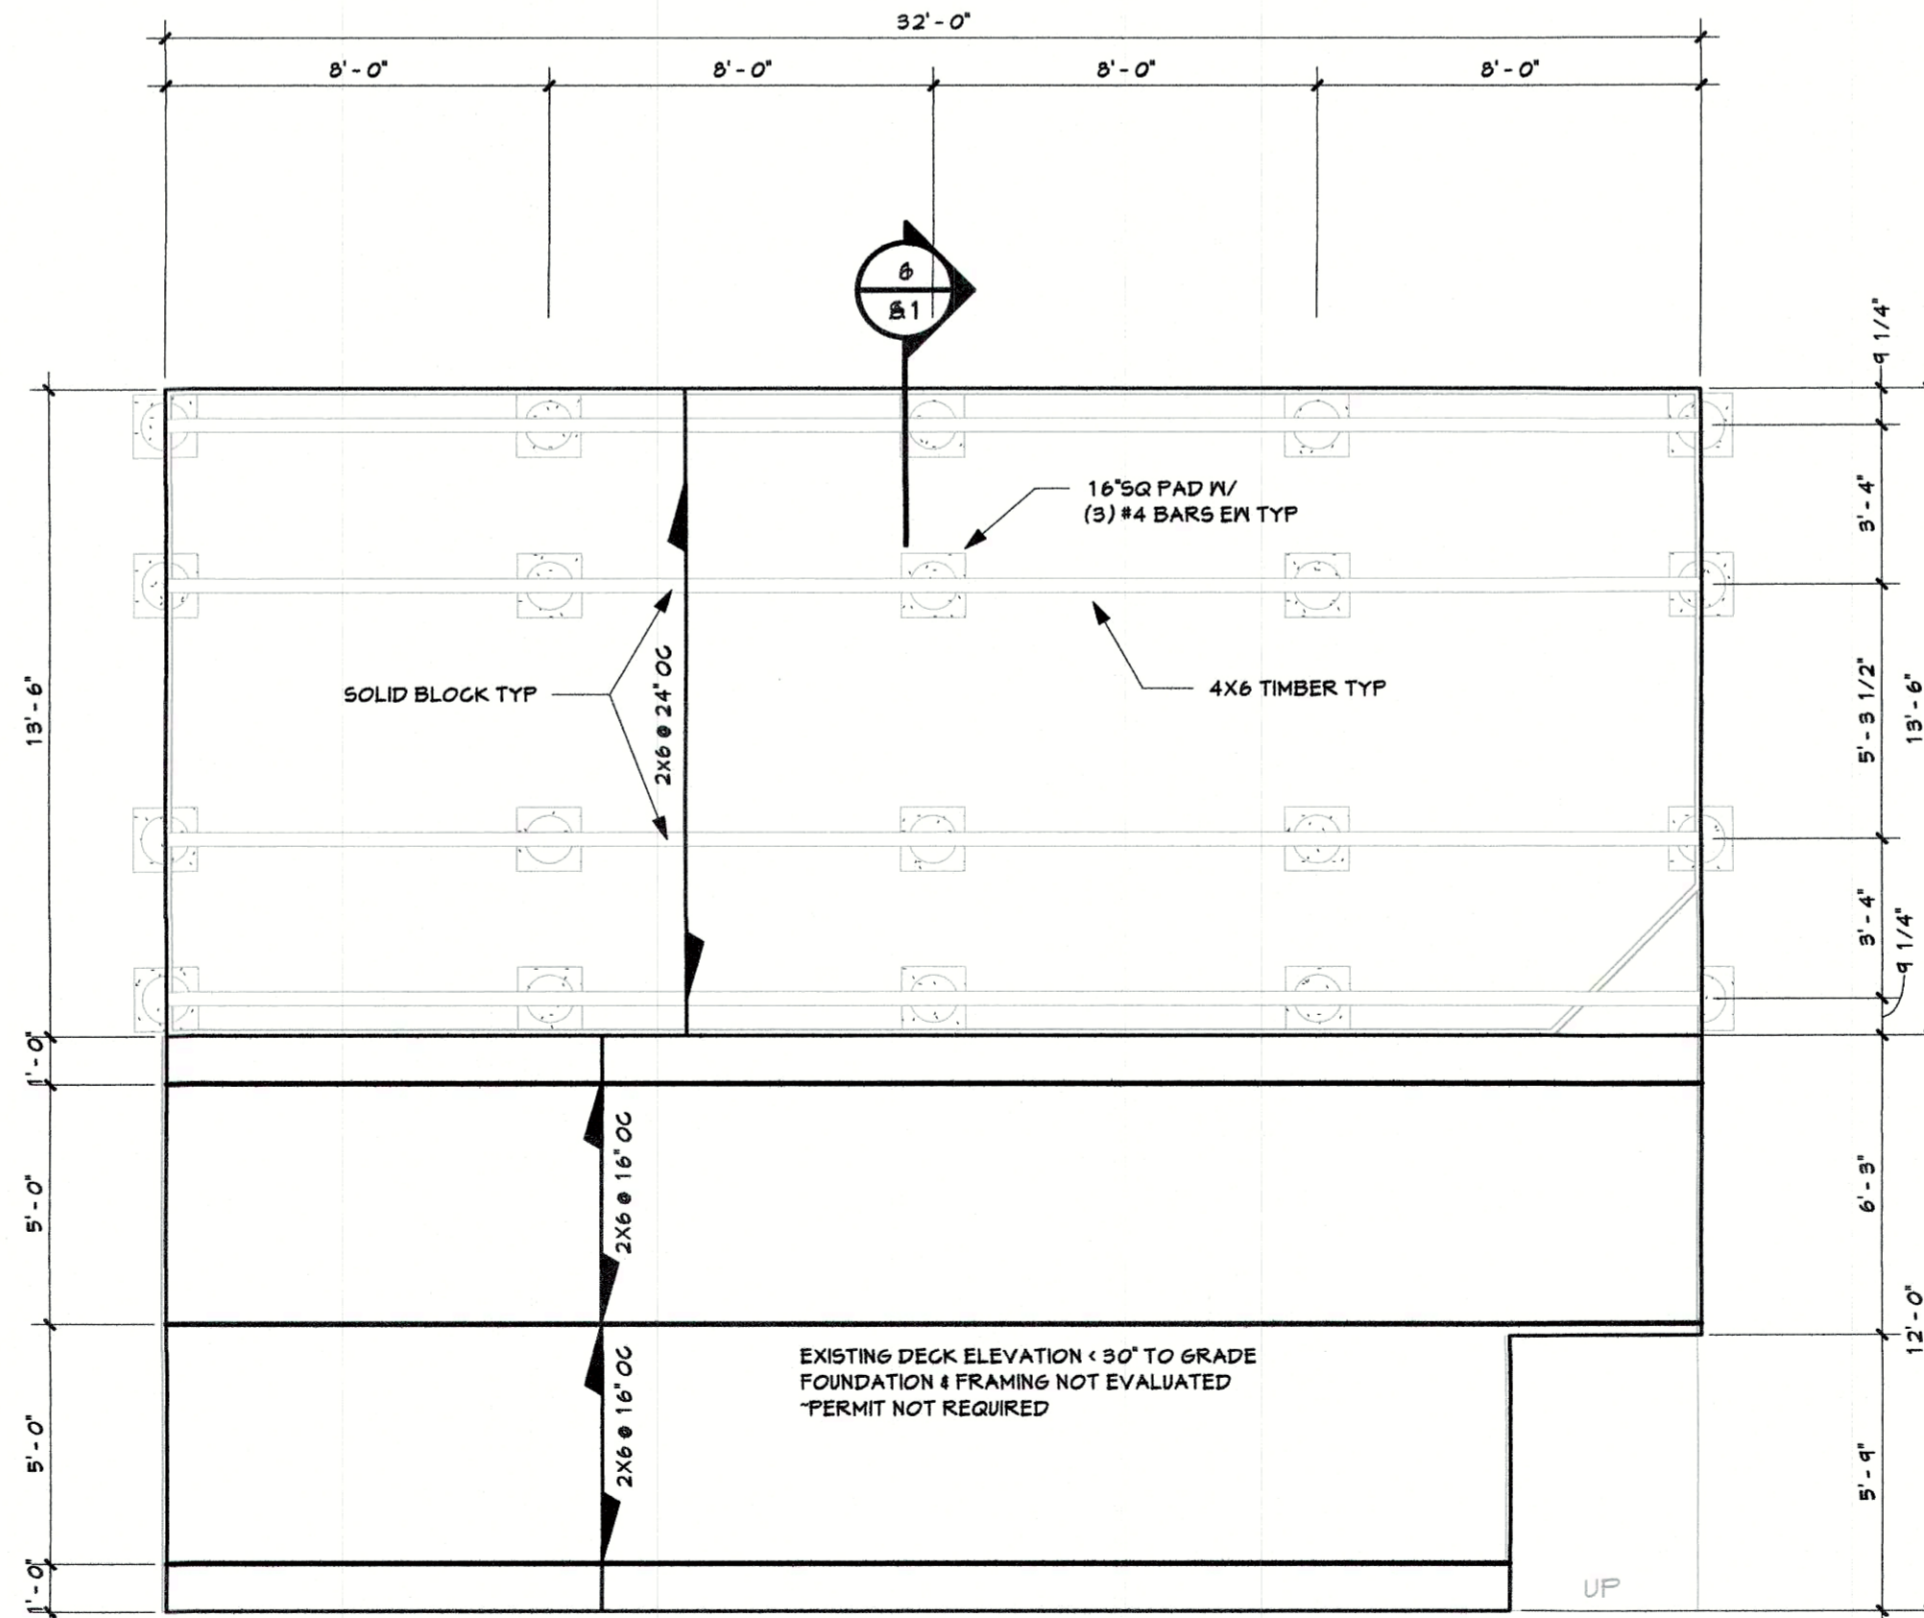

2 FOUNDATION & FRAMING PLAN
1/4" = 1'-0"

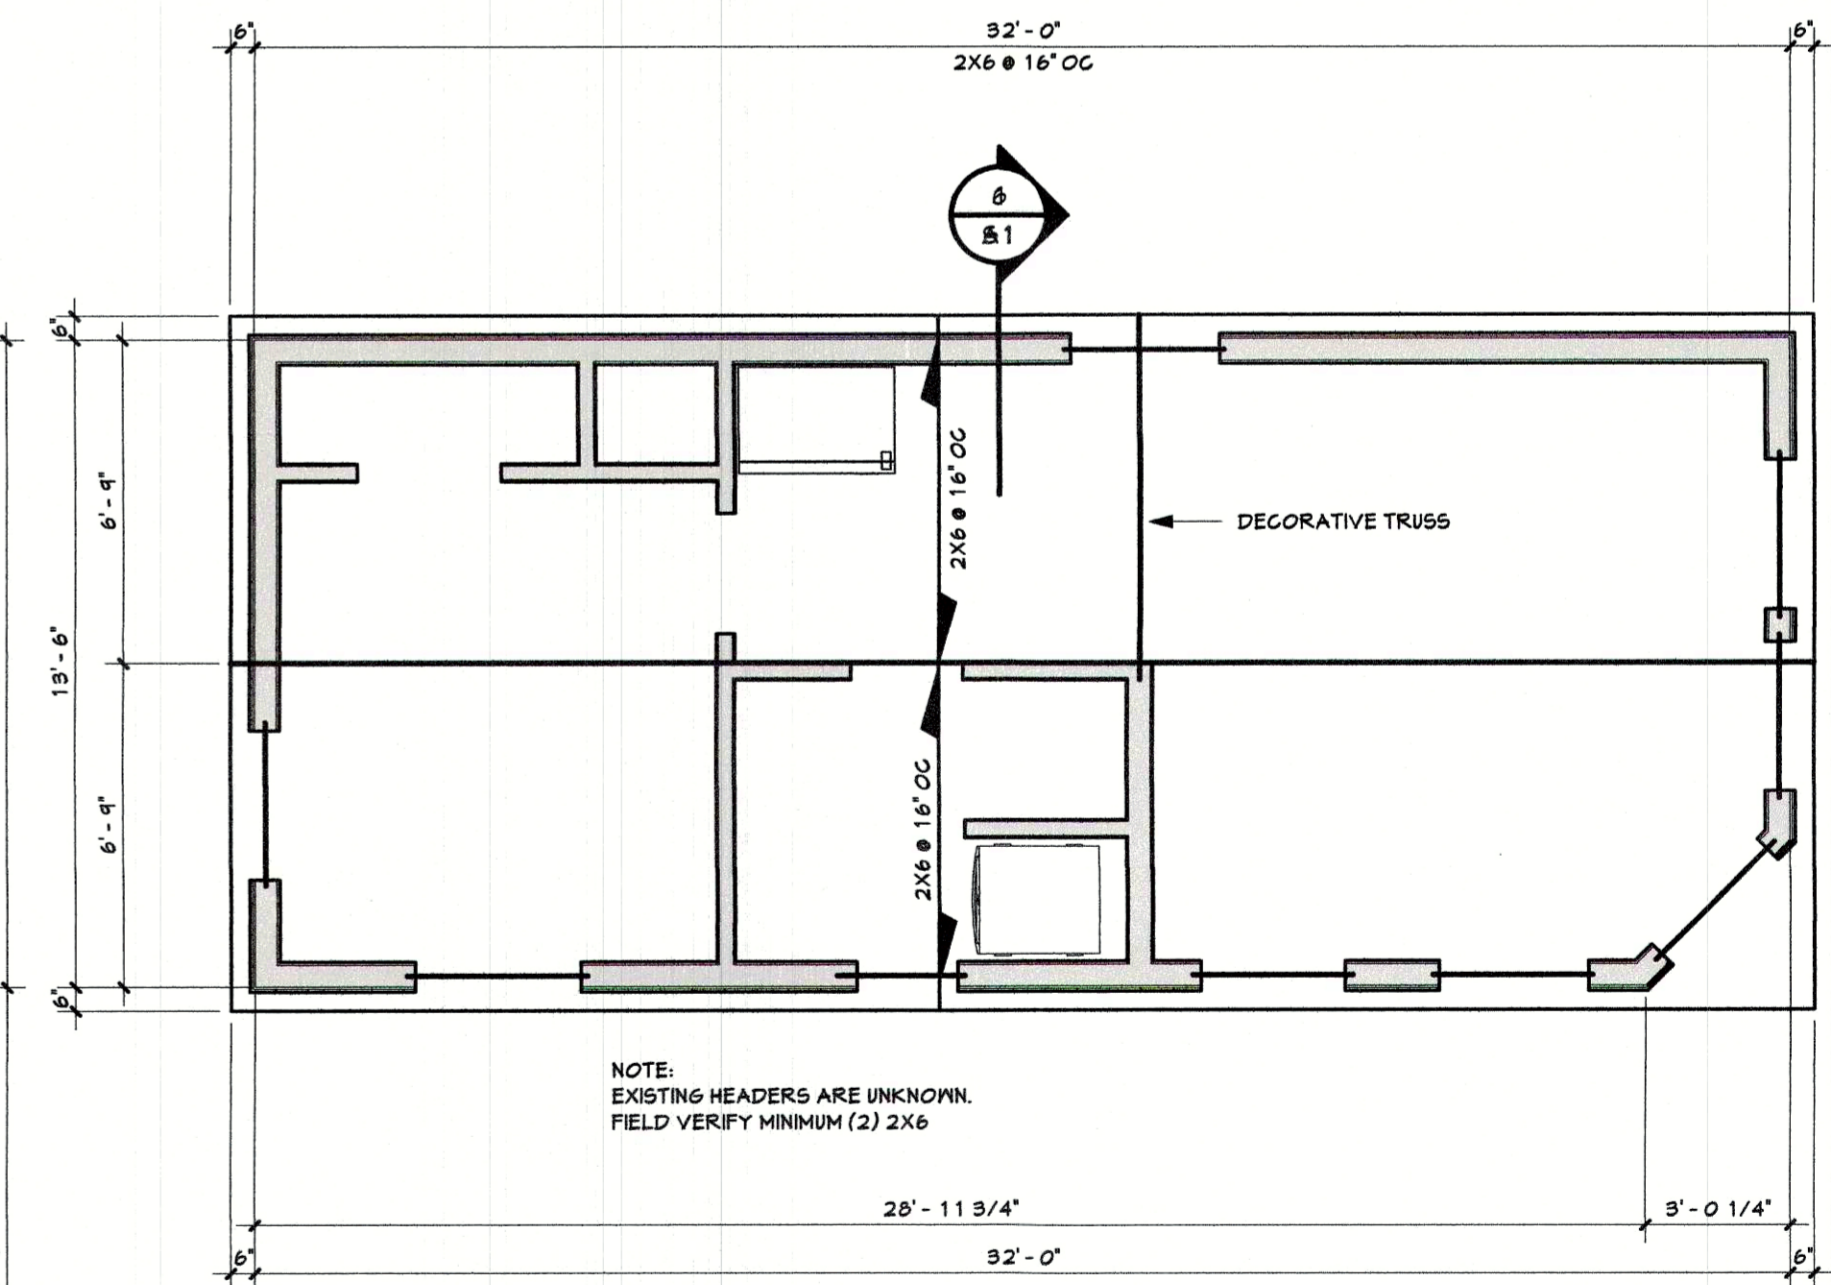

8 ROOF FRAMING PLAN
1/4" = 1'-0"



RCRBD
RECORD SET

DRAFTING SERVICE INC.
P.O. BOX 174121
426 OAK STREET
STEAMBOAT SPRINGS, COLORADO
81087-1219
FAX 970.879.8709
JAKES@SPRINGSPIES.COM



AS BUILT FLOOR PLANS, ELEVATIONS, & SECTION FOR
DWAYNE MOSADCHUK TRUST, C2 & C3
28850 TOBIANO TRL
ROUTT COUNTY CO
OWNER/ CONTRACTOR 846-5592


Job # 17.050
File 17.050A10
Date 2NOV17
Drawn KAB
Checked JMH
Rel'd 2NOV17
Rev'd

Sheet Number


A 1

SHEET 2 OF 3


11/2/2017 2:59:39 PM H:\proj\osadchuk\TRAILERS\Trailer.s.rvt

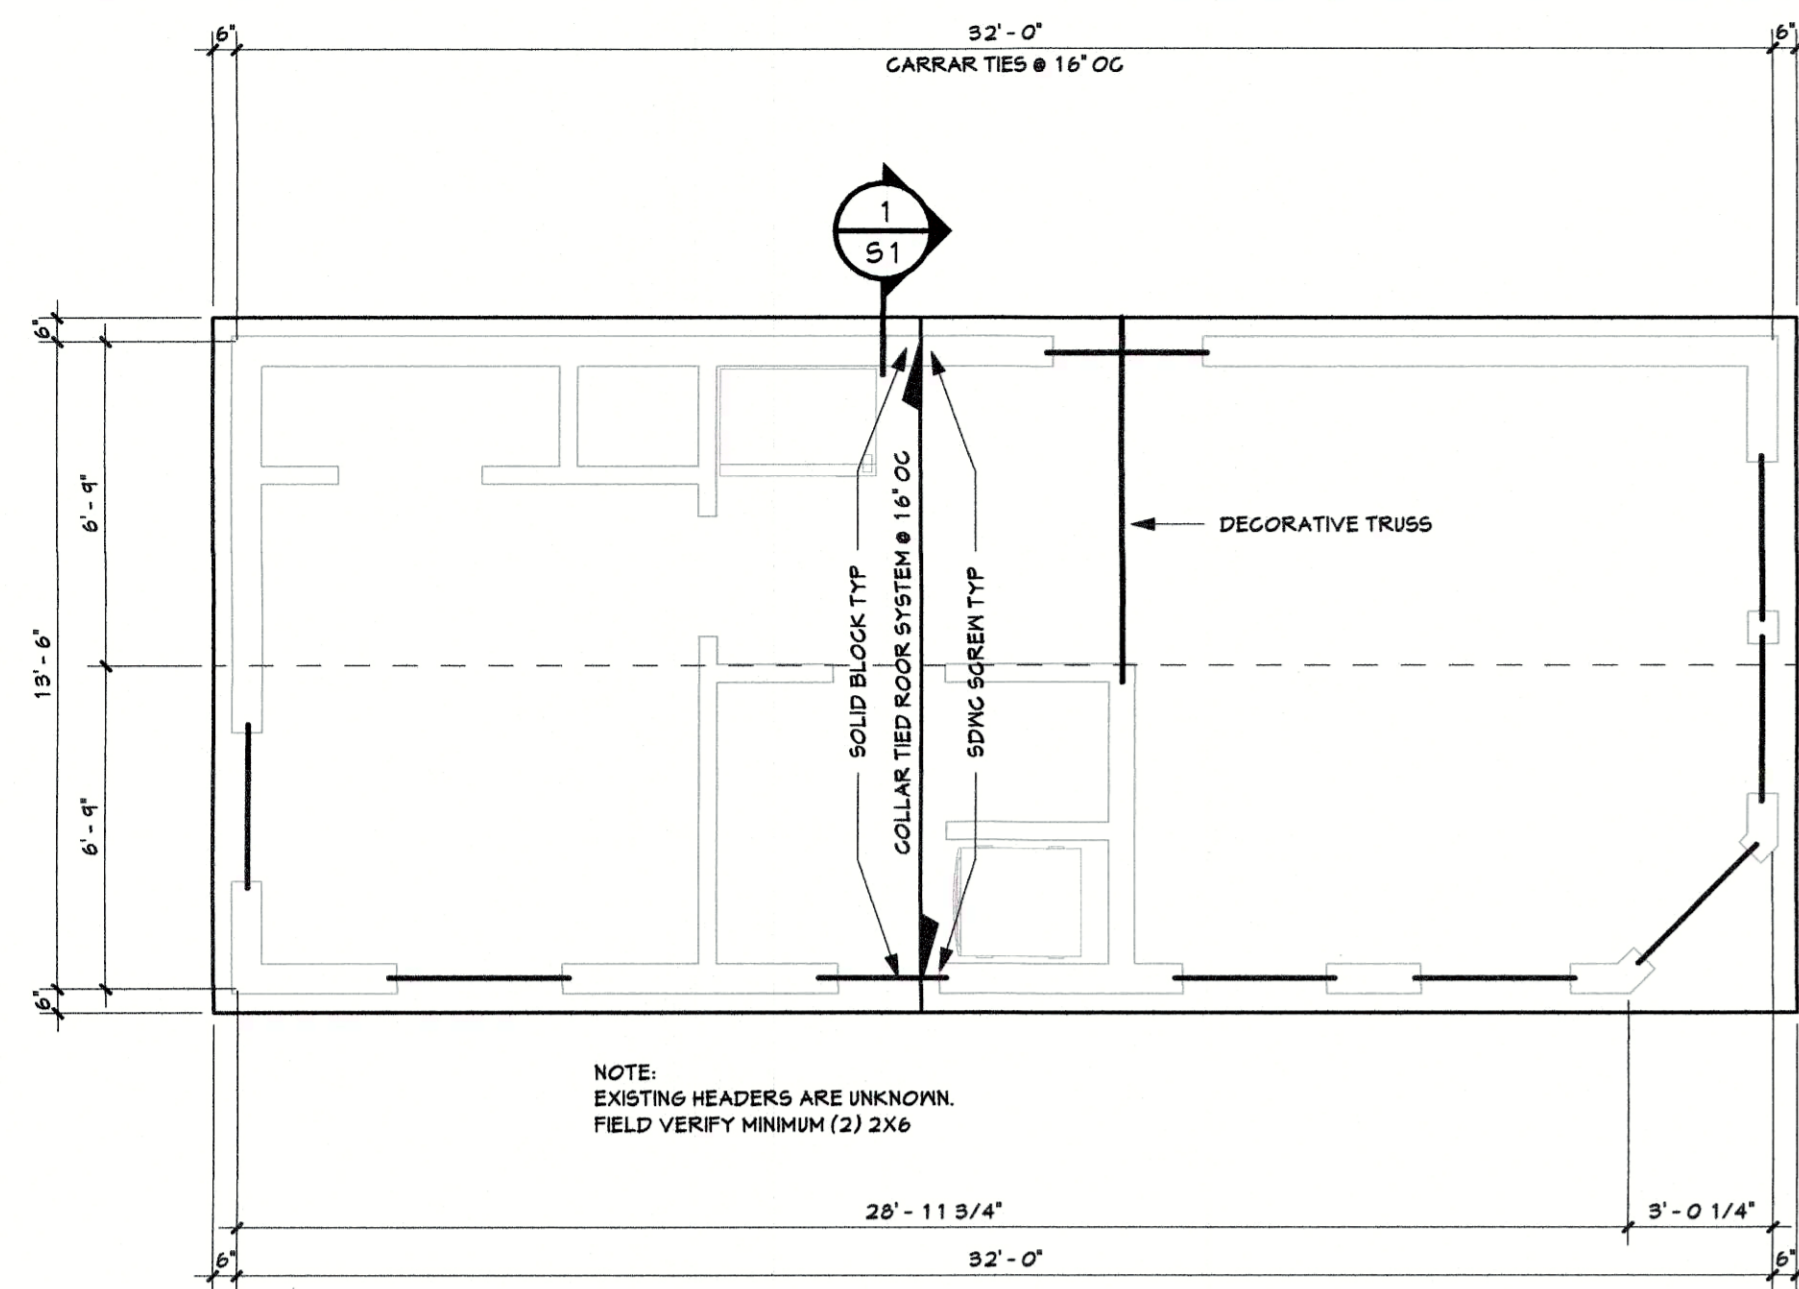


5 ROOF FRAMING REPAIR PLAN
1/4" = 1'-0"

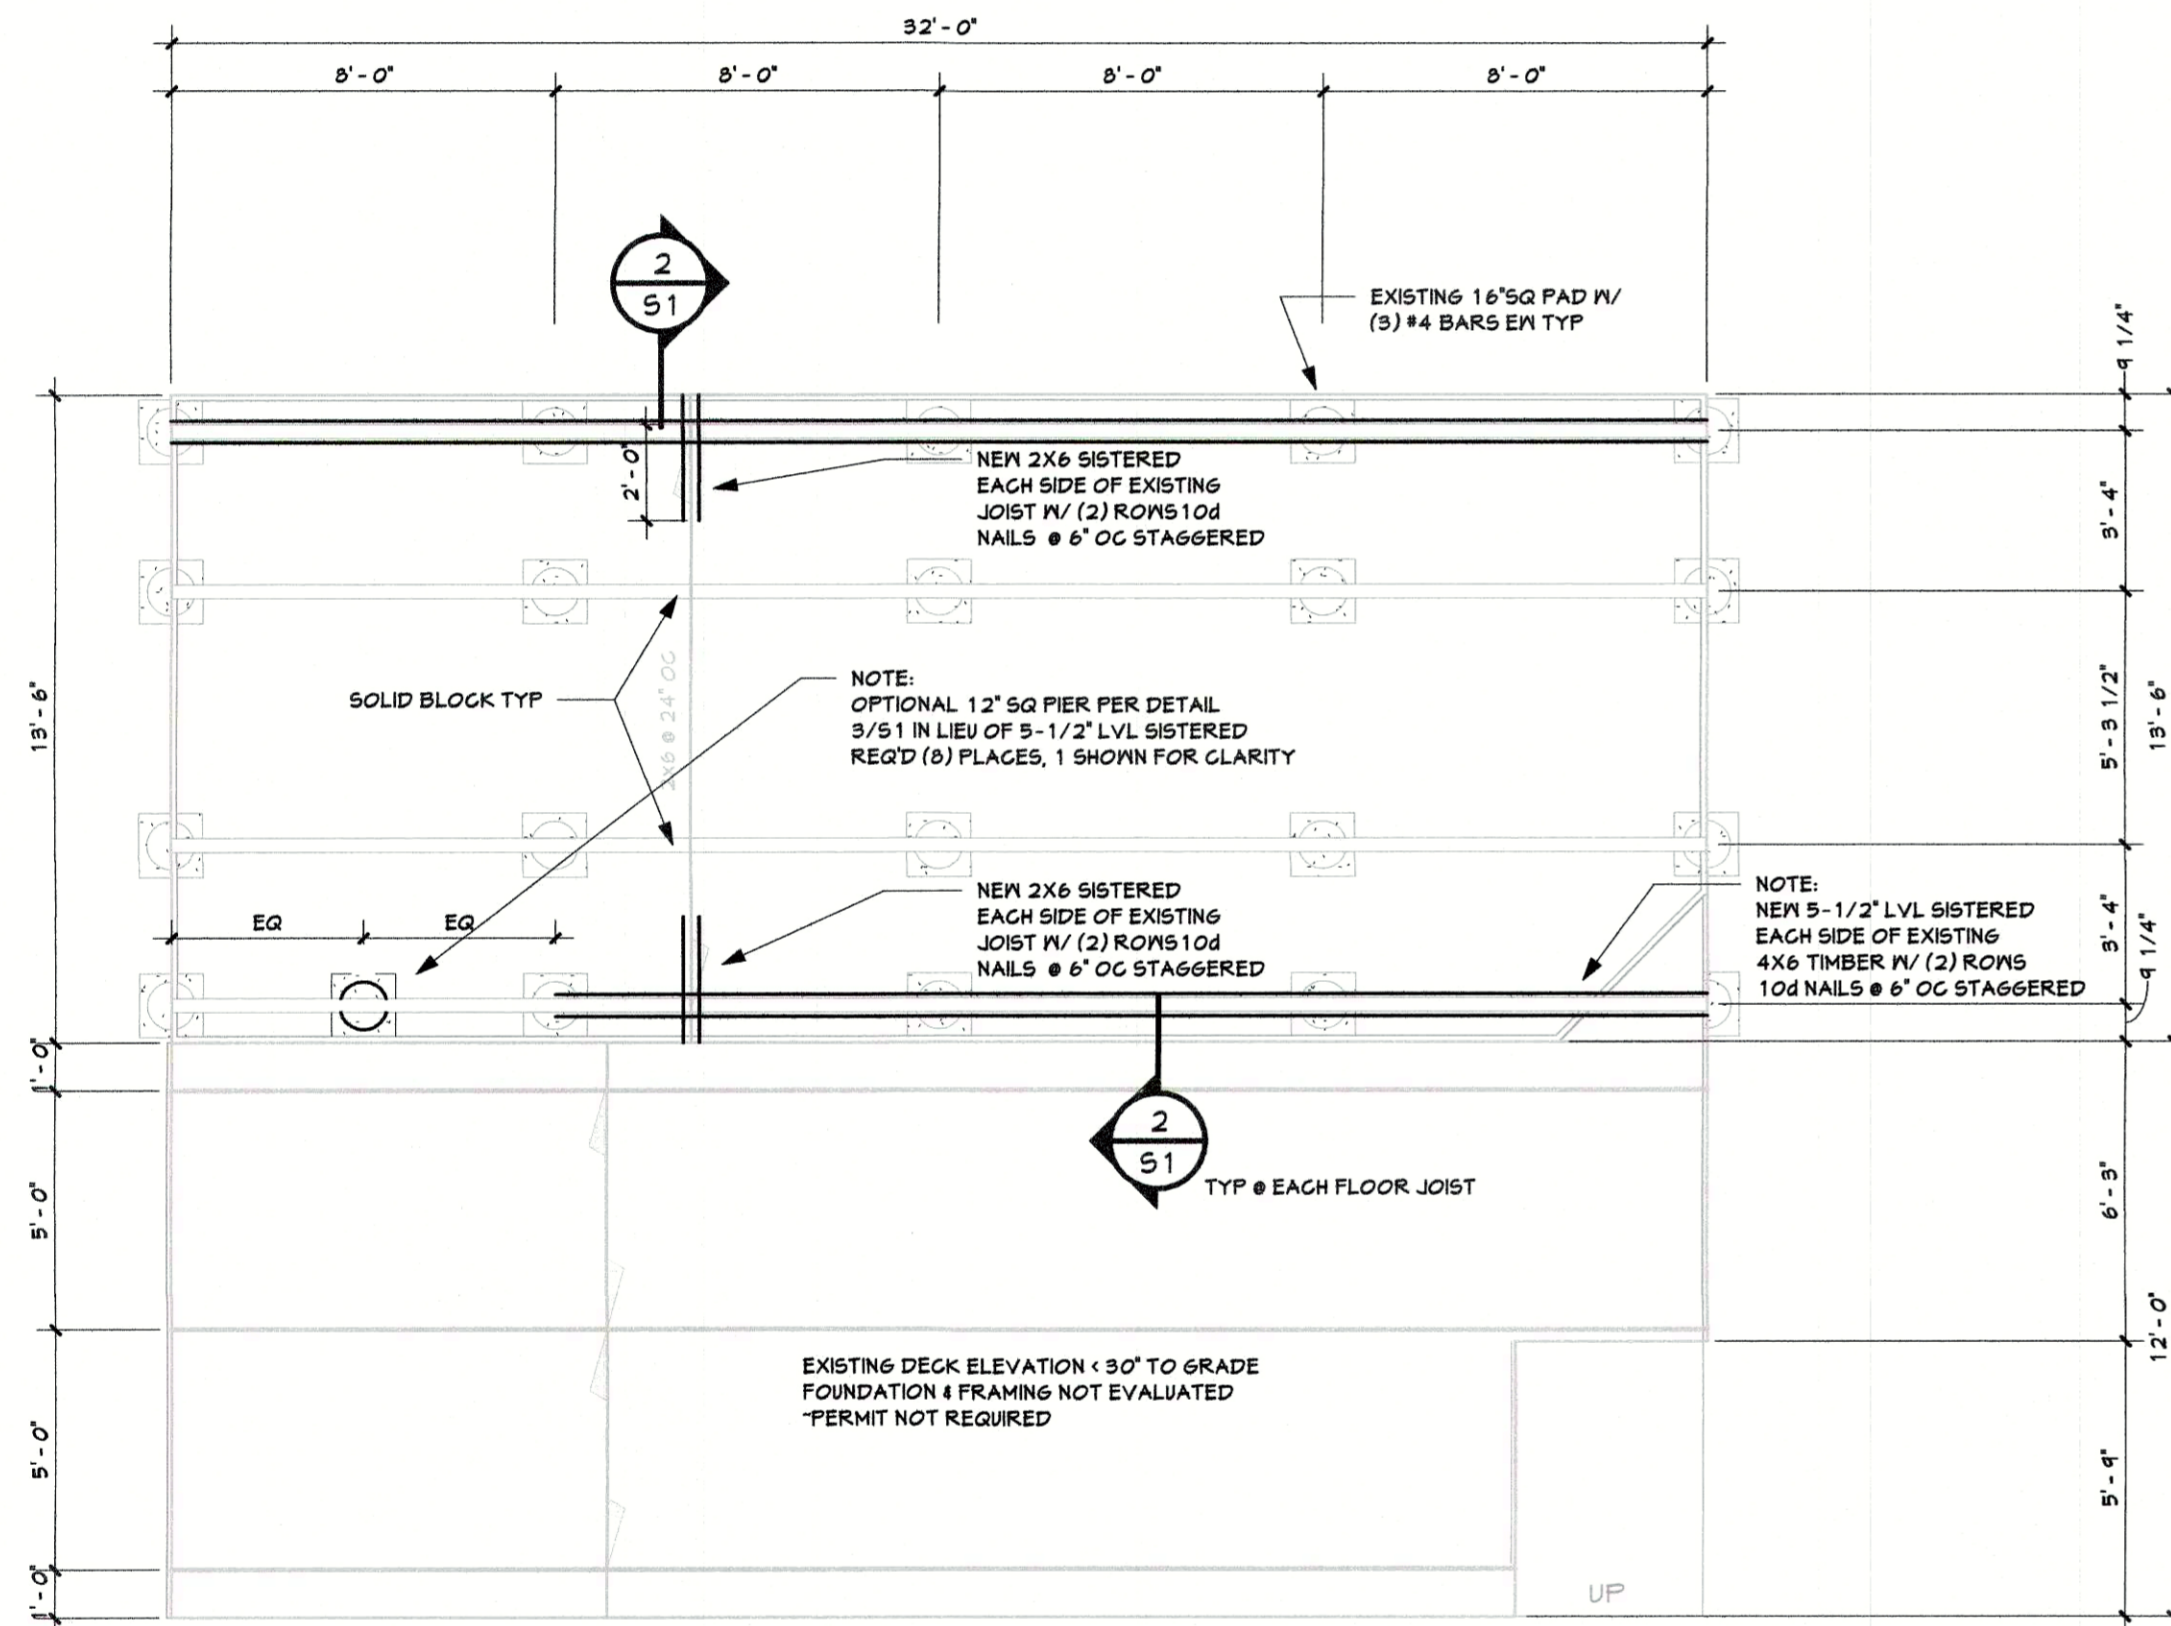


4 FOUNDATION & FRAMING REPAIR PLAN
1/4" = 1'-0"

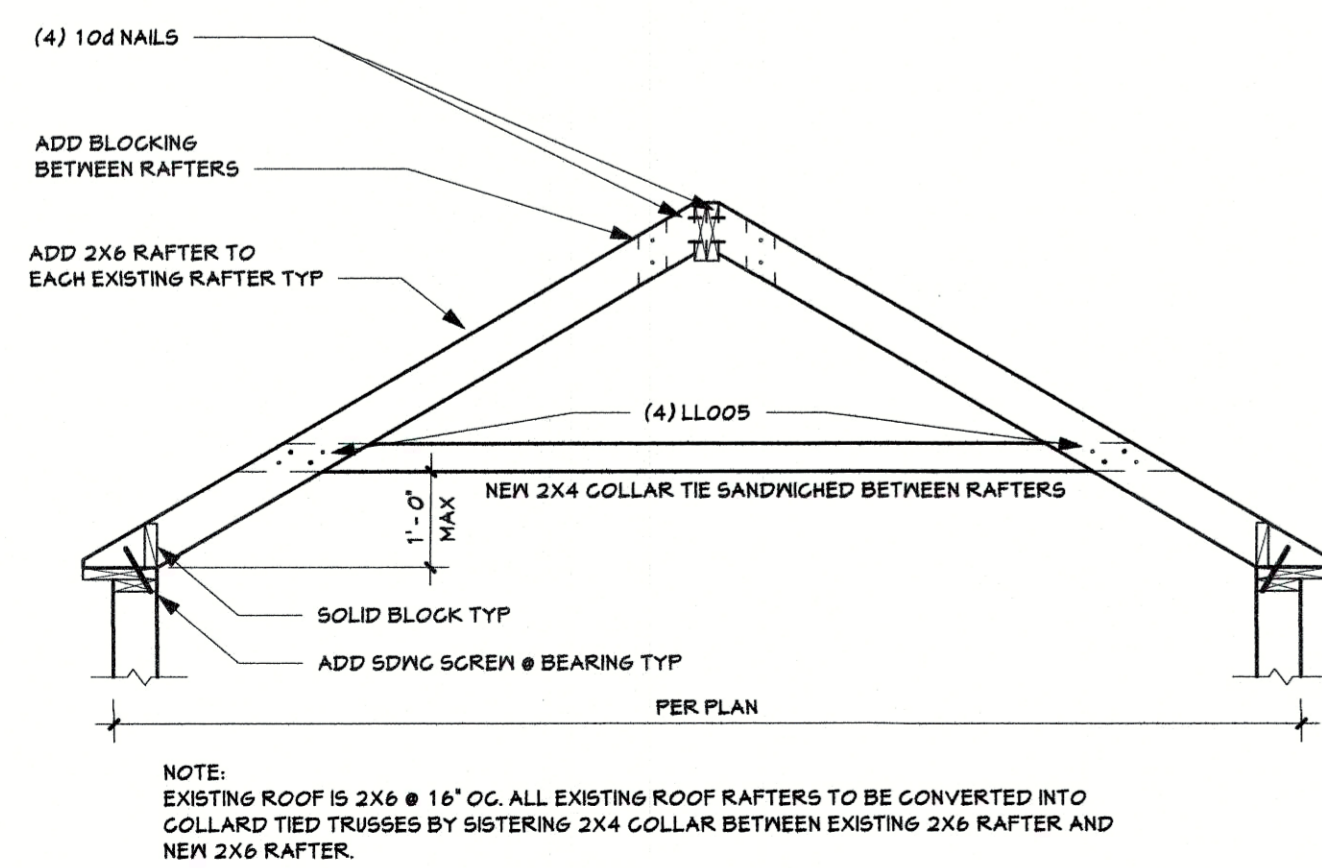


1 COLLAR TIE DETAIL
1/2" = 1'-0"

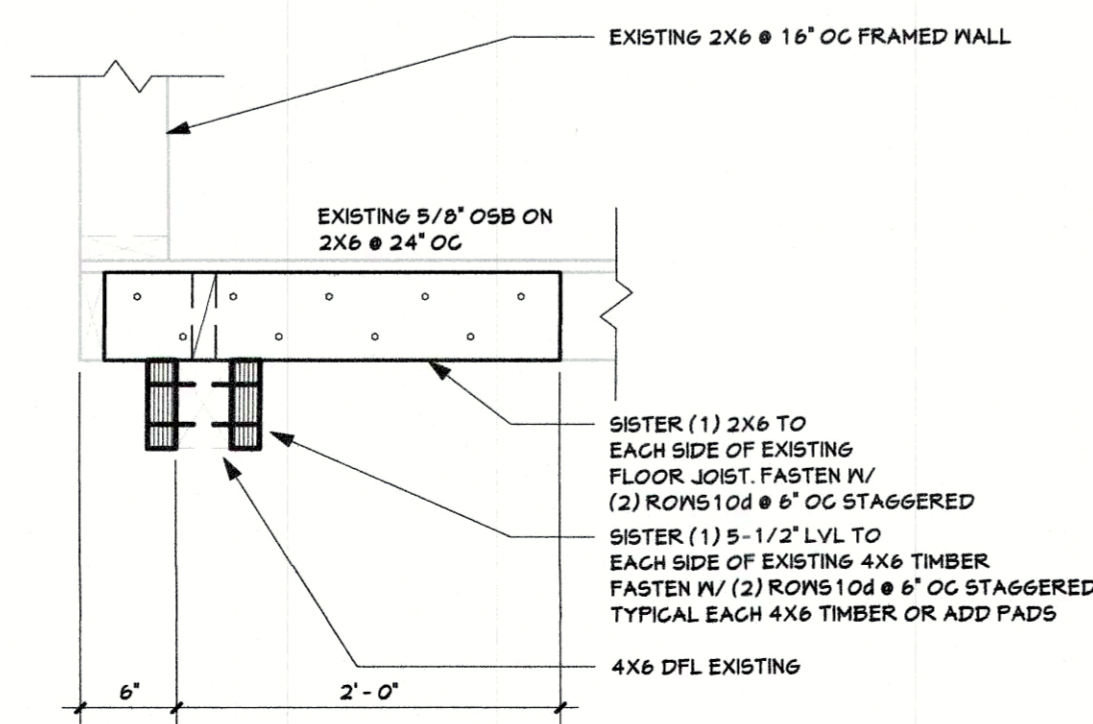

2 RIM DETAIL
1" = 1'-0"

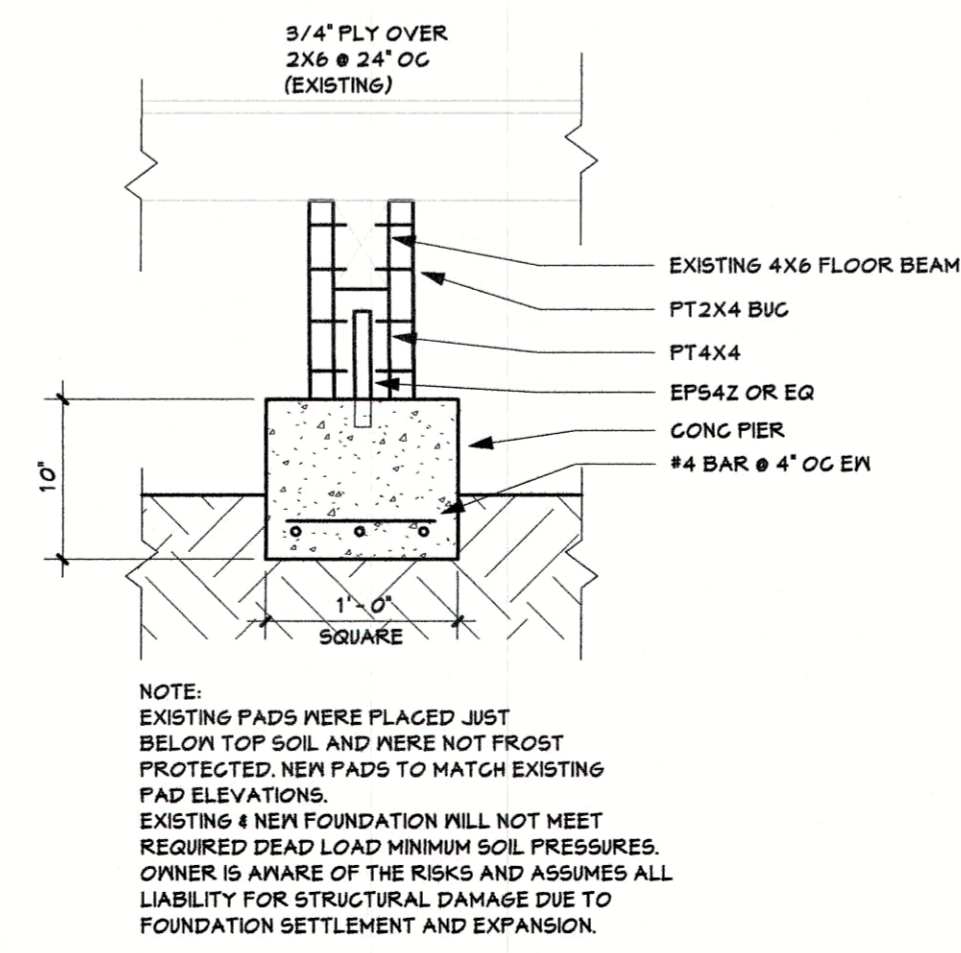

3 OPTIONAL PAD DESIGN
1" = 1'-0"

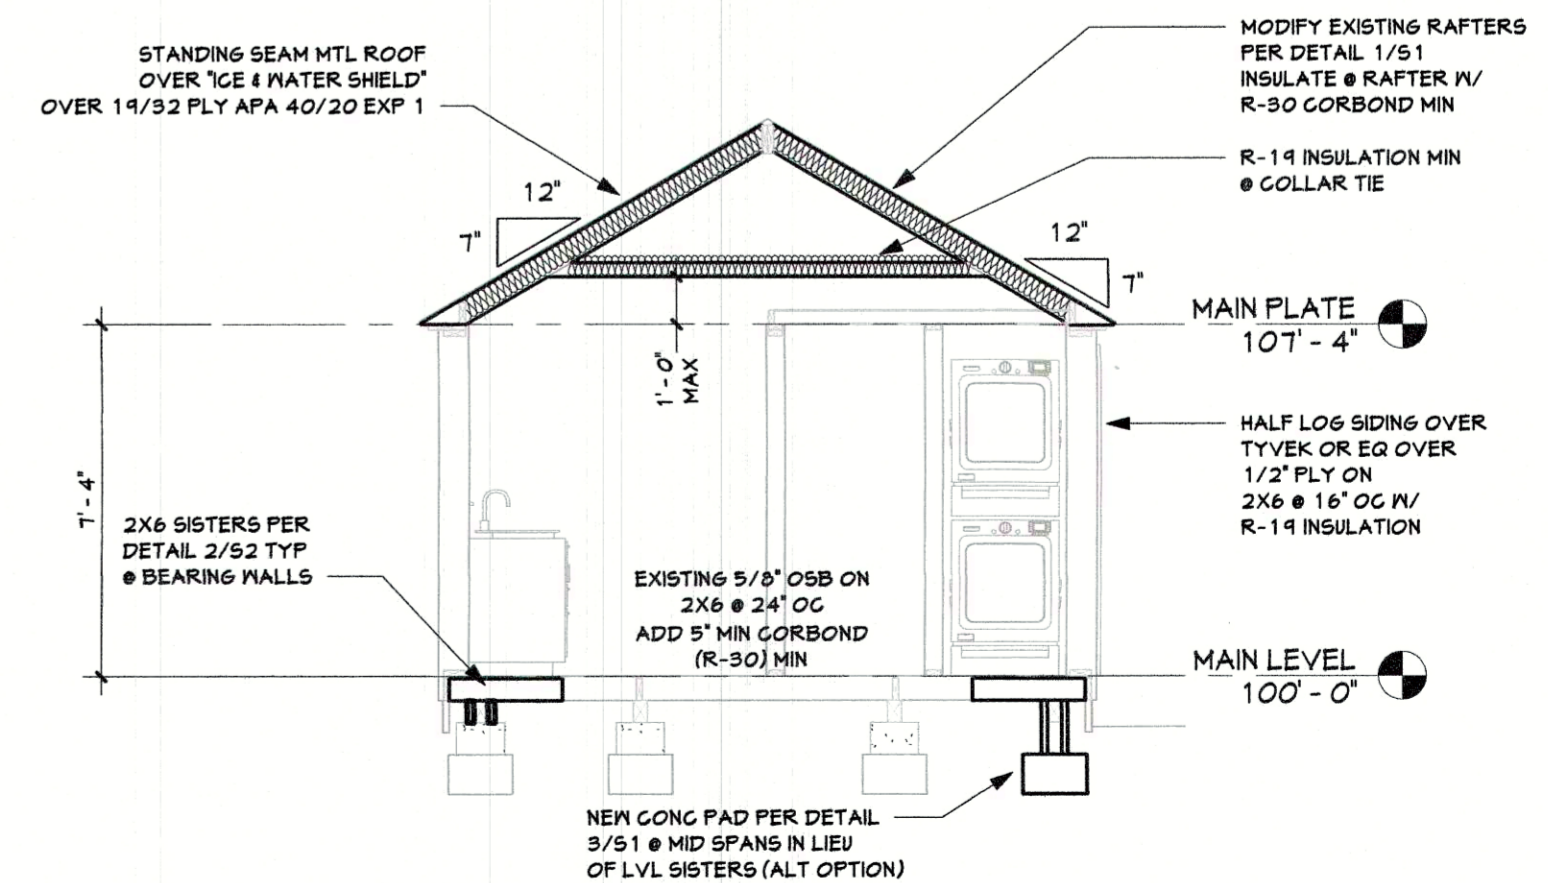

6 NEW TYP SECTION
1/4" = 1'-0"

RCRBD
RECORD SET

Jake's
CELEBRATING 30 YEARS
IN BUSINESS 1987-2017


COLORADO LICENSED
PROFESSIONAL ENGINEER
11-2-17
"STRUCTURE ONLY"

REPAIR DETAILS & SPECIFICATIONS
DWAYNE M OSADCHUK TRUST, C2 & C3
23850 TOBIANO TRL
ROUTT COUNTY CO
OWNER/ CONTRACTOR 346-5592


Job # 17.050
File 17.050510
Date 2NOV17
Drawn JMH
Checked JMH
Re'd 2NOV17
Rev'd

Sheet Number
S1
SHEET 3 OF 3


11/2/2017 2:59:26 PM H:\proj\osadchuk\TRAILERS\Trailer 1.rvt

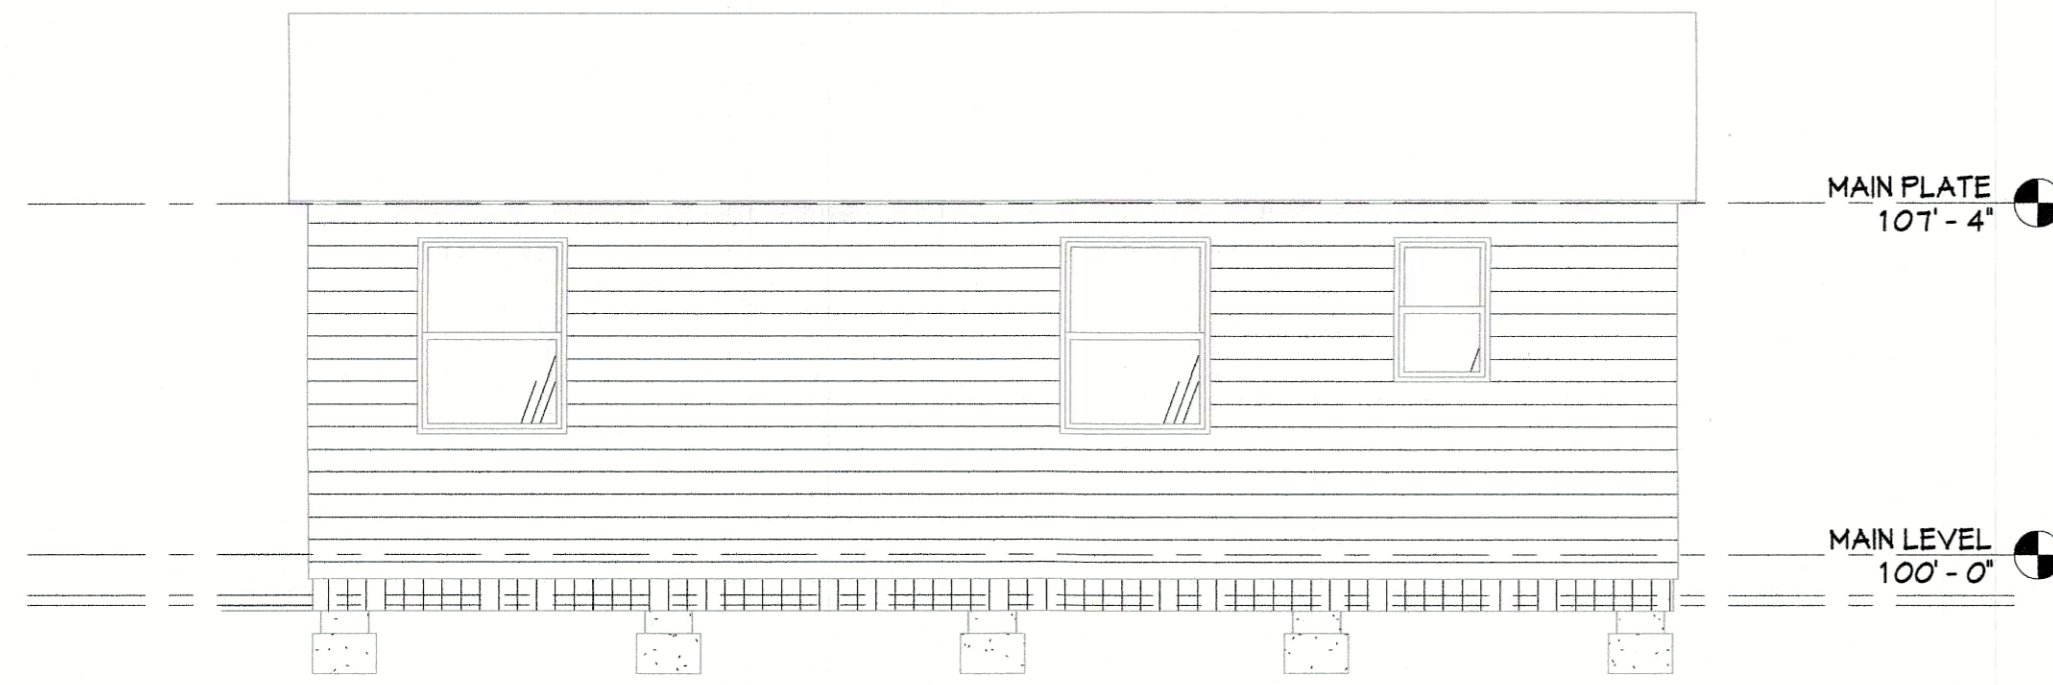


5 North
1/4" = 1'-0"

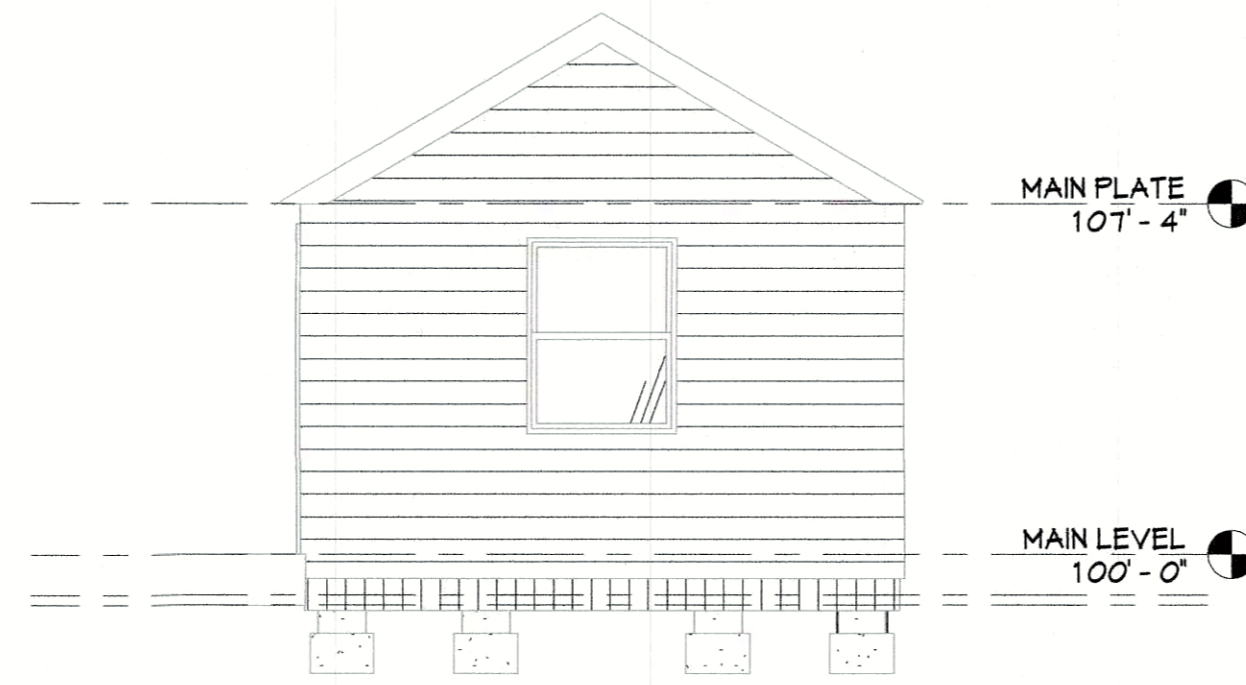


7 West
1/4" = 1'-0"

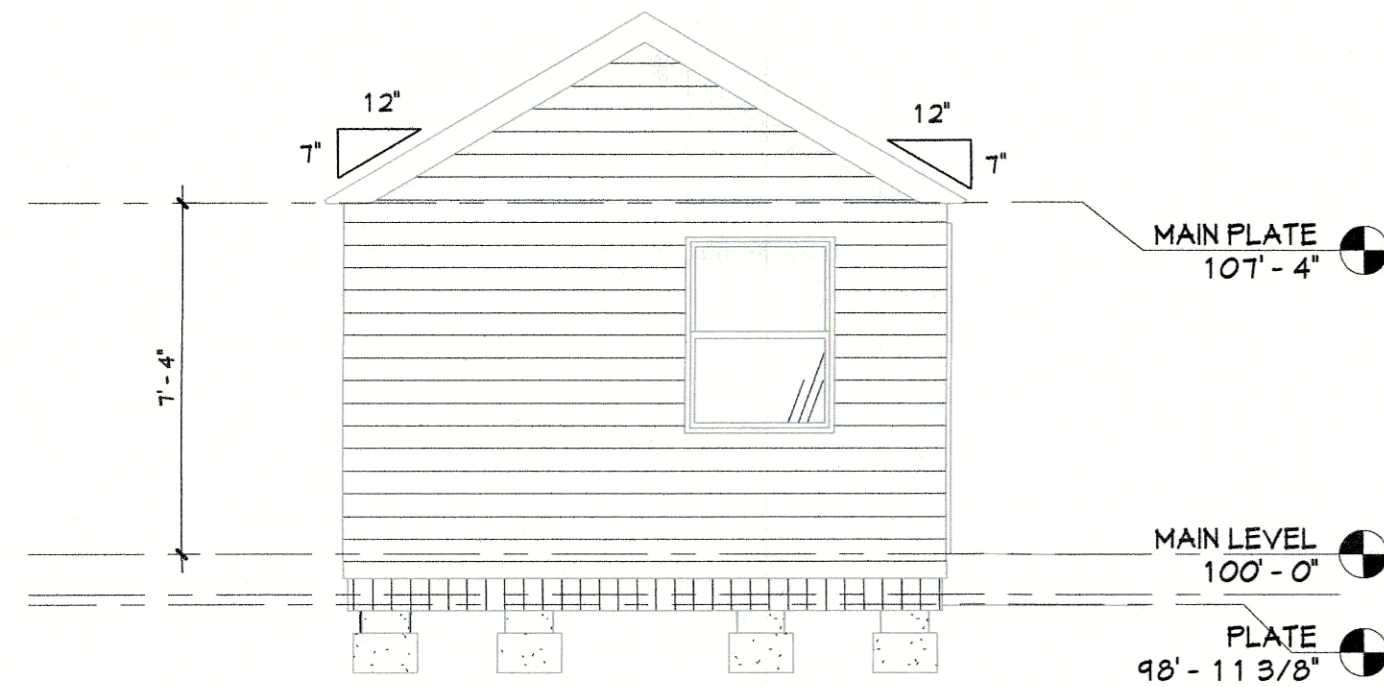


3 East
1/4" = 1'-0"

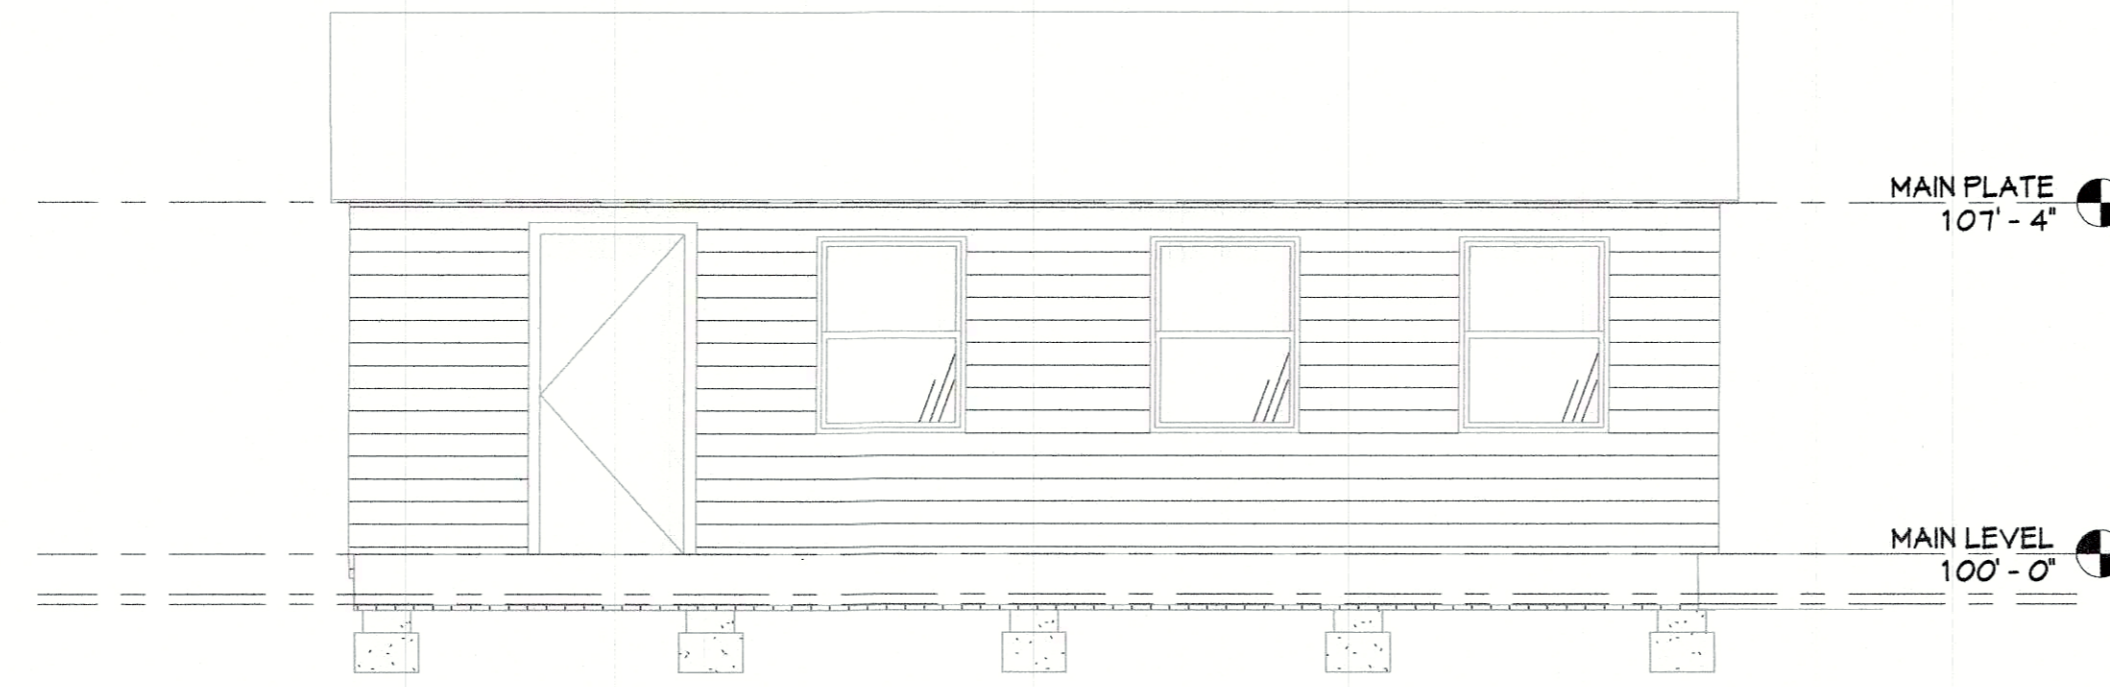


6 South
1/4" = 1'-0"

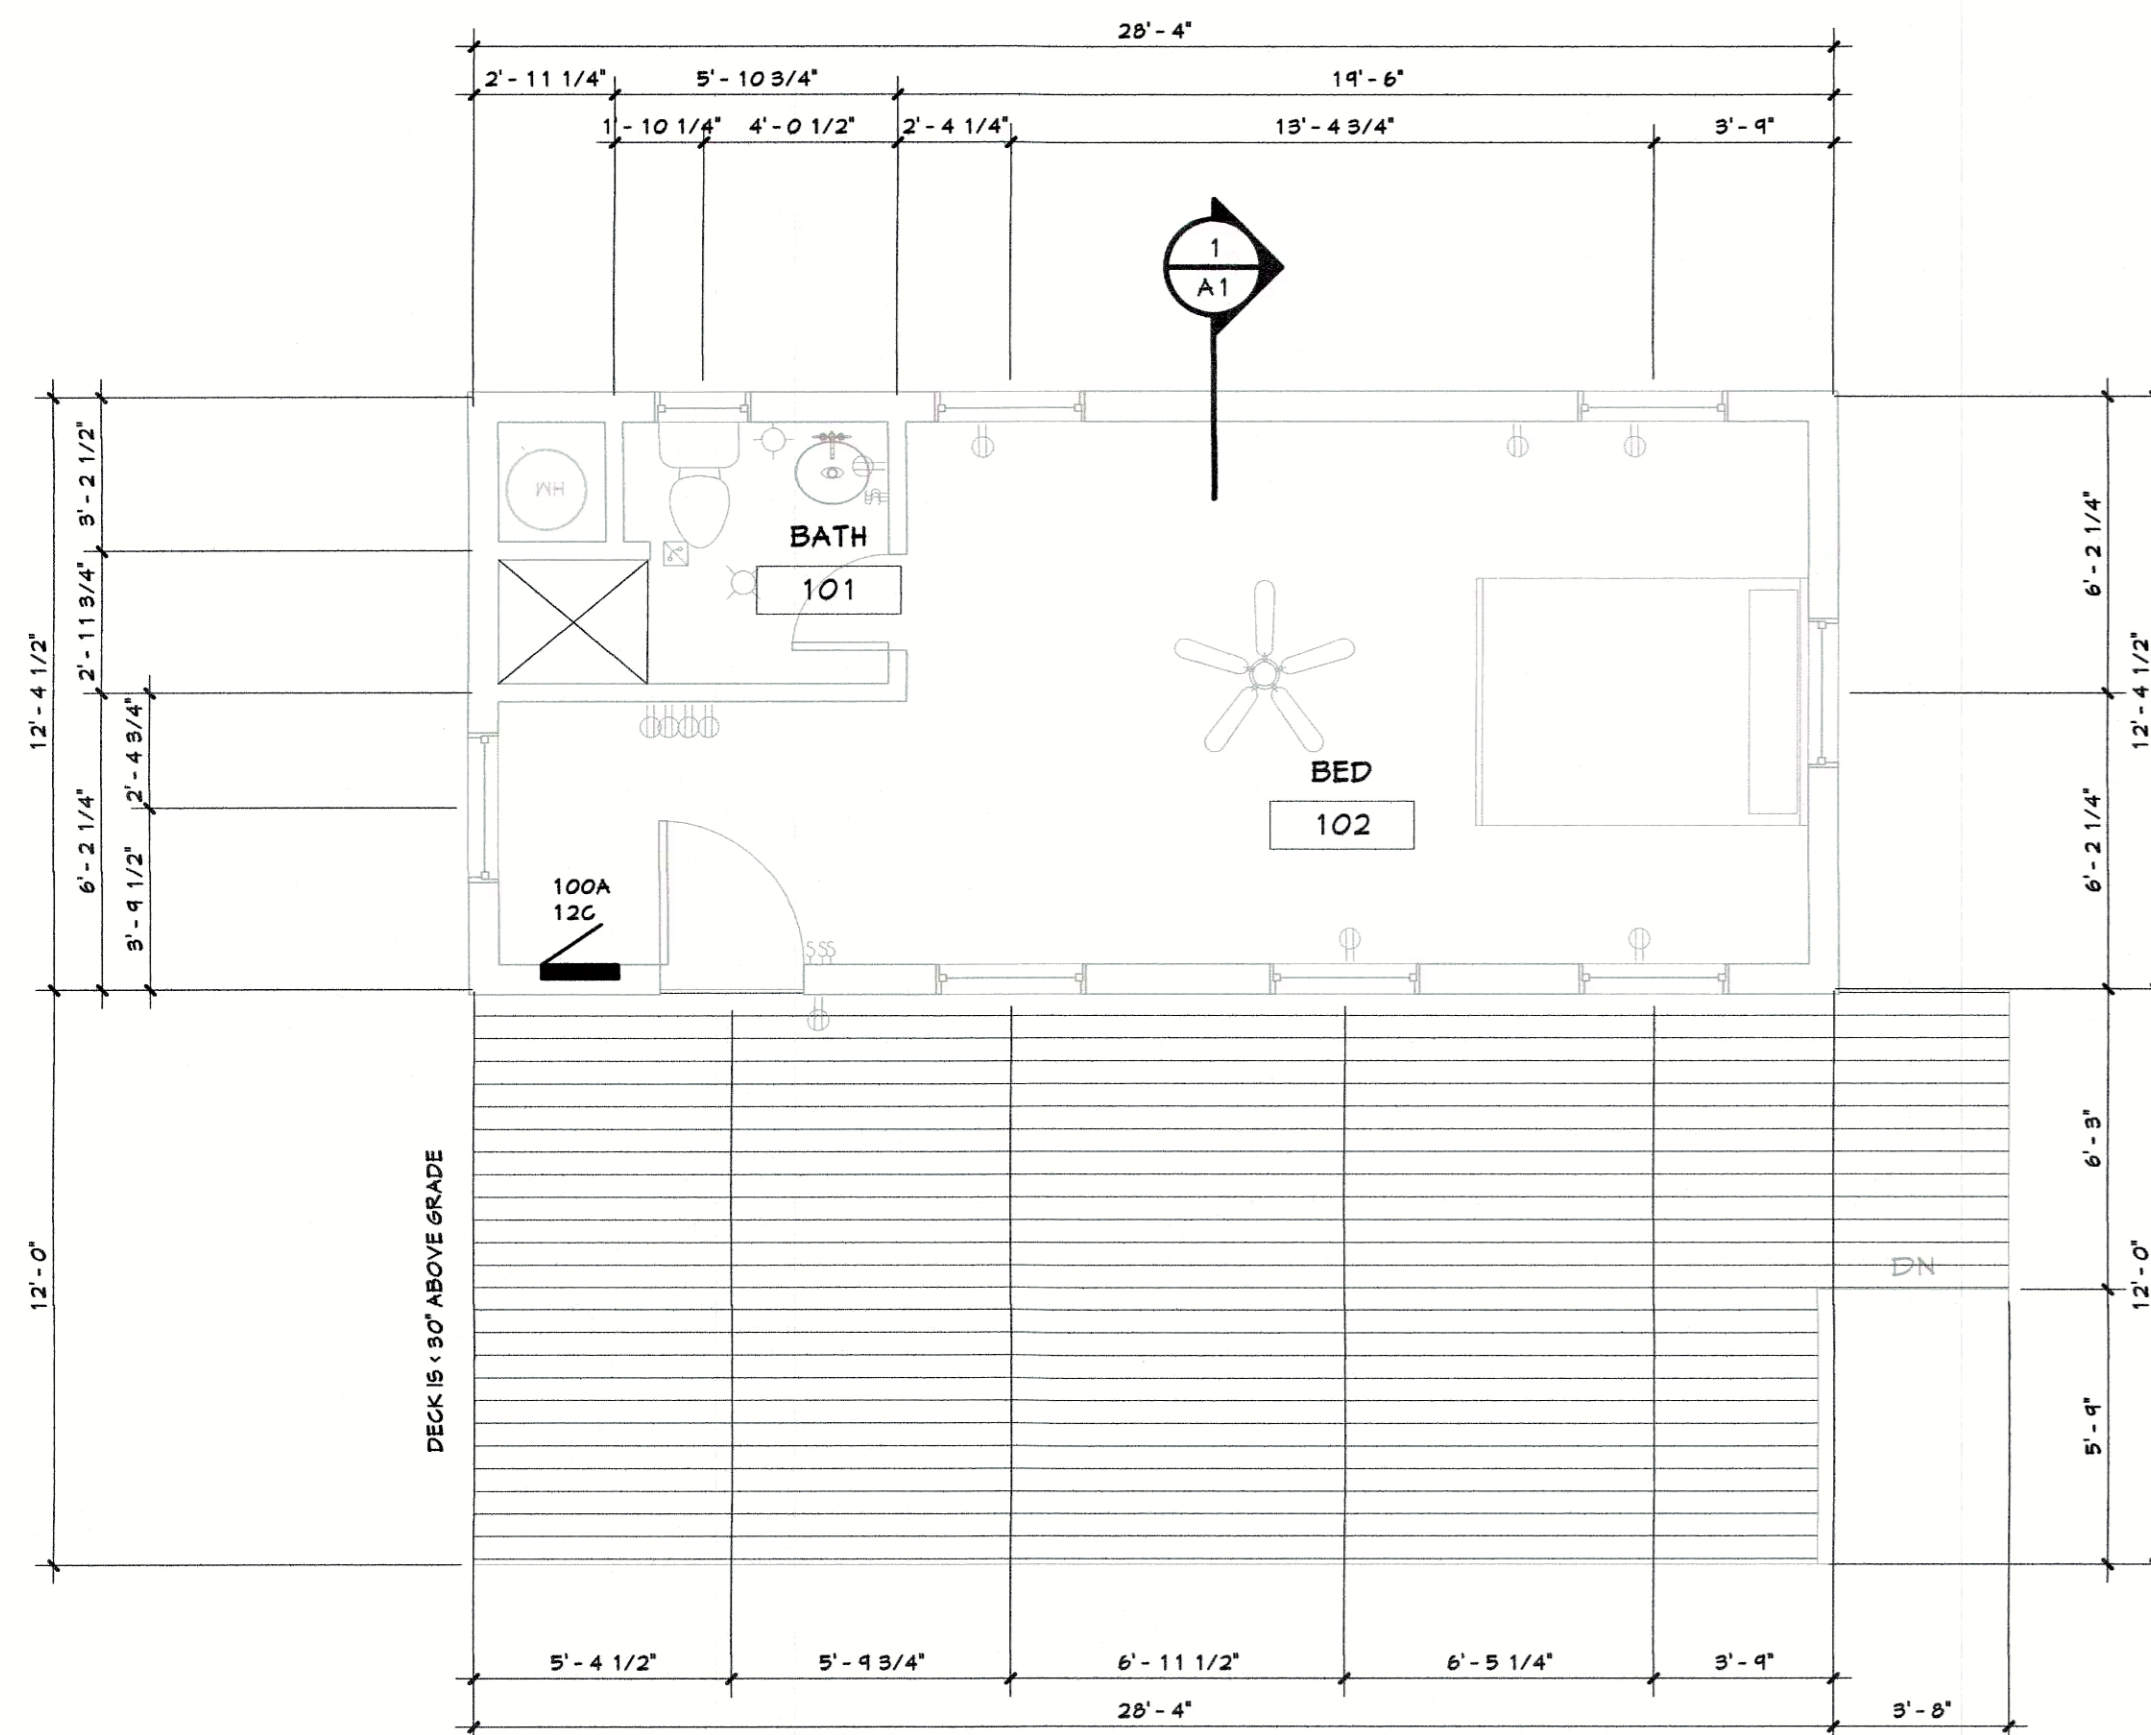


4 MAIN LEVEL FLOOR PLAN
1/4" = 1'-0"

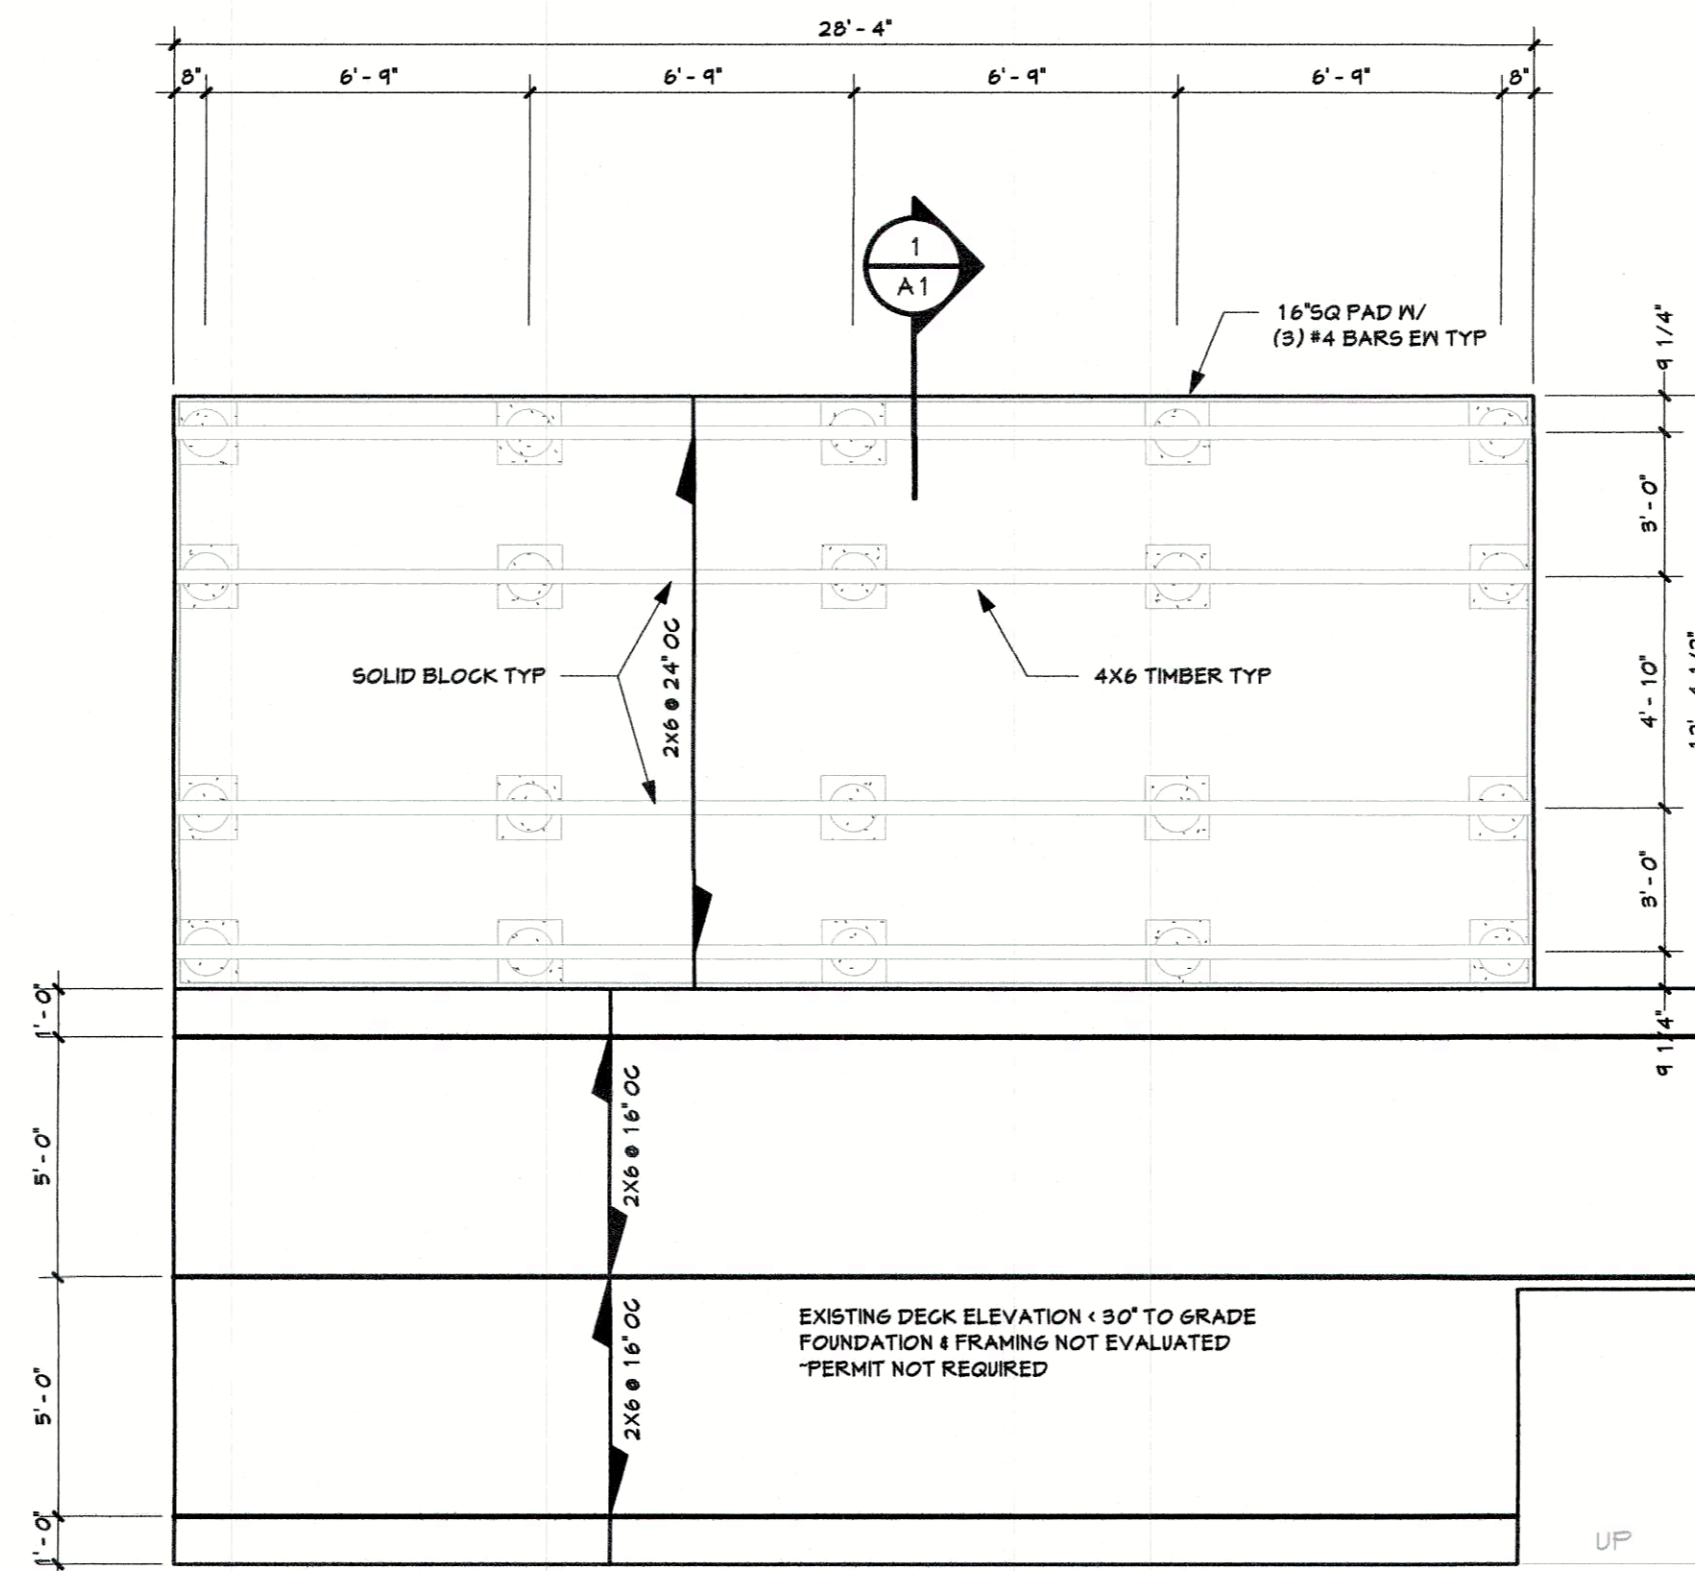

2 FOUNDATION & FRAMING PLAN
1/4" = 1'-0"

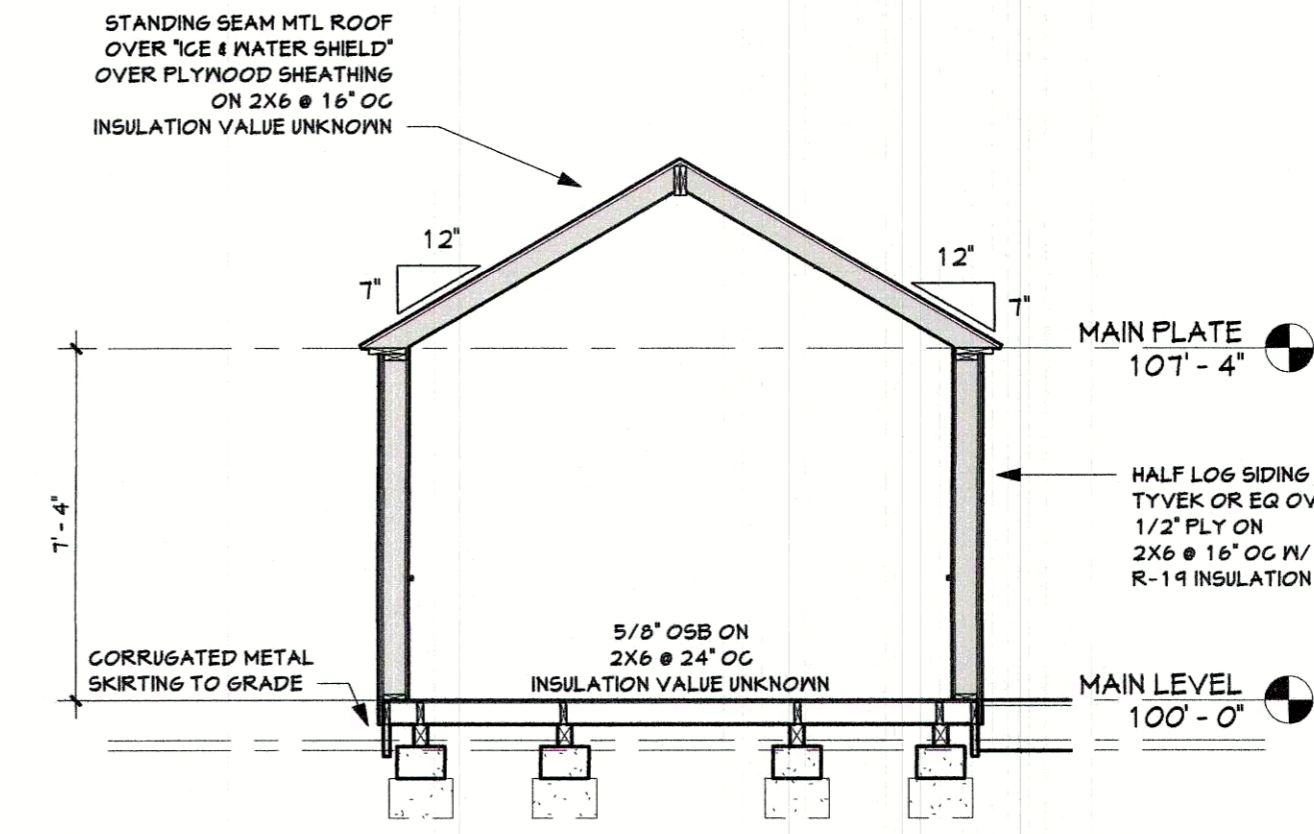

1 EXISTING CONDITIONS SECTION
1/4" = 1'-0"

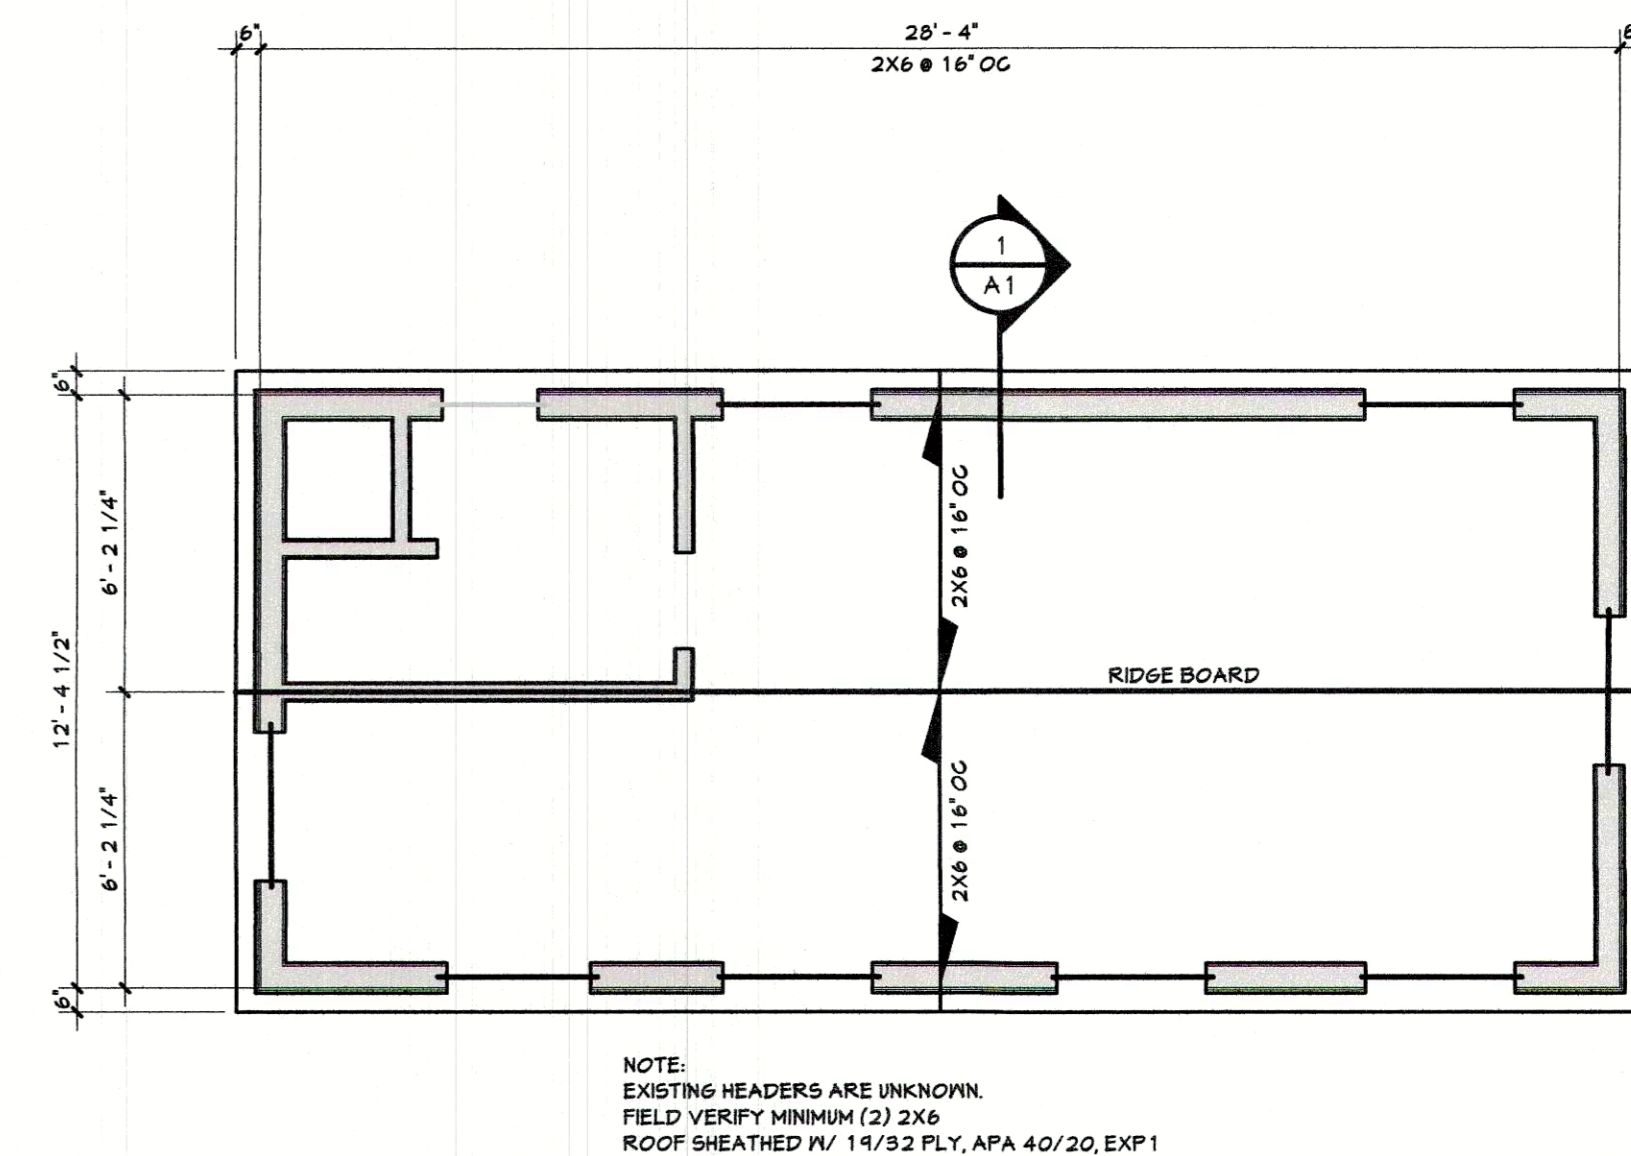

8 ROOF FRAMING PLAN
1/4" = 1'-0"



RCRBD
RECORD SET




AS BUILT FLOOR PLANS, ELEVATIONS & SECTION FOR
DWAYNE M OSADCHUK TRUST, C1
28850 TOBIANO TRL
ROUTT COUNTY CO
OWNER/ CONTRACTOR 946-5592

Job # 17.050
File 17.050A10
Date 2NOV17
Drawn KAB
Checked JMH
Reid 2NOV17
Rev'd


Sheet Number
A 1
SHEET 2 OF 3

Jake's
CELEBRATING 30 YEARS
IN BUSINESS 1987-2017


DRAFTING SERVICE INC.
P.O. BOX 774121
426 OAK STREET
STEAMBOAT SPRINGS, COLORADO
970.879.7929
FAX 970.879.8709
JAKES@SPRINGSIPS.COM

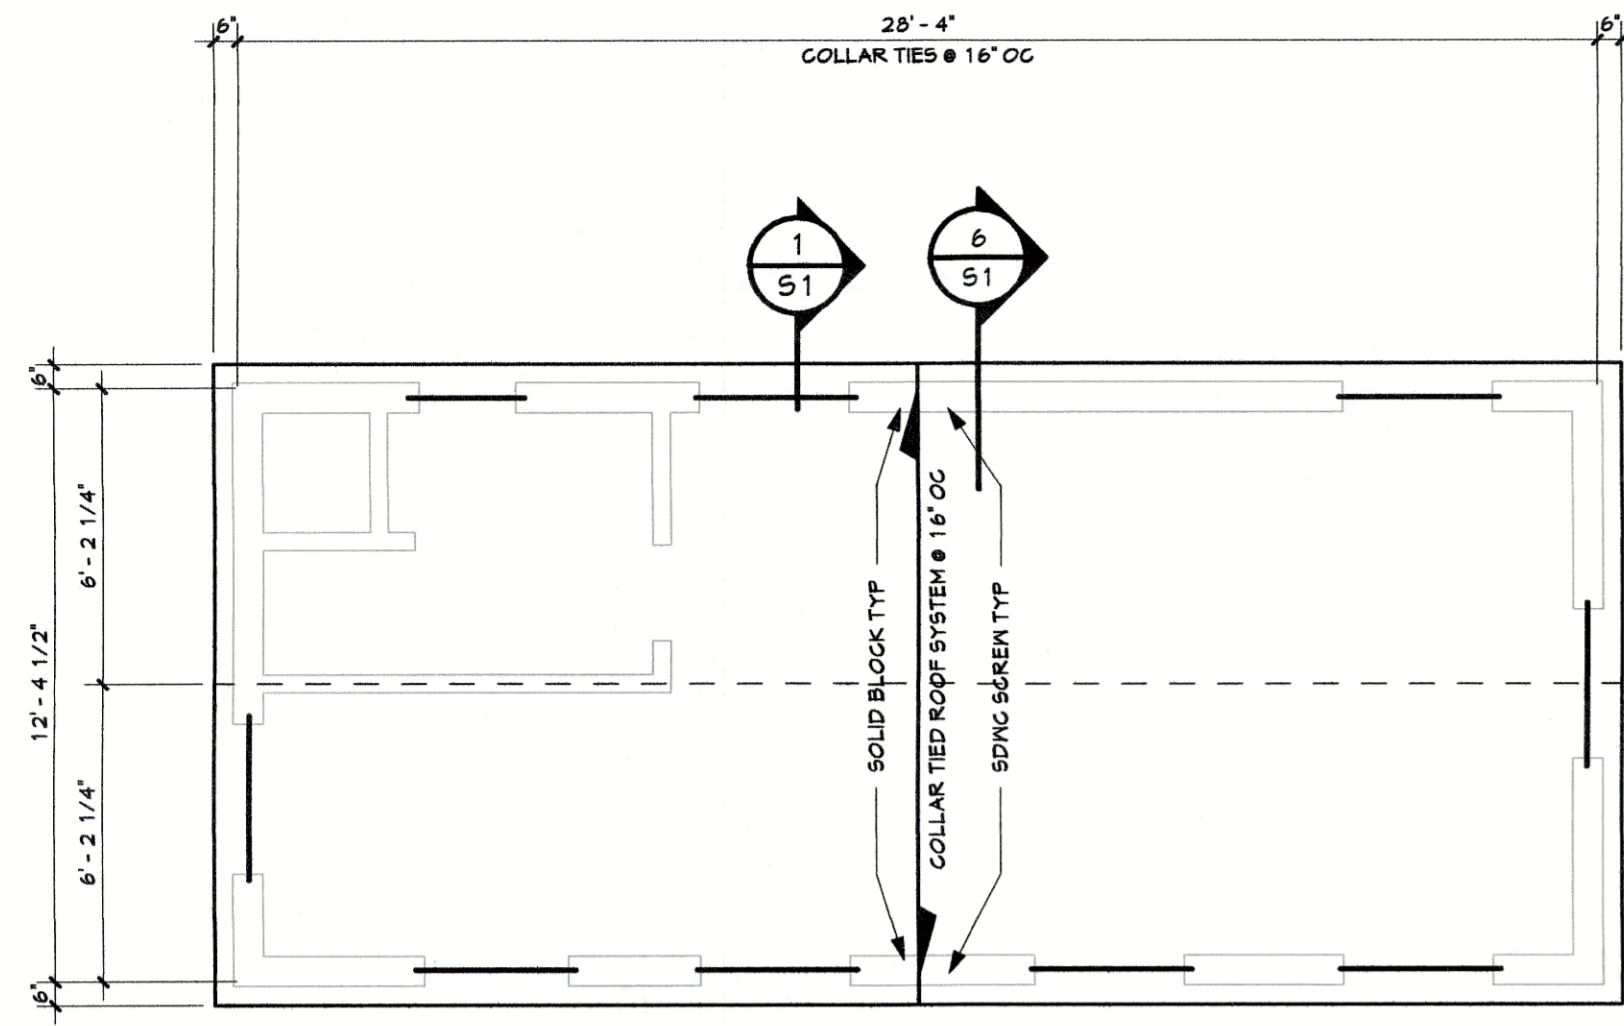

5 ROOF FRAMING PLAN REPAIR
1/4" = 1'-0"

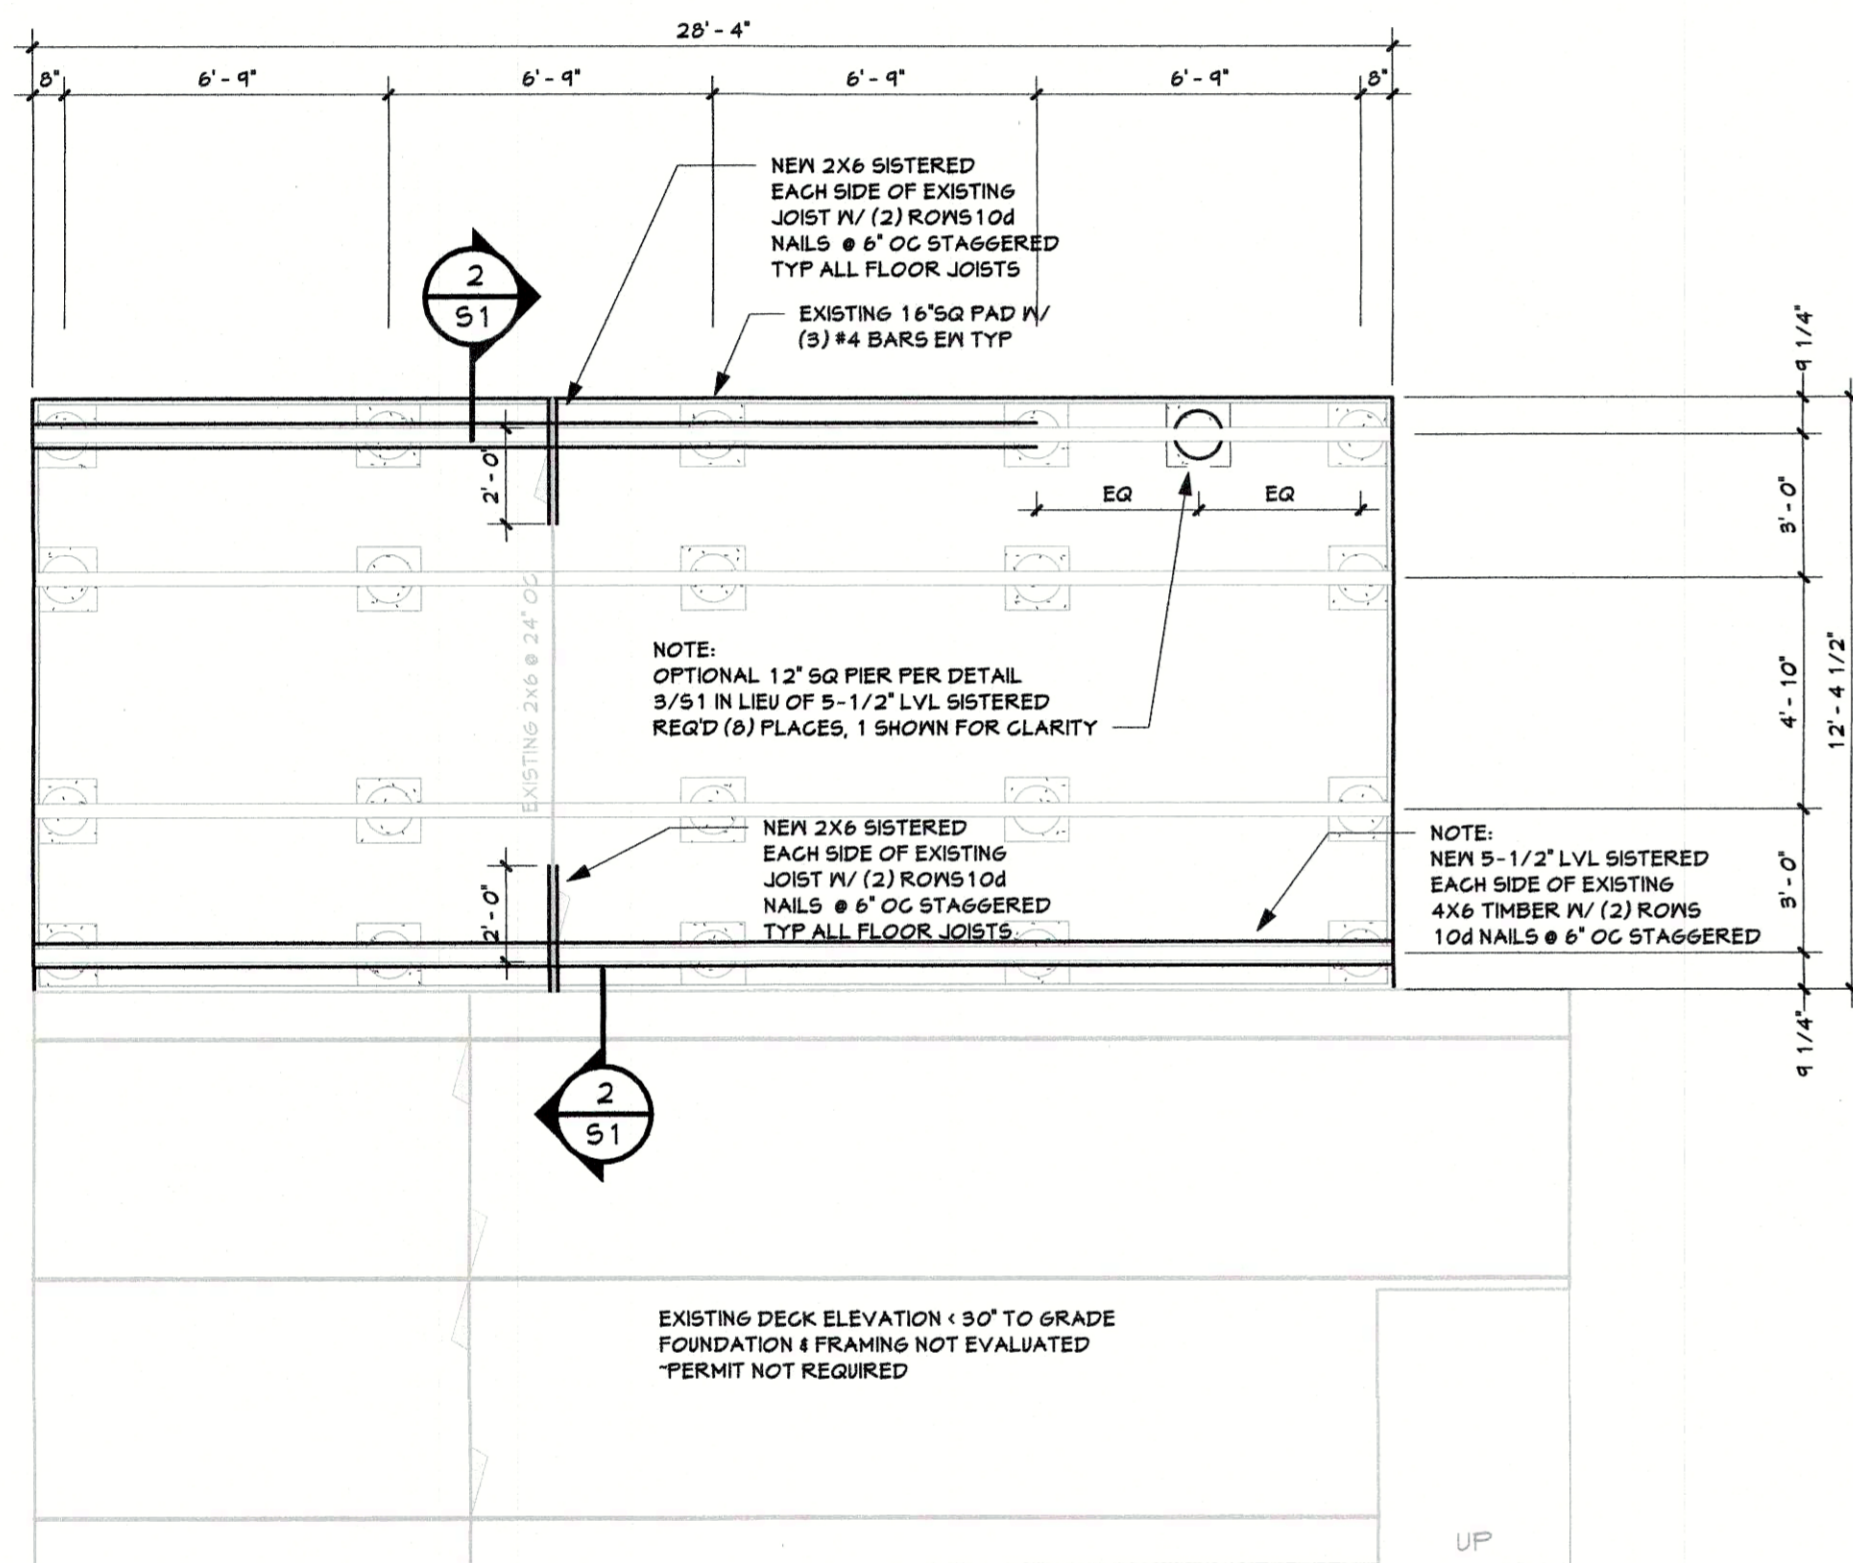

4 FOUNDATION & FRAMING REPAIR PLAN
1/4" = 1'-0"

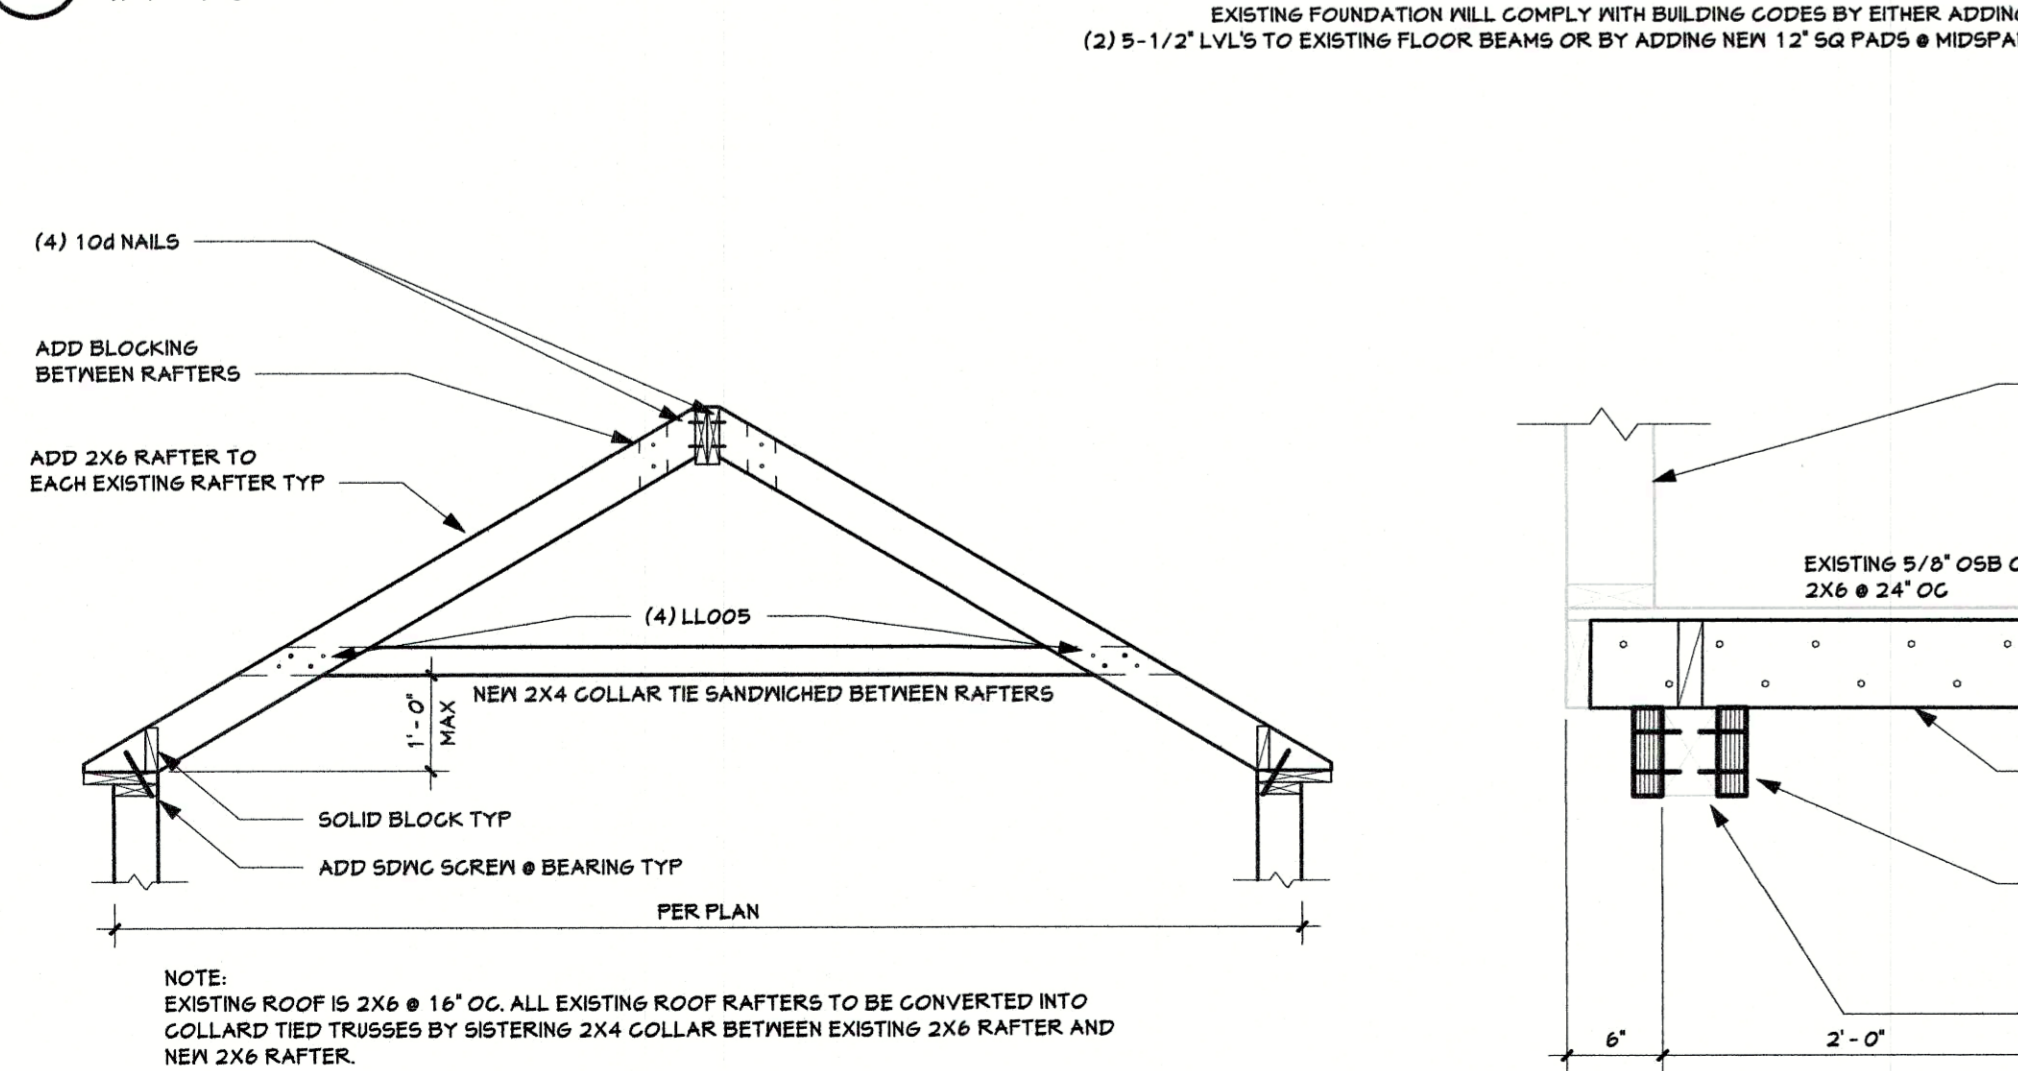

1 COLLAR TIE DETAIL
1/2" = 1'-0"

2 RIM DETAIL
1" = 1'-0"

3 OPTIONAL PAD DESIGN
1" = 1'-0"

6 NEW TYP SECTION
1/4" = 1'-0"

RCRBD
RECORD SET

DRAFTING SERVICE, INC.
P.O. BOX 174121
426 OAK STREET
STEAMBOAT SPRINGS, COLORADO
970.874.1989
FAX 970.874.8709
JAKES@SPRINGSIFS.COM

Jake's
CELEBRATING 30 YEARS
IN BUSINESS 1987-2017

COLORADO LICENSED
PROFESSIONAL ENGINEER
STRUCTURE ONLY

REPAIR DETAILS & SPECIFICATIONS
DWAYNE MOSADCHUK TRUST, C1
28850 TOBIANO TRL
ROUTT COUNTY CO
OWNER/ CONTRACTOR 946-5592

Job # 17.050
File 17.050510
Date 2NOV17
Drawn KAB
Checked JMH
Rev'd 2NOV17

Sheet Number
S1
SHEET 3 OF 3