


FOUNDATION PLAN  
1/4" = 1'-0"  
100'-0" = USGS 7651.56'

- FOUNDATION PLATE NOTES:
- SEE S0.01 FOR GENERAL STRUCTURAL NOTES
  - SEE S6.01 FOR FOOTING SCHEDULE
  - FOUNDATION DESIGN BASED ON 2500 PSF ALLOWABLE BEARING PRESSURE, 750 PSF DEAD LOAD ALLOWABLE BEARING PRESSURE
  - CONCRETE GRADE WALL (UNO), 8" THICK CONCRETE WALL REINFORCED WITH #5 HORIZONTAL @ 18" UNO CENTERED IN WALL, #5 VERTICALS AT 18". ALSO INSTALL (2) #5X TOP AND BOTTOM. SEE 1/SS.01
  - GARAGE CONCRETE SLAB ON GRADE (WWF), 4" THICK CONCRETE SLAB ON PREPARED SUB-GRADE PER SOILS REPORT. REINFORCE WITH 4M - W2.9 x W2.9 WWF PLACED AT MID-DEPTH, SAWCUT OR TOOLED 18"x1" CONTROL JOINTS @ 10'-0" MAX EACH WAY. INSTALL (3) #4 x 5-0" DIAGONAL BARS AT MID-DEPTH OF SLAB AT ALL RE-ENTRANT CORNERS. SLOPE SLAB PER ARCHITECTURAL DRAWINGS
  - HX HOLDOWN, INDICATES HOLDOWN LOCATED AT TOP OF WALL BELOW BOTTOM OF WALL ABOVE. FOR MINIMUM END STUD REQUIREMENTS SEE S6.01

| FOUNDATION PLAN HEX NOTES |                                                                                                                                                        |
|---------------------------|--------------------------------------------------------------------------------------------------------------------------------------------------------|
| (X)                       | DESCRIPTION                                                                                                                                            |
| 1                         | 4'-0" WIDE x 3'-0" TALL OPENING IN CONC WALL. PROVIDE (2) #5 BARS OVER OPENING                                                                         |
| 2                         | EMBED PLATE PER S5.03                                                                                                                                  |
| 3                         | BEAM COLUMN BASE PLATE DIRECTLY ON LVL BEAM. PACK OUT BEAM POCKET SOLID WITH LVL MATERIAL. CONNECT BASE PLATE TO LVL BEAM W/ (4) 1/4"x3/4"x1/2" SCREWS |

RCRBD  
Record Set

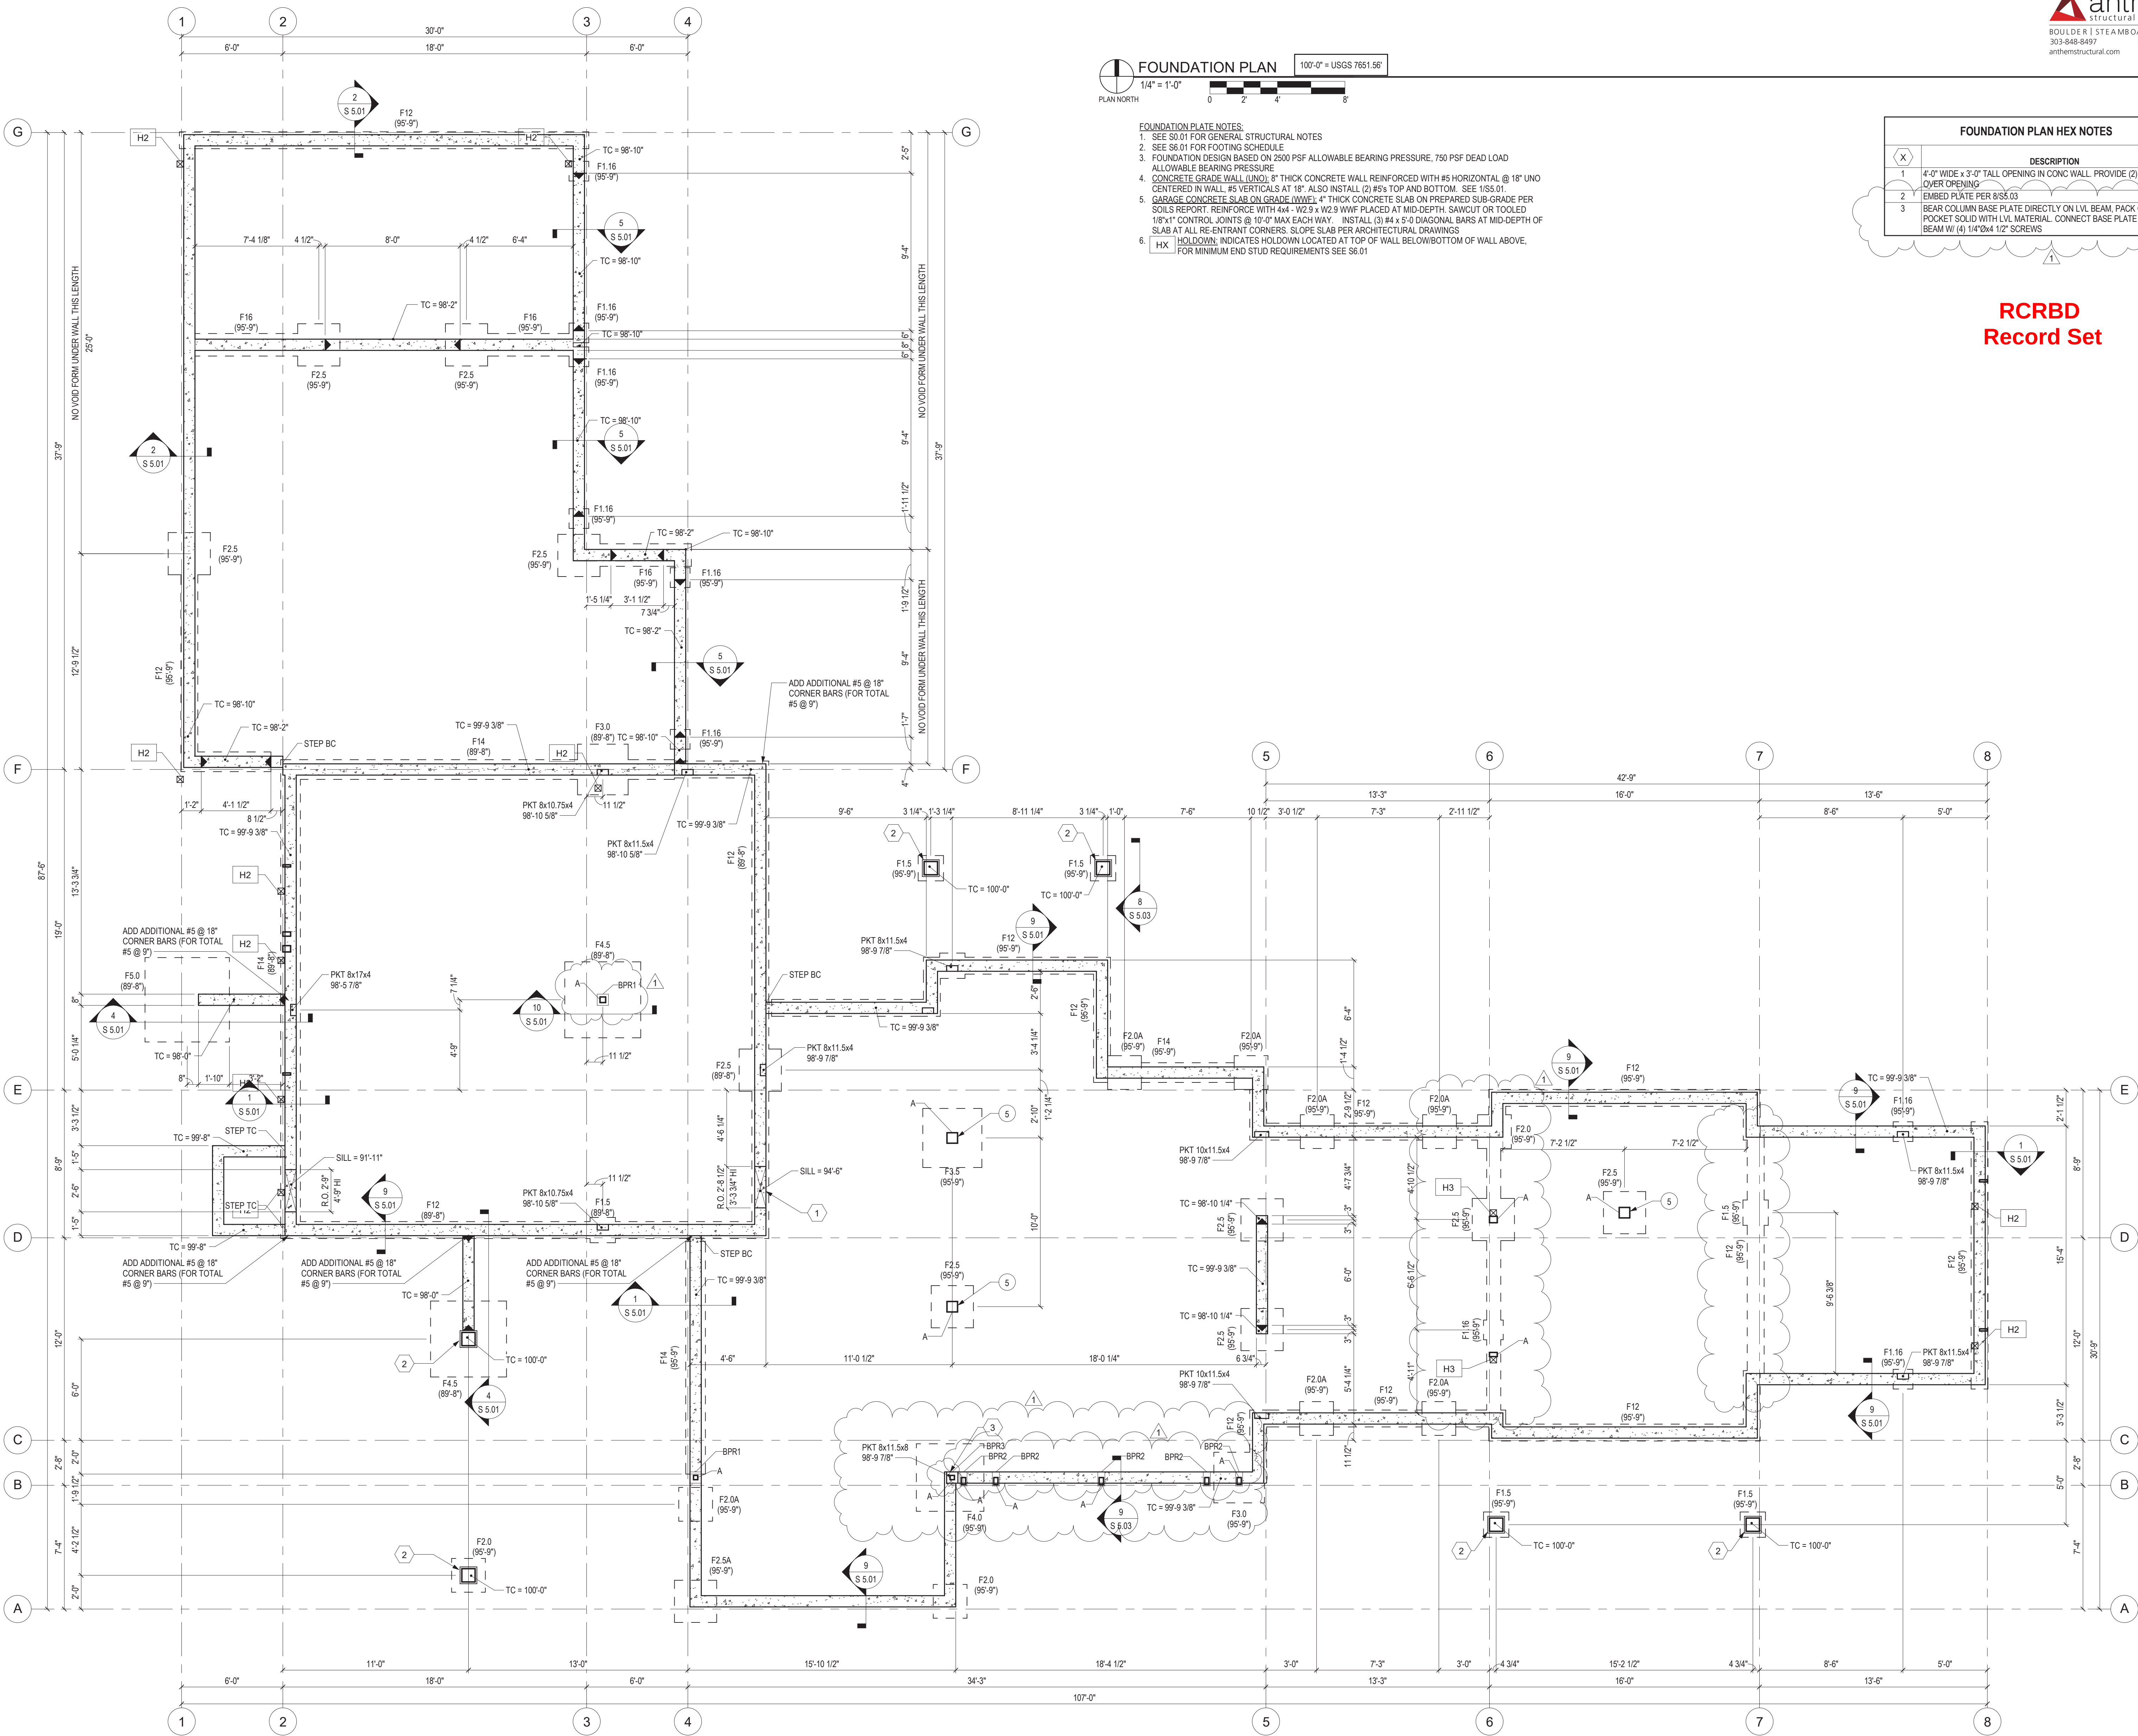

JANES RESIDENCE  
55950 HANNAHS WAY  
CLARK, CO 80428  
#1816

| ISSUE NAME       | DATE     |
|------------------|----------|
| CONSTRUCTION SET | 10.14.19 |
|                  |          |
|                  |          |
DRAWING TITLE  
FOUNDATION PLAN

SHEET NO.

S 1.01

10/14/2019 4:05:47 PM



