

NOTE: BUILDING #1 BASED UPON INVESTIGATION OF UPPER LEFT CORNER FOUNDATION INVESTIGATION OF BUILDING #2. FRAMING BASED UPON OPEN CEILING INVESTIGATION BUILDING #1.

ROOF FRAMING PLAN



FOUNDATION AND ML FRAMING PLAN

1
A2.1

SCALE 1/4" = 1'-0"

BUILDING "#1"

SCALE 1/4" = 1'-0"

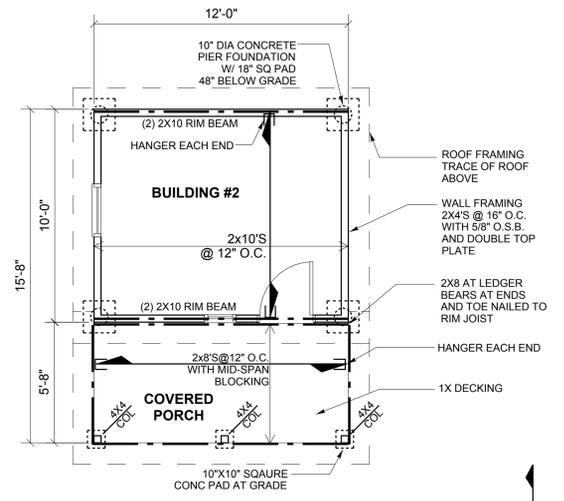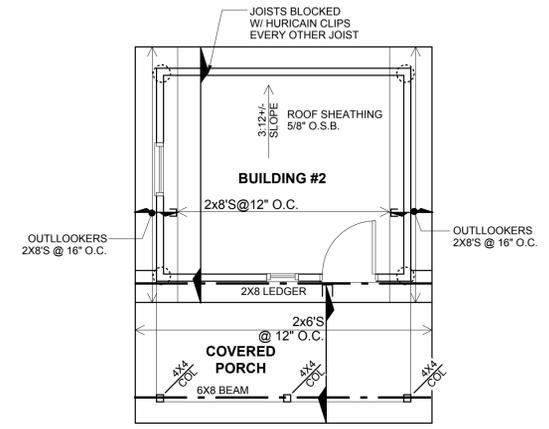

NOTE: BUILDING #2 BASED UPON INVESTIGATION OF UPPER LEFT CORNER FOUNDATION INVESTIGATION. FRAMING BASED UPON BUILDING #1 OPEN CEILING INVESTIGATION.



ROOF FRAMING PLAN

FOUNDATION AND ML FRAMING PLAN

2
A2.1

SCALE 1/4" = 1'-0"

BUILDING "#2"

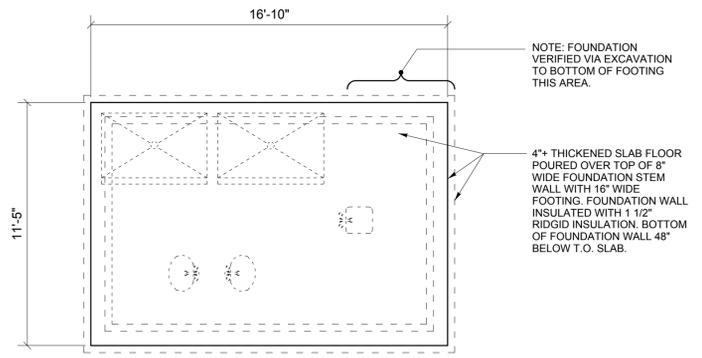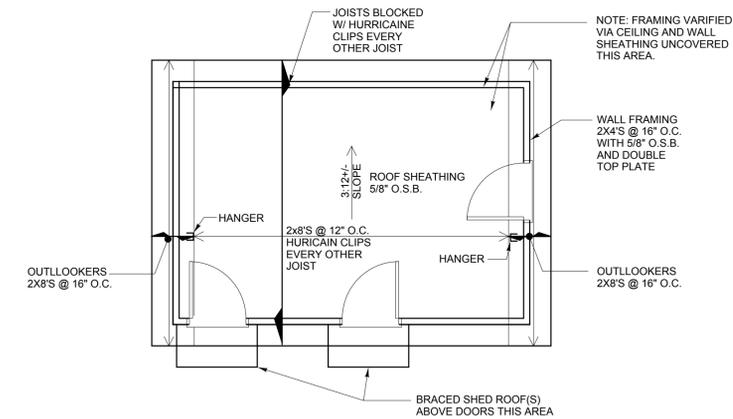

ROOF FRAMING PLAN

FOUNDATION PLAN

3
A2.1

SCALE 1/4" = 1'-0"

BUILDING "#3"

THESE DRAWINGS DO NOT CONTAIN THE ELEMENTS FOR CONSTRUCTION SAFETY

© Copyright 2022 Michael J.K. Olsen, Architects P.C. All Rights Reserved
This document, the ideas and designs incorporated herein, as an instrument of professional service, is the property of Michael J.K. Olsen, Architects P.C. and is not to be used, in whole or in part, for any other project without written authorization of Michael Olsen.

THREE STORAGE BUILDINGS FOR THE
CHRISTENSEN RESIDENCE
38625 ROLLING HILLS LANE
PT OF NW4NE4, PT OF SW4NE4 SEC 17-6-85
ROUTT COUNTY, COLORADO
PIN # 937174003

REVIEWED FOR CODE COMPLIANCE 06/07/2023



MICHAEL J.K. OLSEN ARCHITECTS

1169 HILLTOP PKWY, SUITE #203B
P.O. BOX 772385, SPRING, CO 80477
PHONE: 970-870-1584 FAX: 970-871-0217
mjo@mjoarch.com

ISSUES:
NOVEMBER 10, 2022
RCRBD
AS-BUILT STRUCTURAL ADDED TO DRAWING SET

SHEET TITLE:
BUILDINGS #1, #2, & #3
AS-BUILT STRUCTURAL
PLAN INVESTIGATION

JOB NO. 22-12

SHEET NO.

A2.1